


John

WOOD BOCKLEY BIGELOW
 TRACED


WOOD BOCKLEY BIGELOW
 TRACED

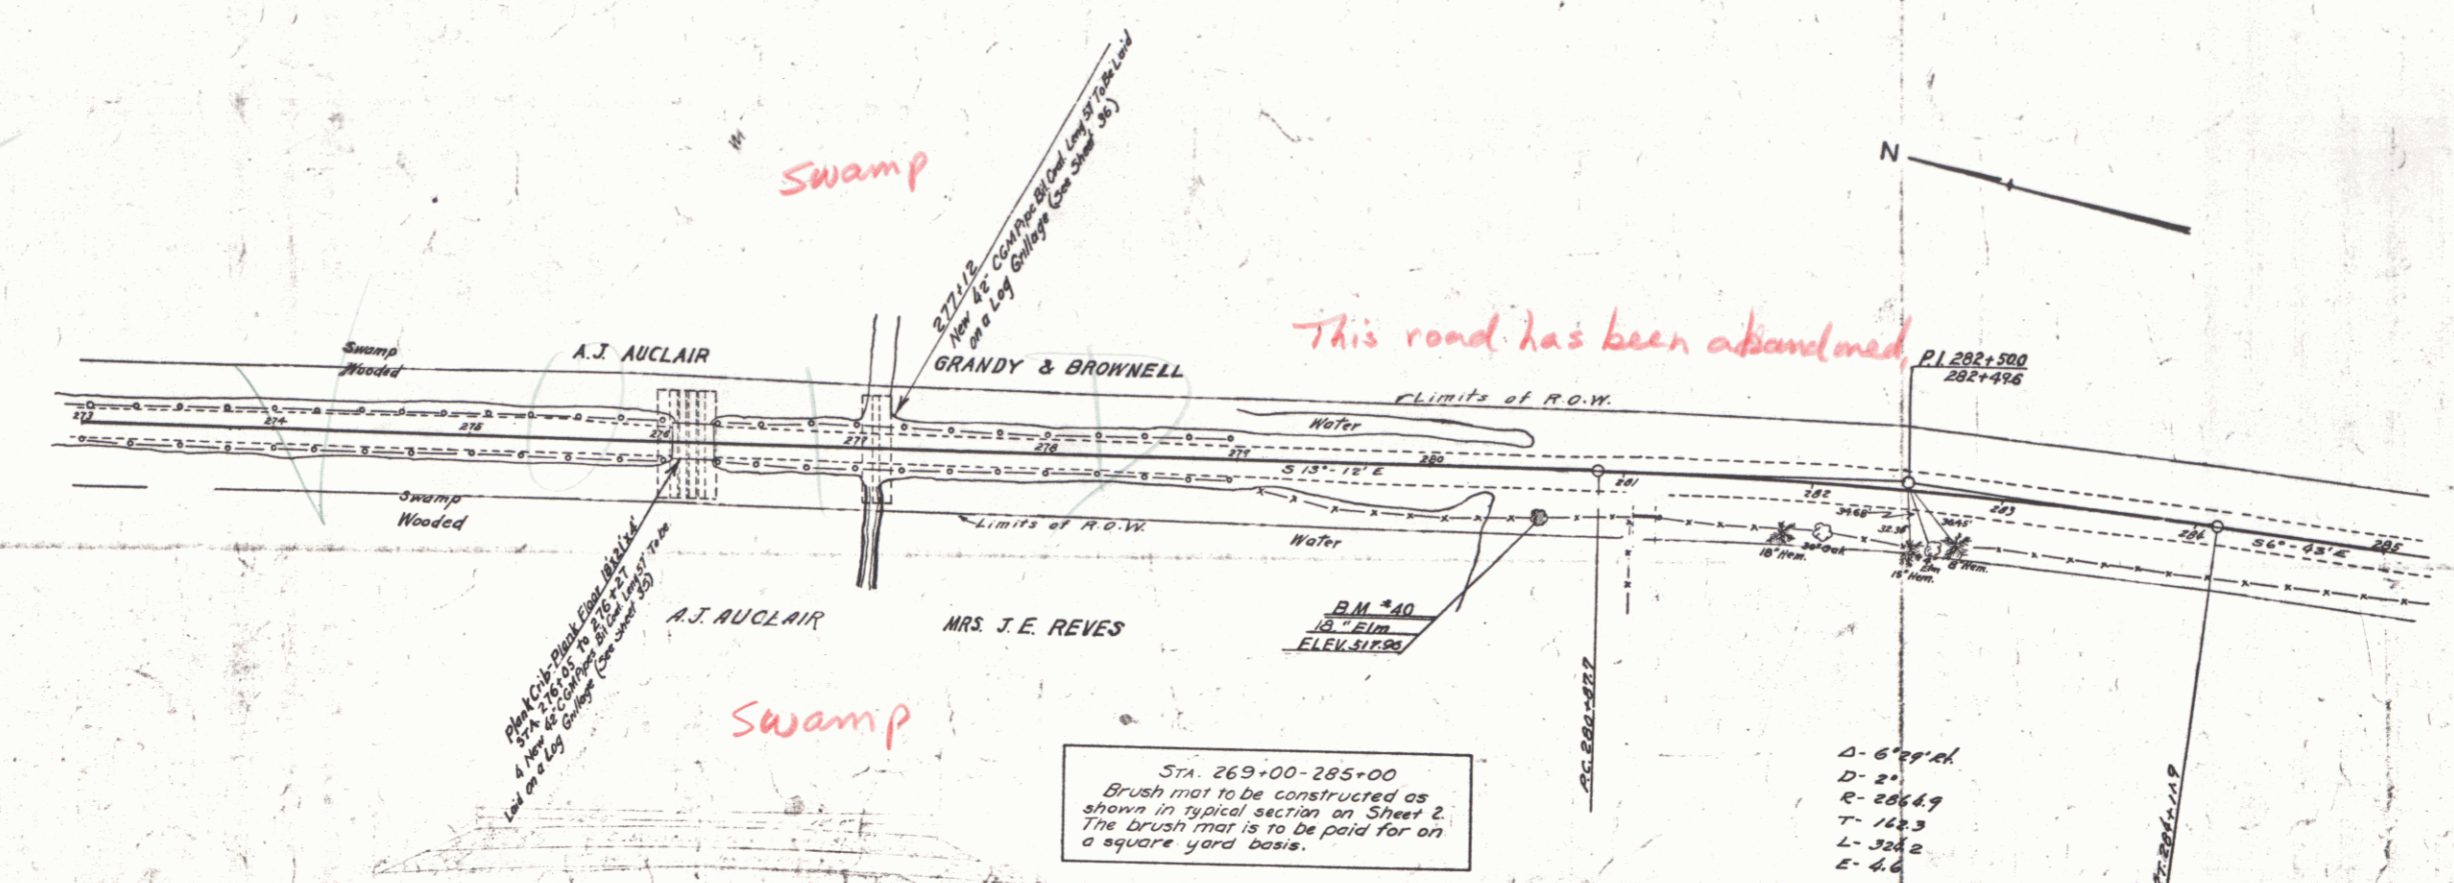

The City of Bogalusa, Louisiana, has a claim on the right of way of this road as shown on the map.

Sta. 269+00-285+00
 Brush mat to be constructed as shown in typical section on Sheet 2. The brush mat is to be paid for on a square yard basis.

D-6' 4" x 4"
 D-2"
 S-26' 4"
 T-14' 3"
 L-30' 2"
 E-4' 6"

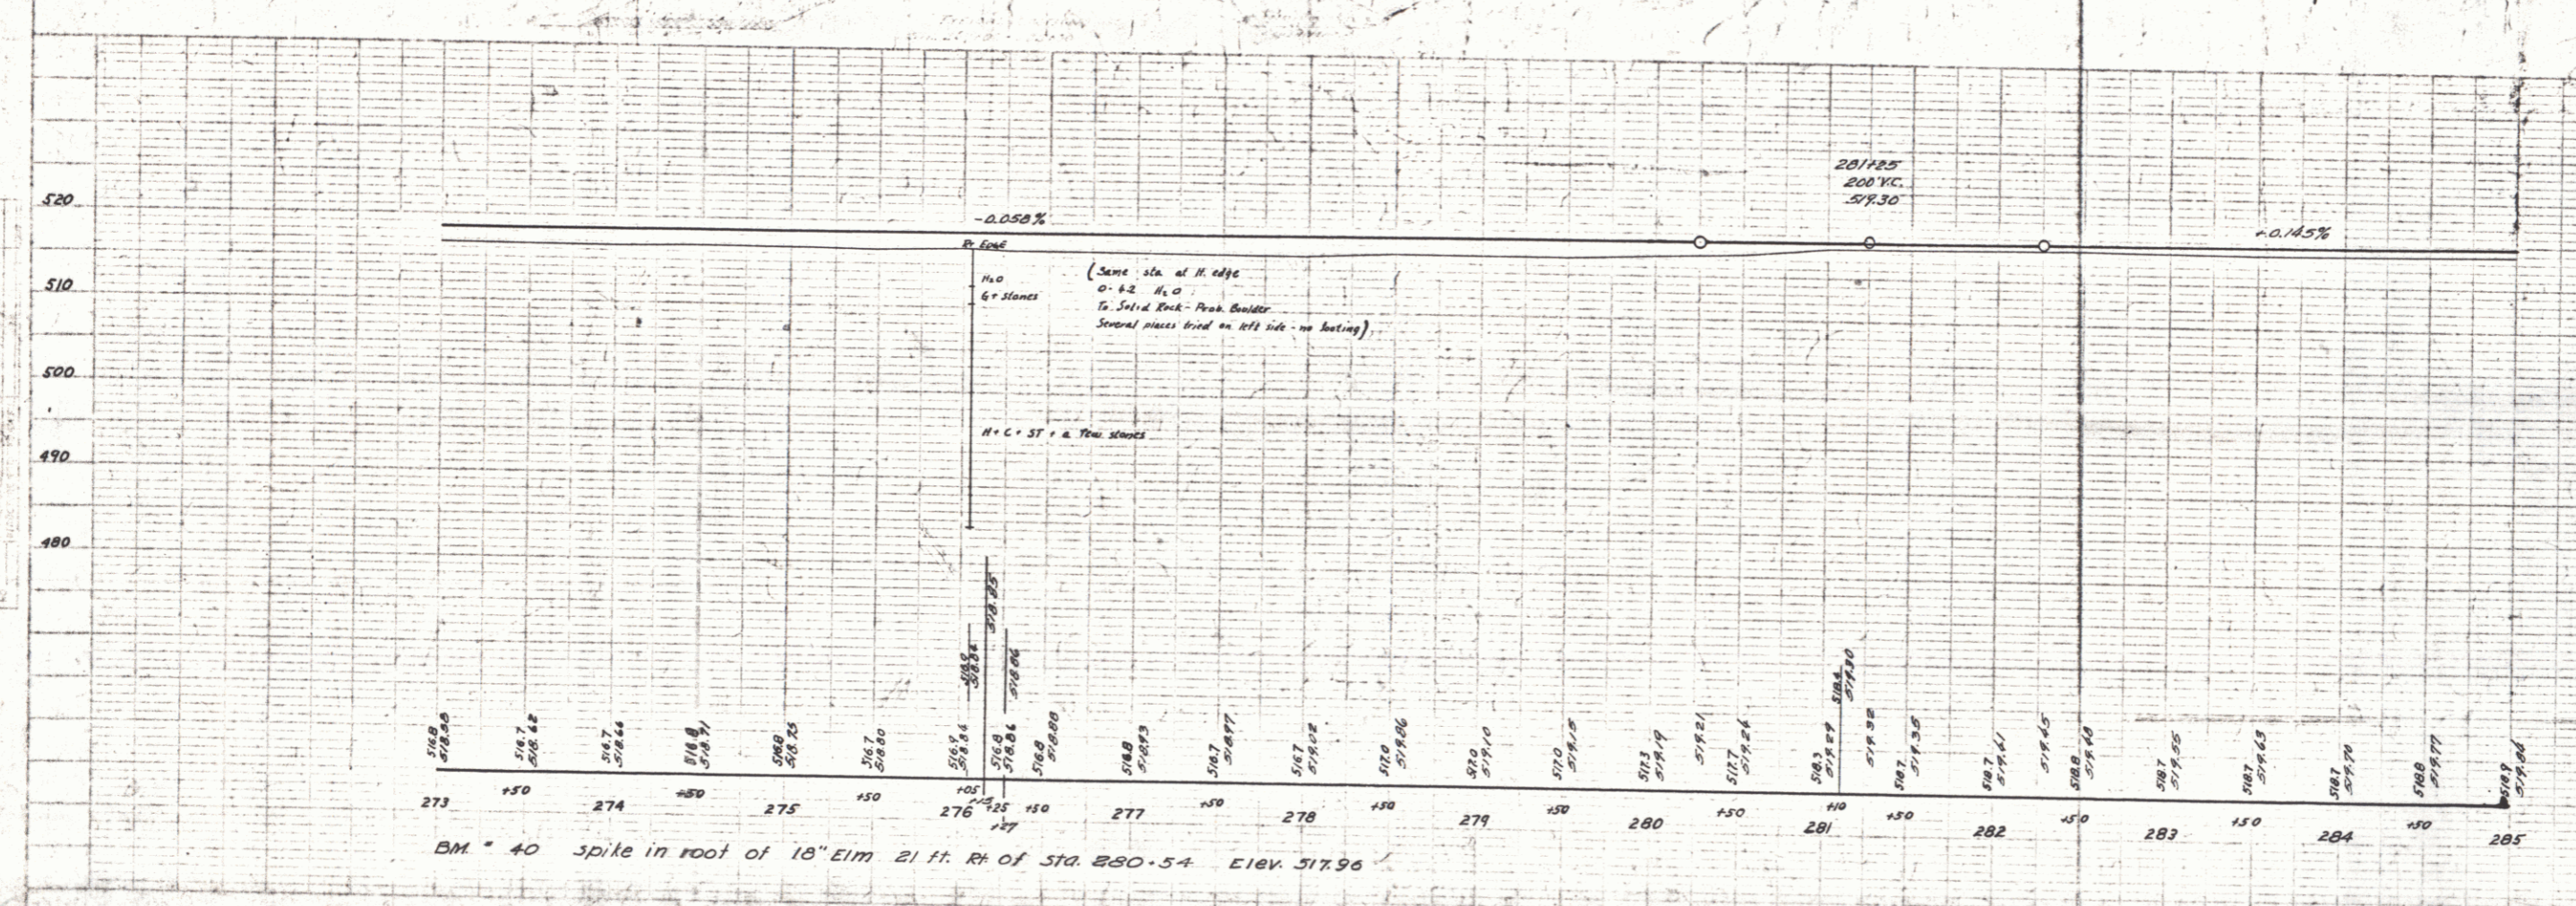

Void
 SERIES 140
 Sheet 22 of 95
 26