
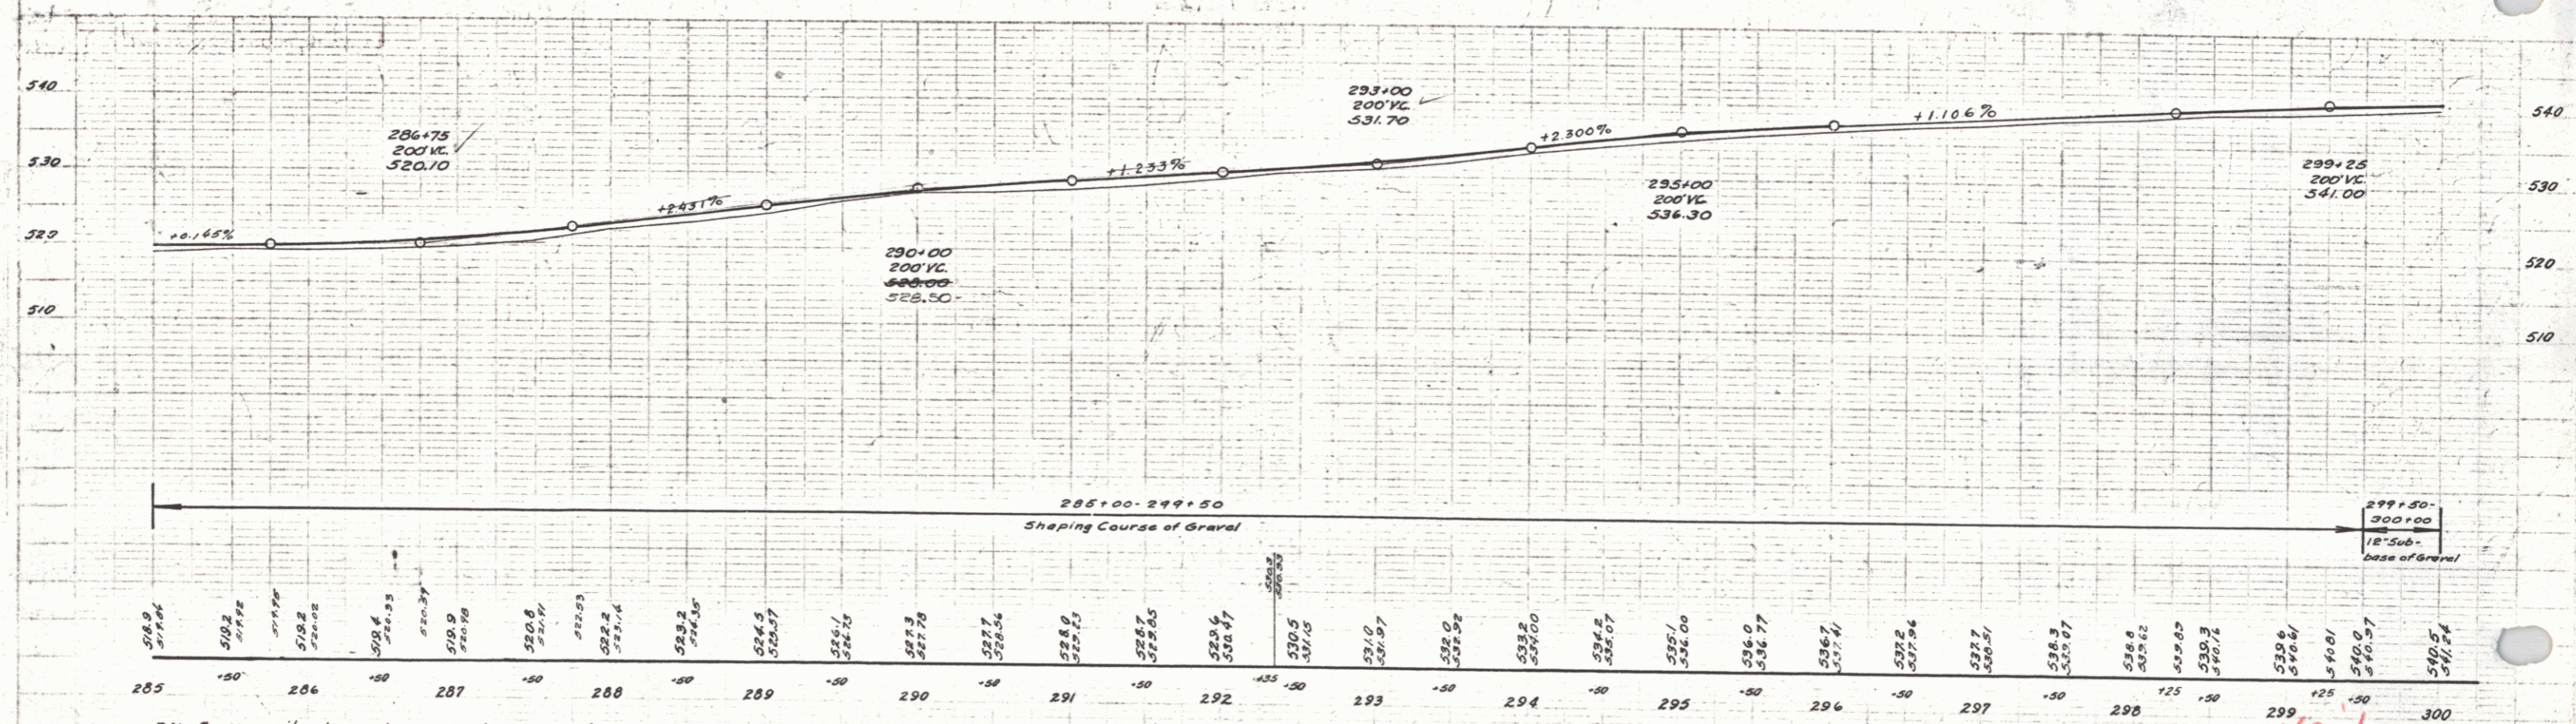


PLAN
 WOOD BUCKLEY
 BUELOW 9140
 TRACED

WOOD 7110

VOID

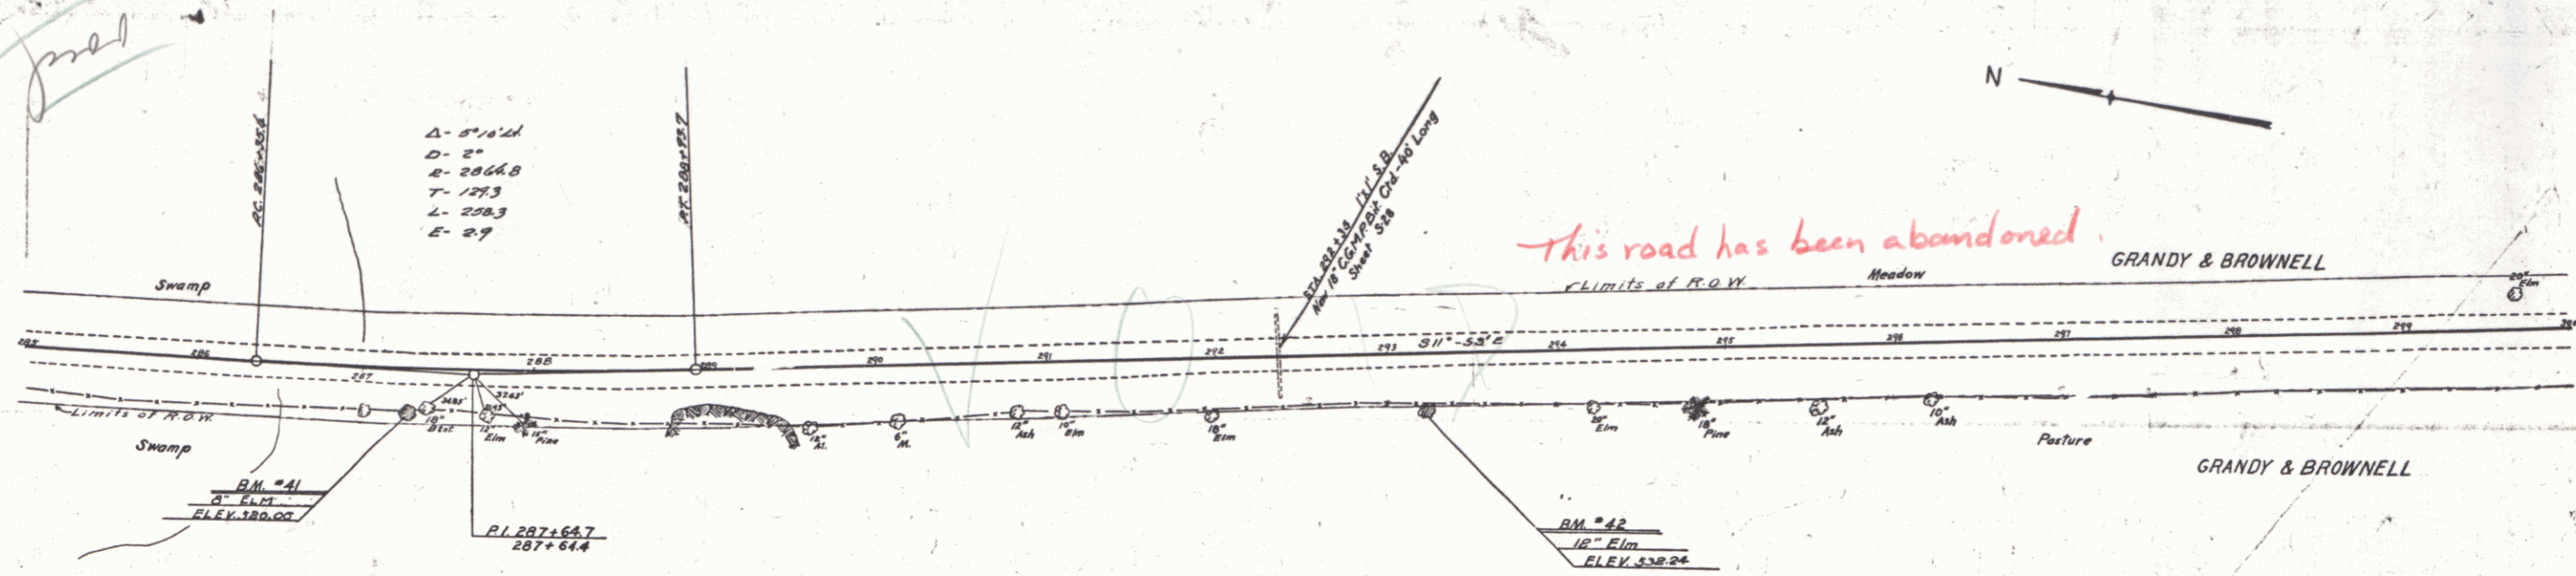

B.M. #41 spike in root of 8" elm 25 ft. rt. of sta 287+25. Elev. 520.00
 B.M. #42 spike in root of 12" elm 31 ft. rt. of sta 293+20. Elev. 532.24

VOID
 SERIES N.R.S. No. 140
 SHEET 23 Nov 30