


Drives
 Station 24+00 Rt.
 Station 25+20 Lt.
 Station 25+00 Rt.

AUCLAIR, ERNEST N. &
 MILDRED K.

END ROW PROJECT
 F 021-1(5) STA. 27+00 @

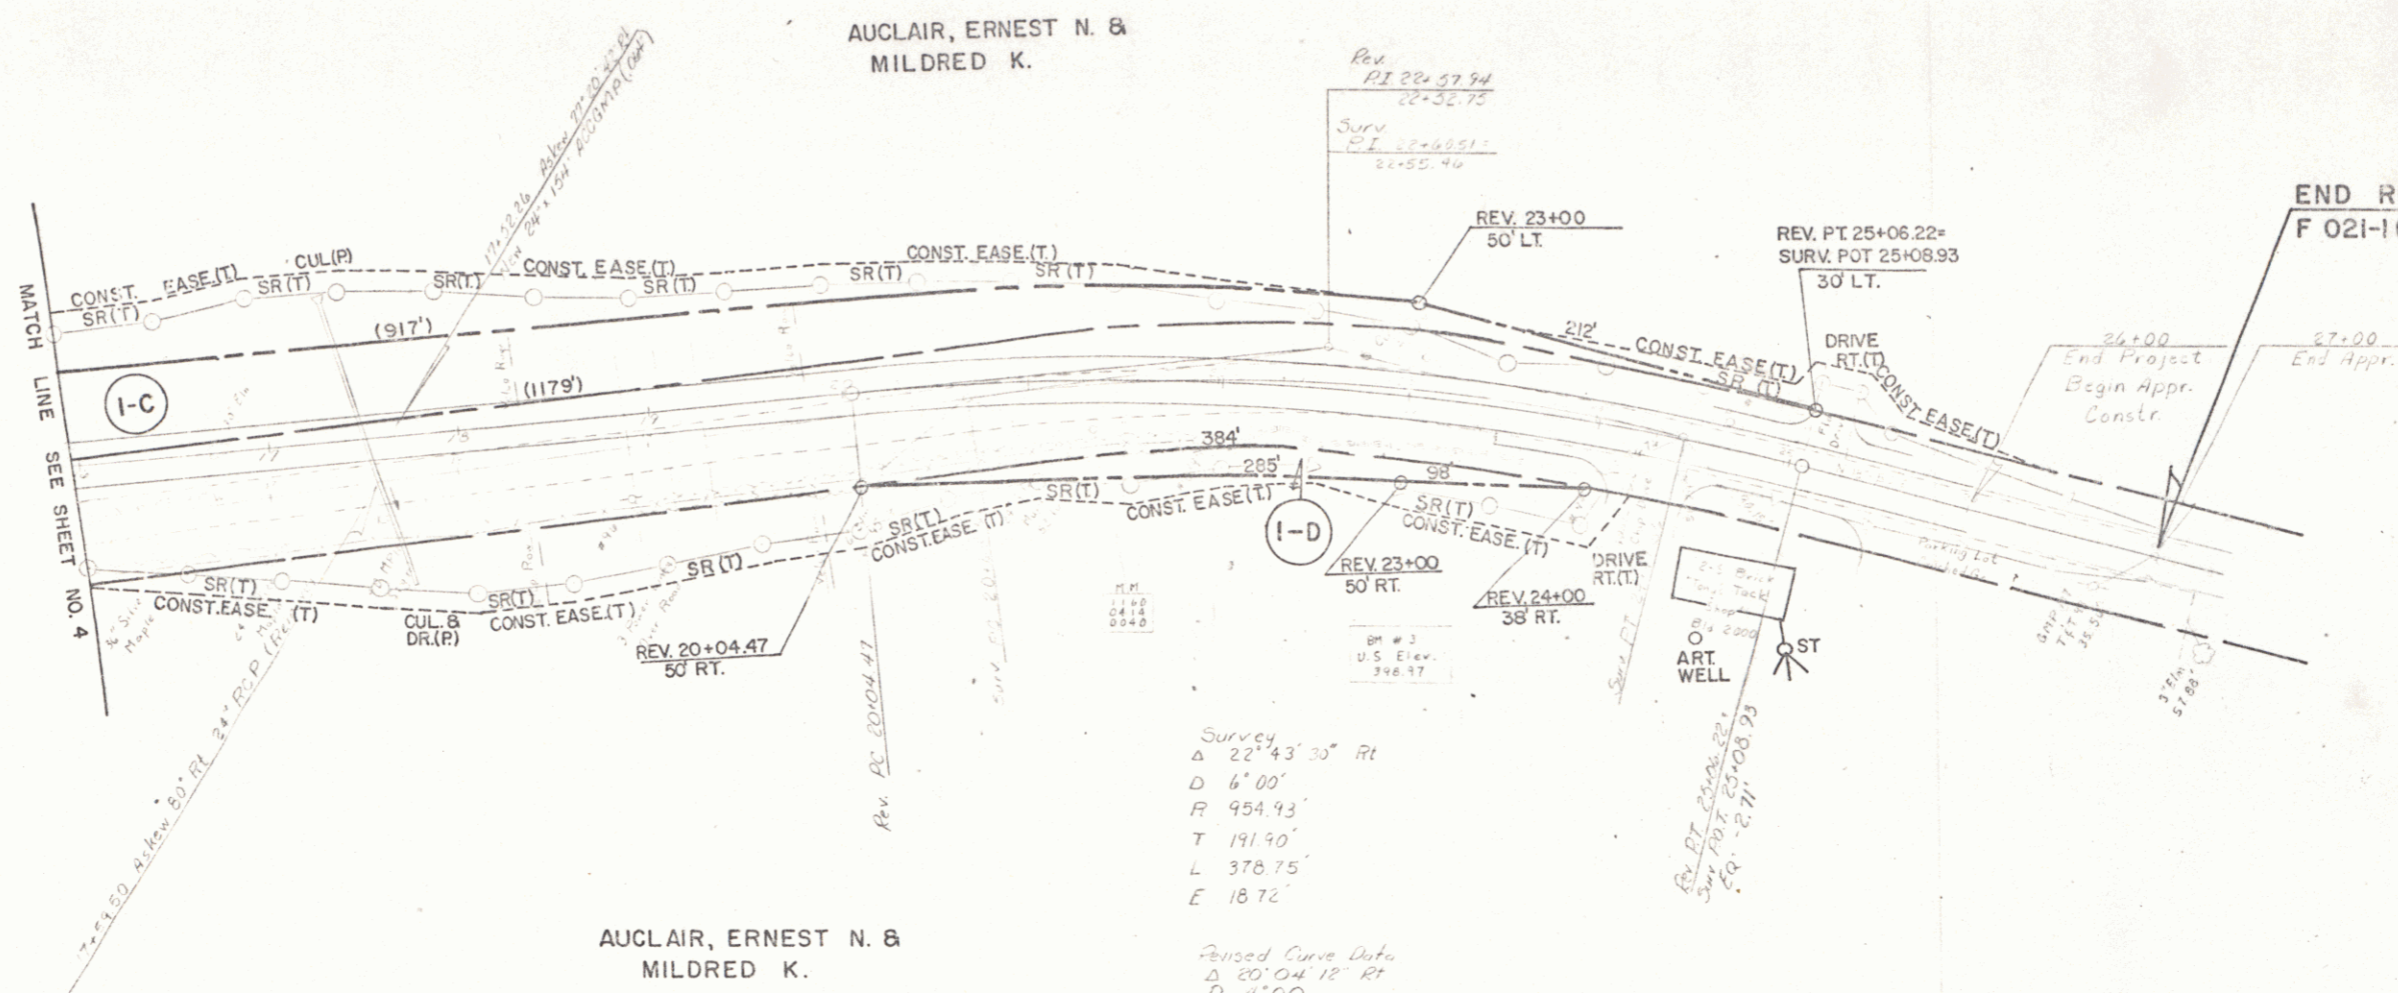


Survey
 Δ 22° 43' 30" Rt
 D 6' 00"
 R 954.93'
 T 191.90'
 L 378.75'
 E 18.72'

Revised Curve Data
 Δ 20° 04' 12" Rt
 D 4' 00"
 R 1432.40'
 T 253.47'
 L 501.75'
 E 23.25'
 Bank 1:6.5:1 Ht

AUCLAIR, ERNEST N. &
 MILDRED K.

DEC 21 1981

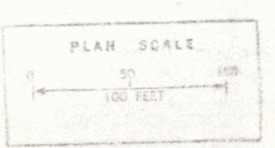

SURVEYED BY	DATE
DRAWN BY	CATS
TRACED BY	DATE
S.W. Burlington	
PROJ	RD 201/75
SHEET 6	OF 5