


MP 4.249
 210+00
 2+72+58.71

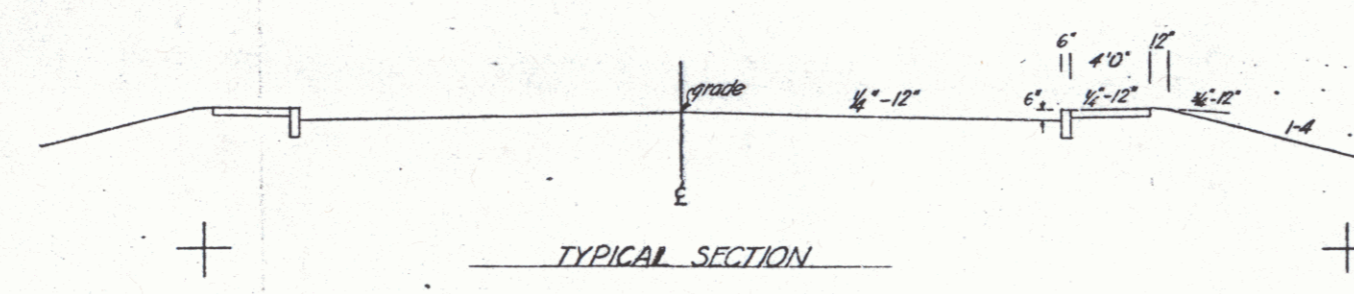


Project: mm 3.6
 Town: South Burlington
 Date: 09/01/1945
 Route: VT 116
 Plan: 00R504

ESTIMATED QUANTITIES

--	--

So BURLIN
 Surveyed by A.L.
 Designed by
 Drawn by
 Traced by N.L.S. Jr.
 Checked by
 Series No.
 Sheet 1

DATE BOOK EXAMINED CHECKED
 NO. 10/25/52 M.L.F.
 9/49

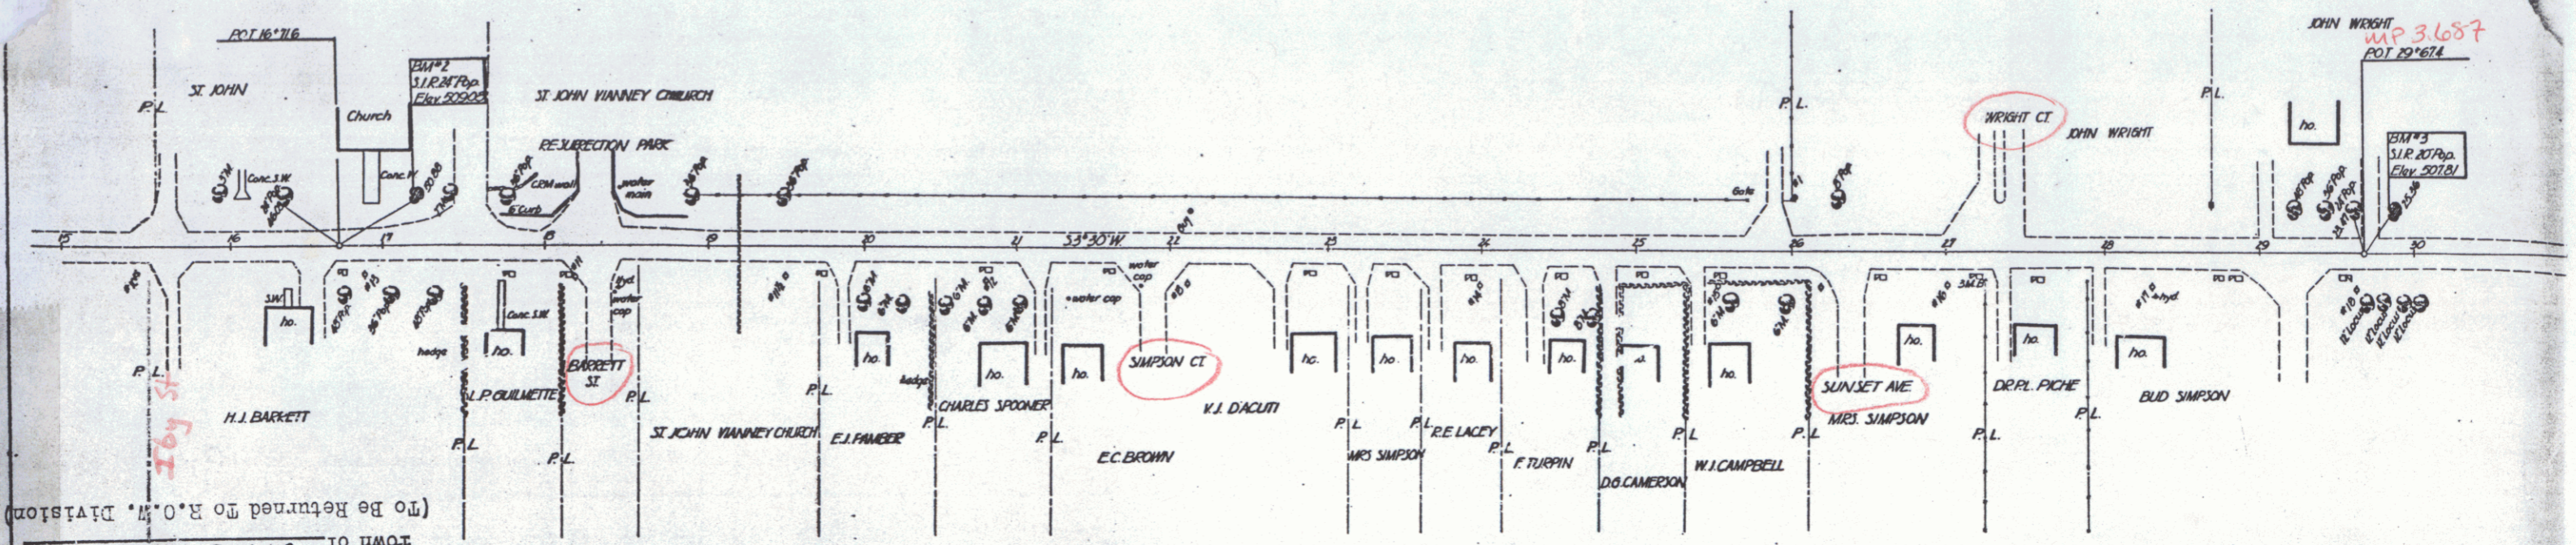

RIGHT-OF-WAY DIVISION
 TOWN FILE
 MP 3.6 - 4.252
 PERPETUAL
 Town of U116
 (To Be Returned To R.O.W. Division)



B.M. 2 S. R. 20 Pop 28 LT Sta 11711 El 509.00
 B.M. 3 S. R. 20 Pop 22 LT Sta 29'02 El 507.01

50 BURLINGTON No. 1
 Jones Sheet 2 of