
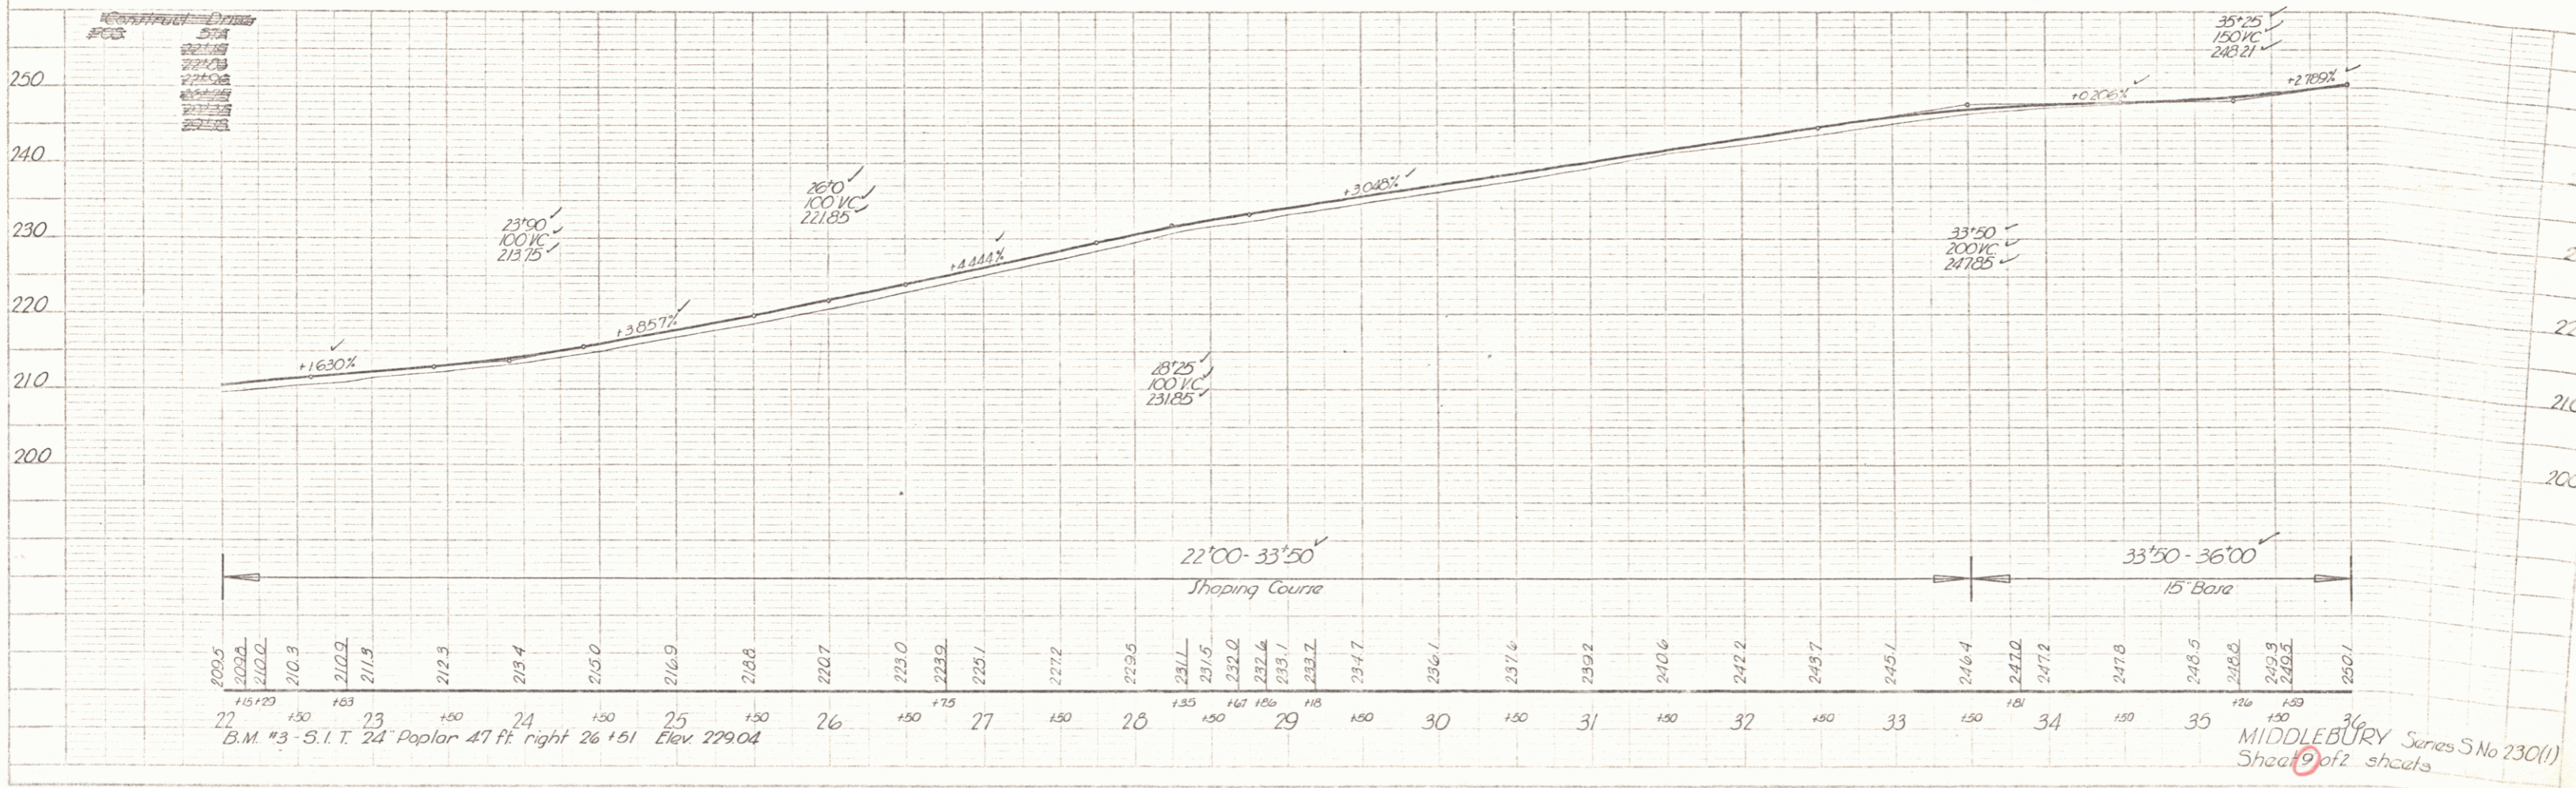


PLAN	DATE
REVISION	BY
APPROVED	DATE
DATE	BY
DATE	BY
PROFILES	DATE
REVISION	BY
APPROVED	DATE
DATE	BY
DATE	BY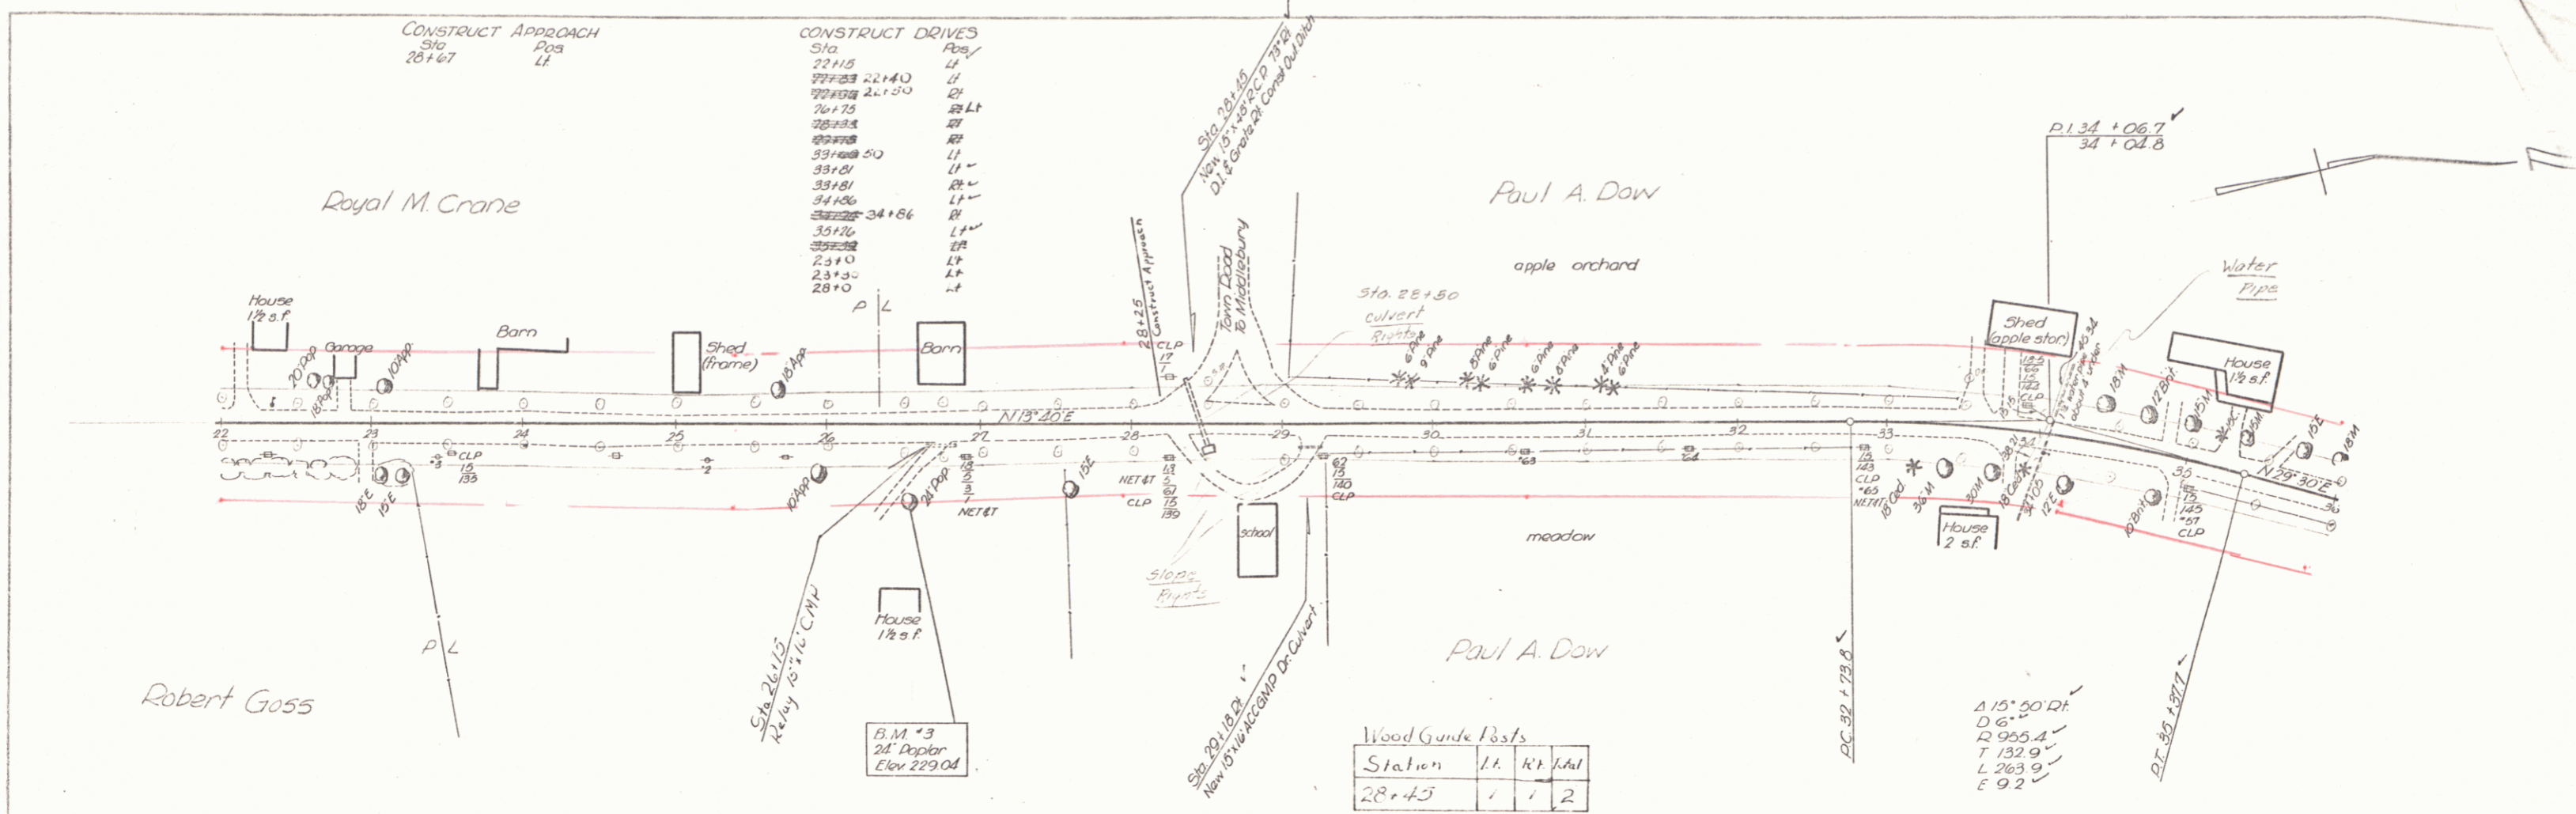
MIDDLEBURY Series S No 230(1)  
Sheet 2 of 2 sheets