


CONSTRUCT DRIVES

LT	RT
39+40	39+74
40+35	43+35
43+35	45+22
44+24	46+40
49+74	47+85

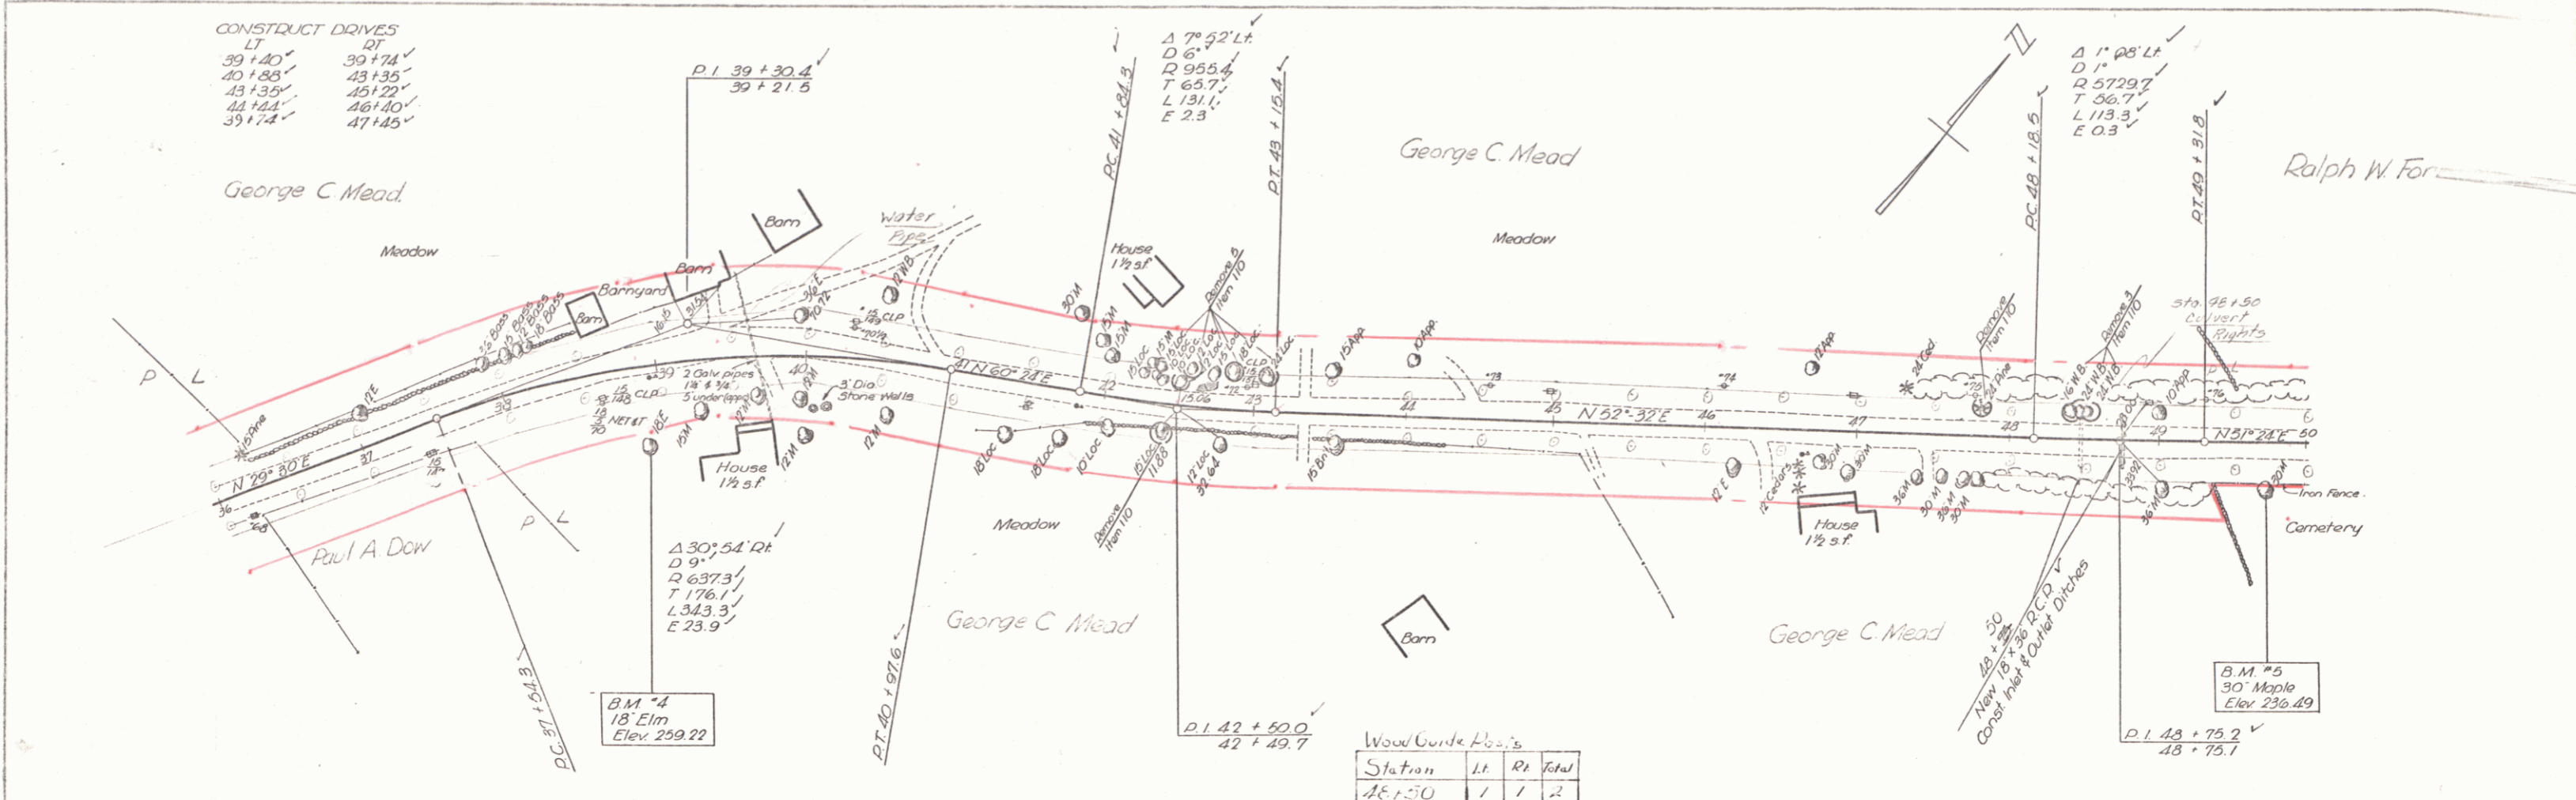


PLAN

DATE	BY	REVISION

PROFILE

DATE	BY	REVISION

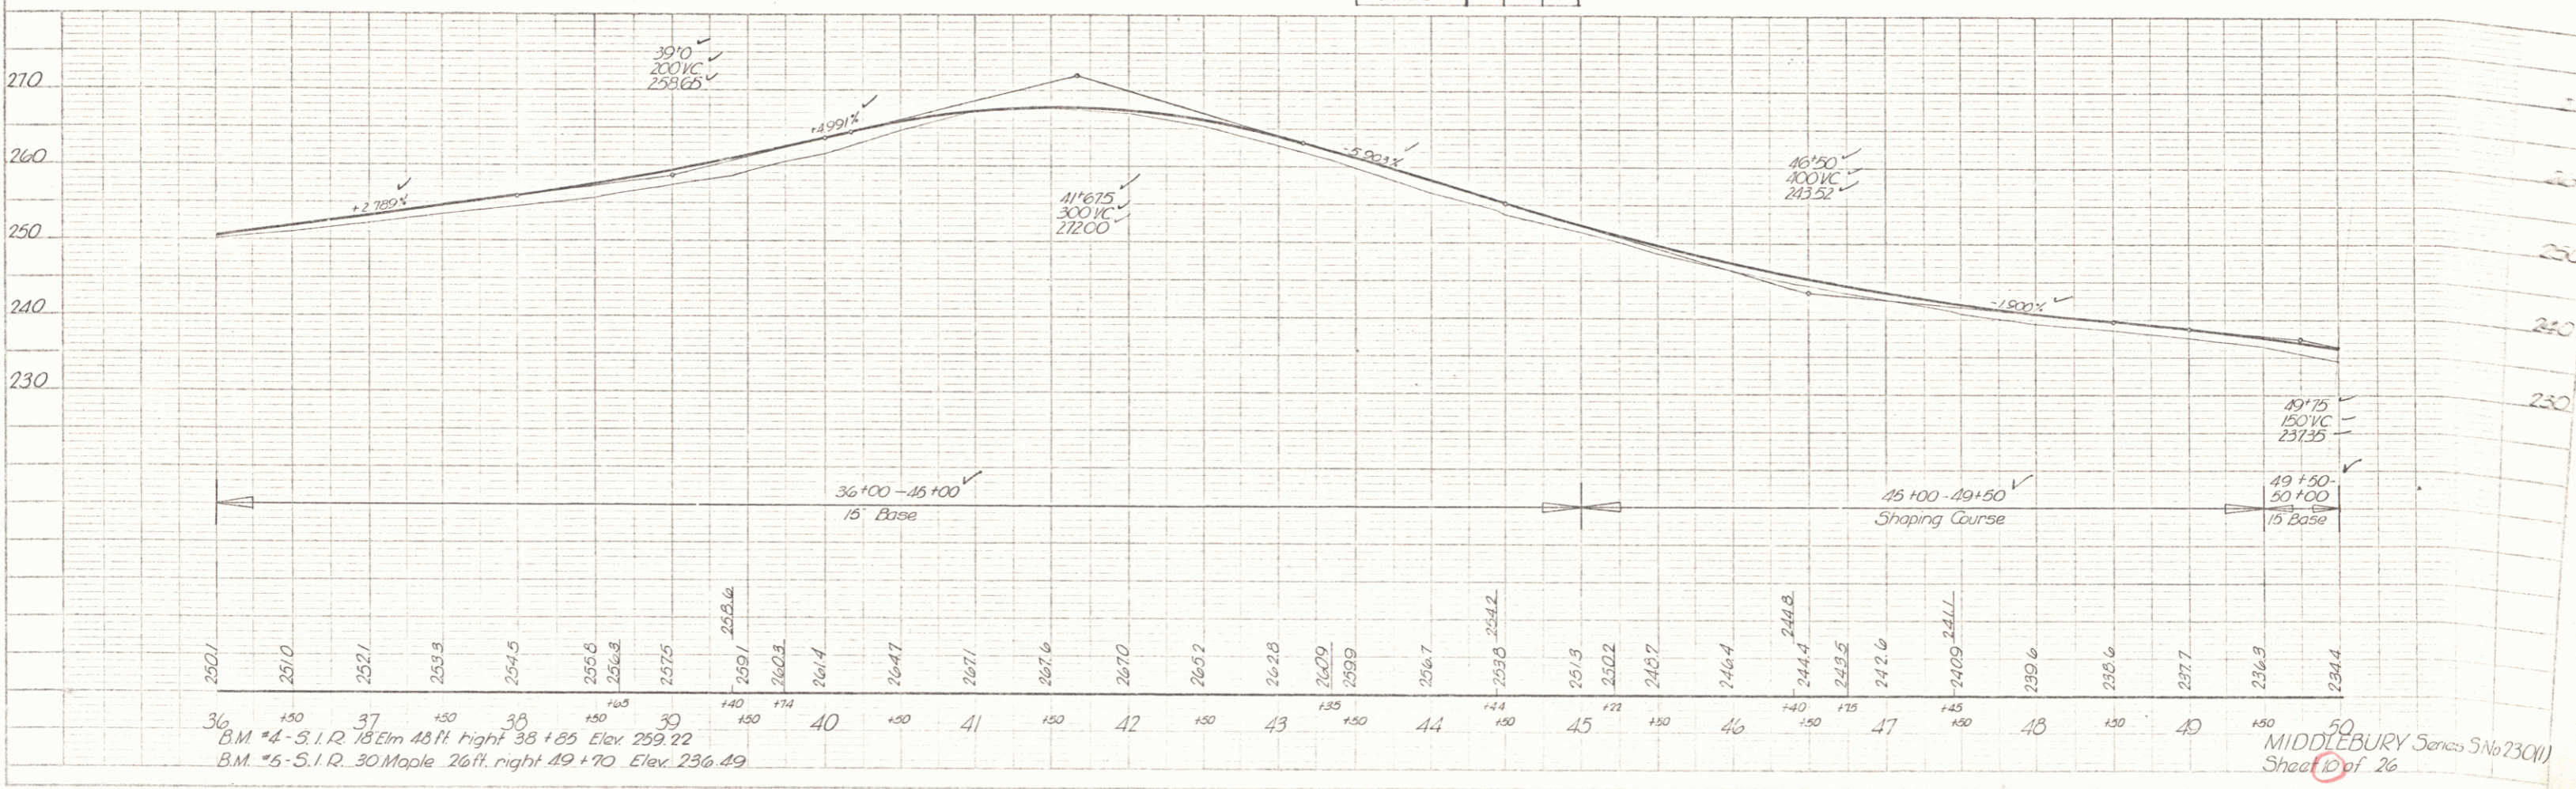

B.M. #4 - S.I.R. 18 Elm 43 ft. right 38+85 Elev. 259.22
 B.M. #5 - S.I.R. 30 Maple 26 ft. right 49+70 Elev. 236.49

MIDDLEBURY Series S No 230W
 Sheet 10 of 26