
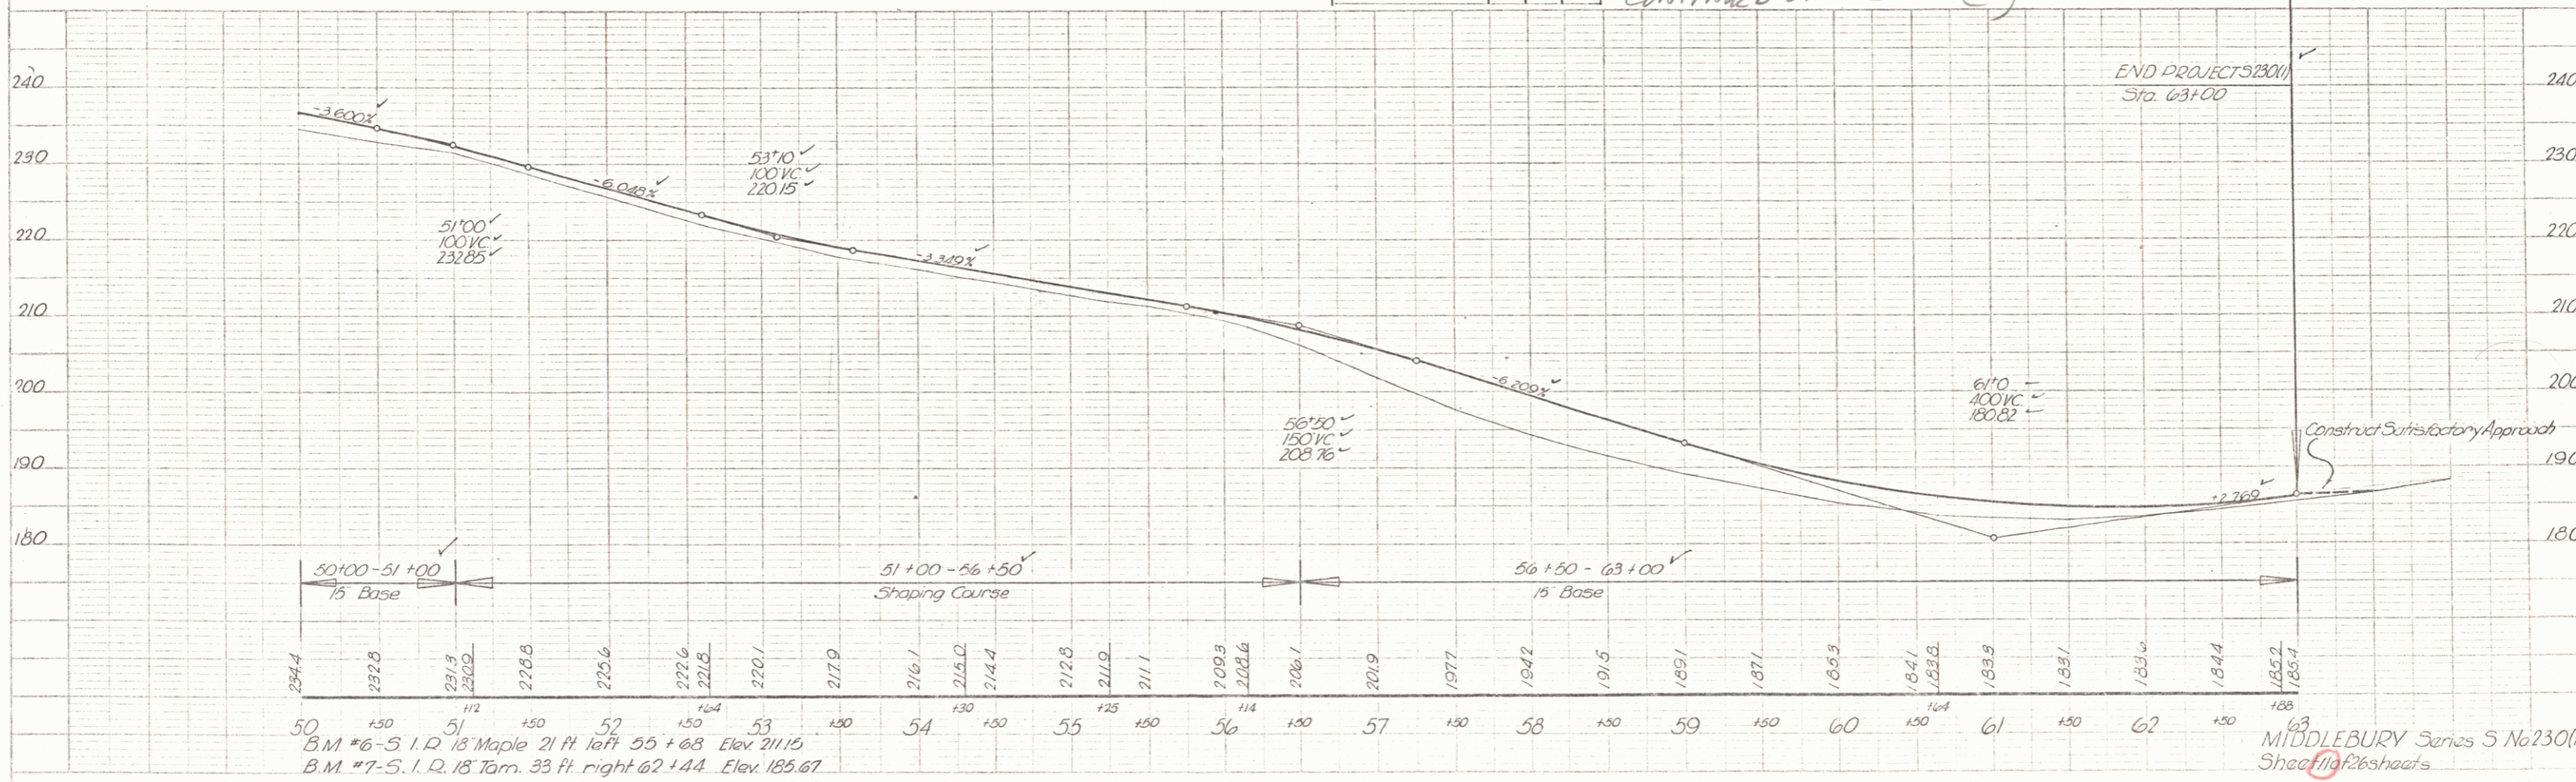


PLAN	DATE	BY
NOTED		
REVISIONS		
NO.	DATE	BY
1		
2		
3		
4		
5		

PROFILE	DATE	BY
NOTED		
REVISIONS		
NO.	DATE	BY
1		
2		
3		
4		
5		

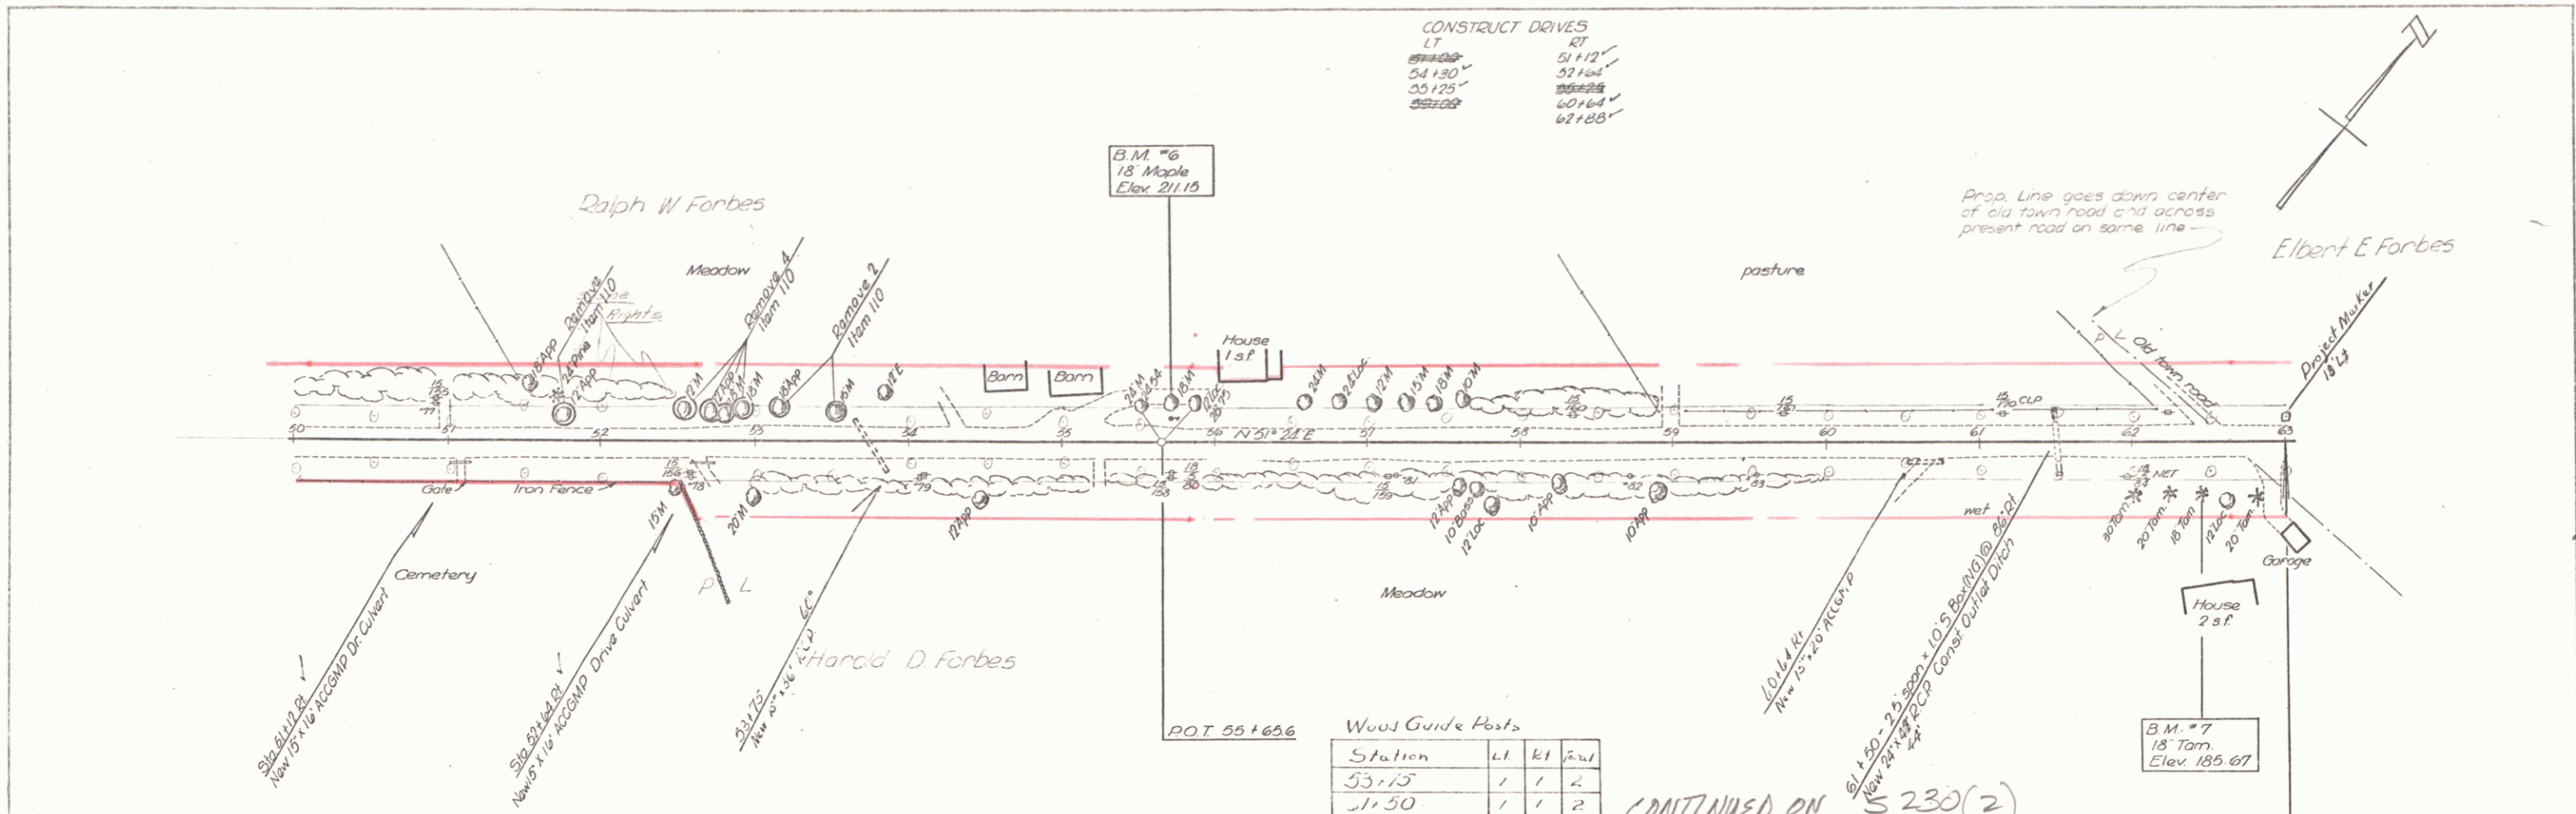

MIDDLEBURY Series 5 No 230(1)
Sheet 11 of 26 sheets