
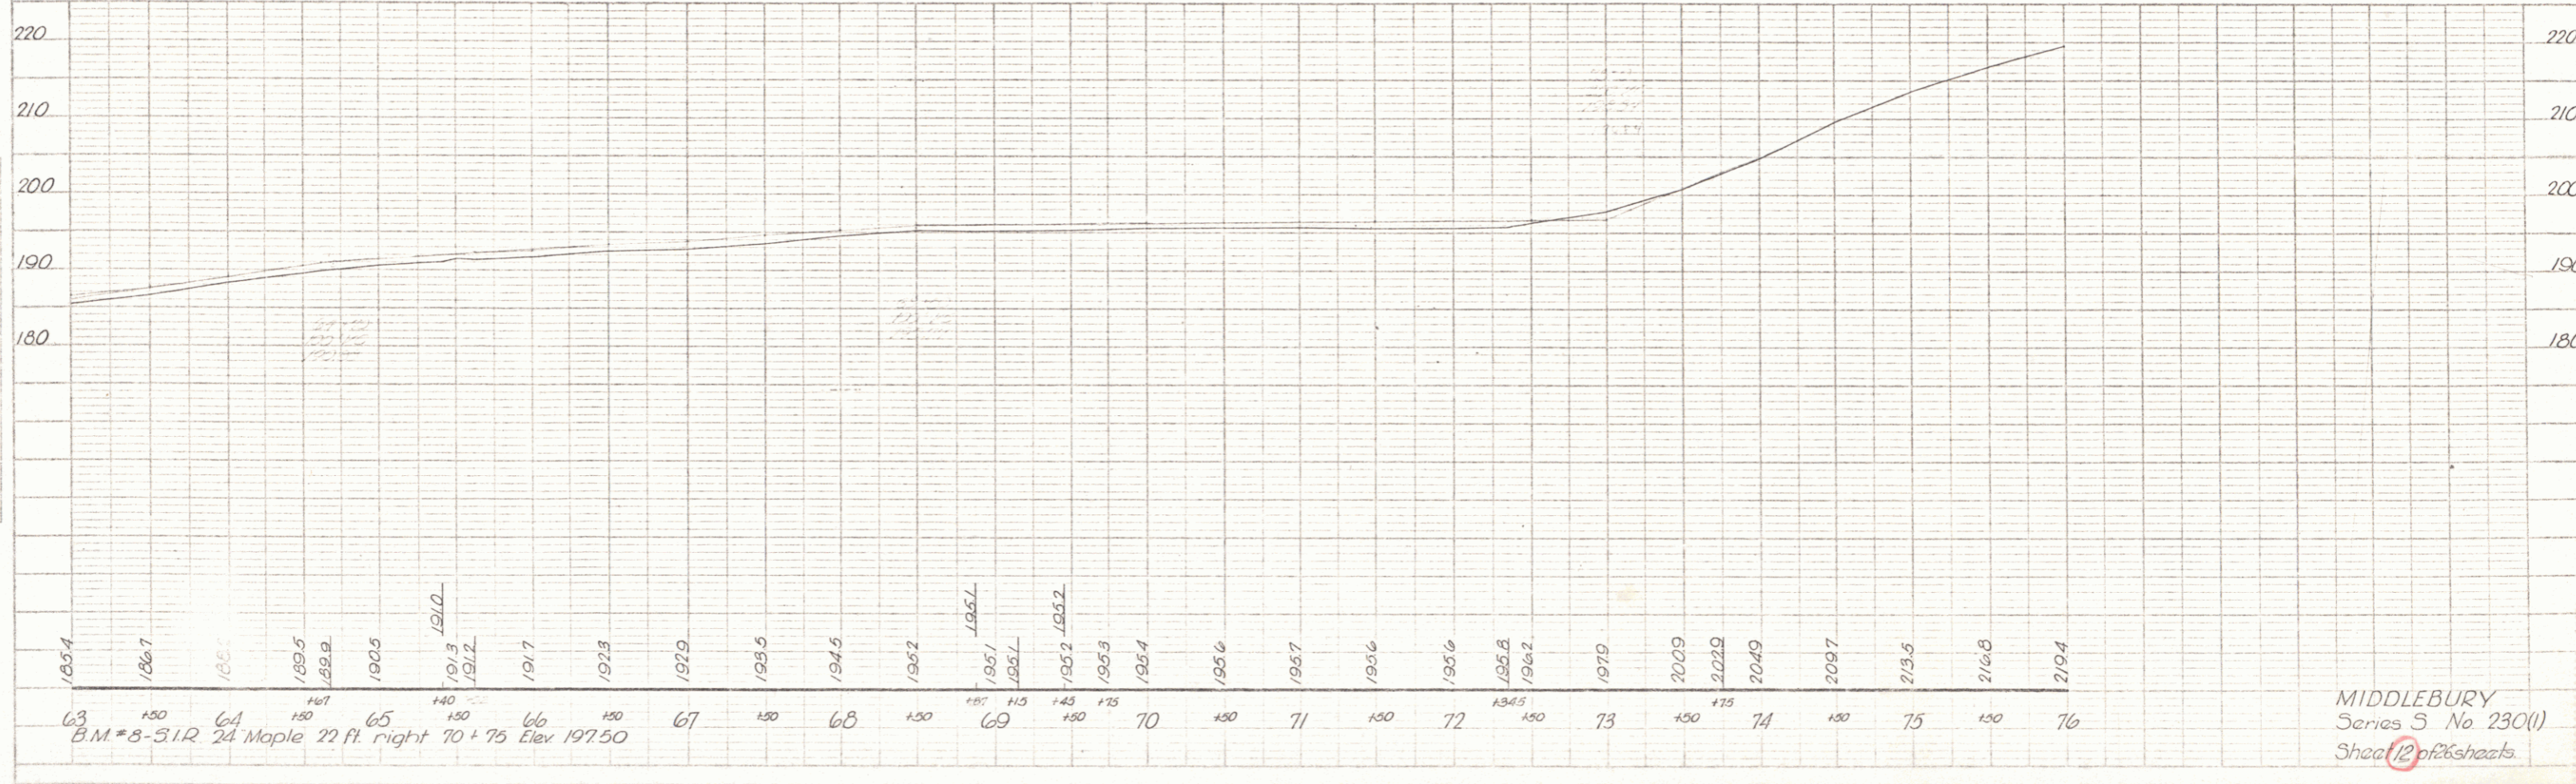


PLAN  
 DRAWN BY  
 CHECKED BY  
 DATE  
 SCALE  
 PROJECT NO.

PROFILE  
 DRAWN BY  
 CHECKED BY  
 DATE  
 SCALE  
 PROJECT NO.

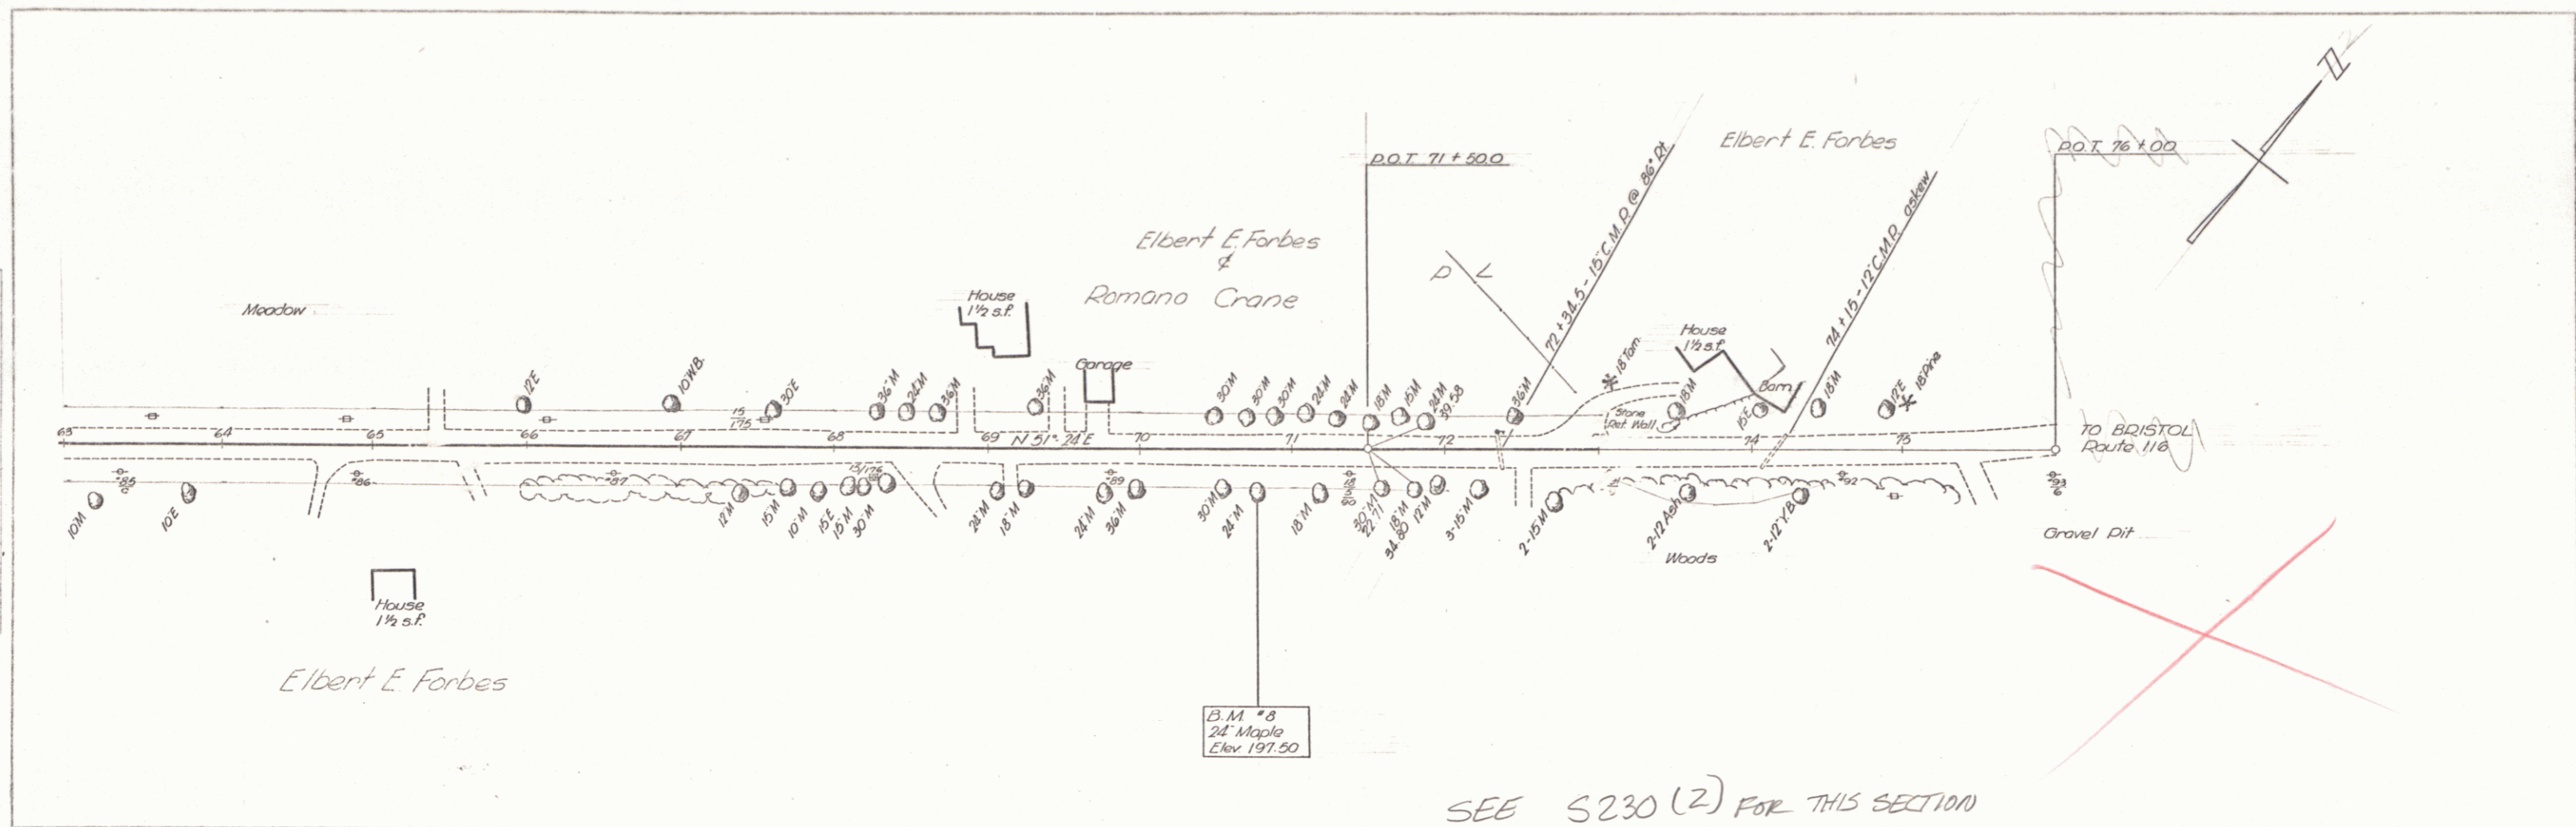

MIDDLEBURY  
 Series S No 230(1)  
 Sheet 12 of 6 sheets