


PLAN	DATE	BY
10/1/54	10/1/54	W. J. ...
10/1/54	10/1/54	W. J. ...
PROFILE	DATE	BY
10/1/54	10/1/54	W. J. ...
10/1/54	10/1/54	W. J. ...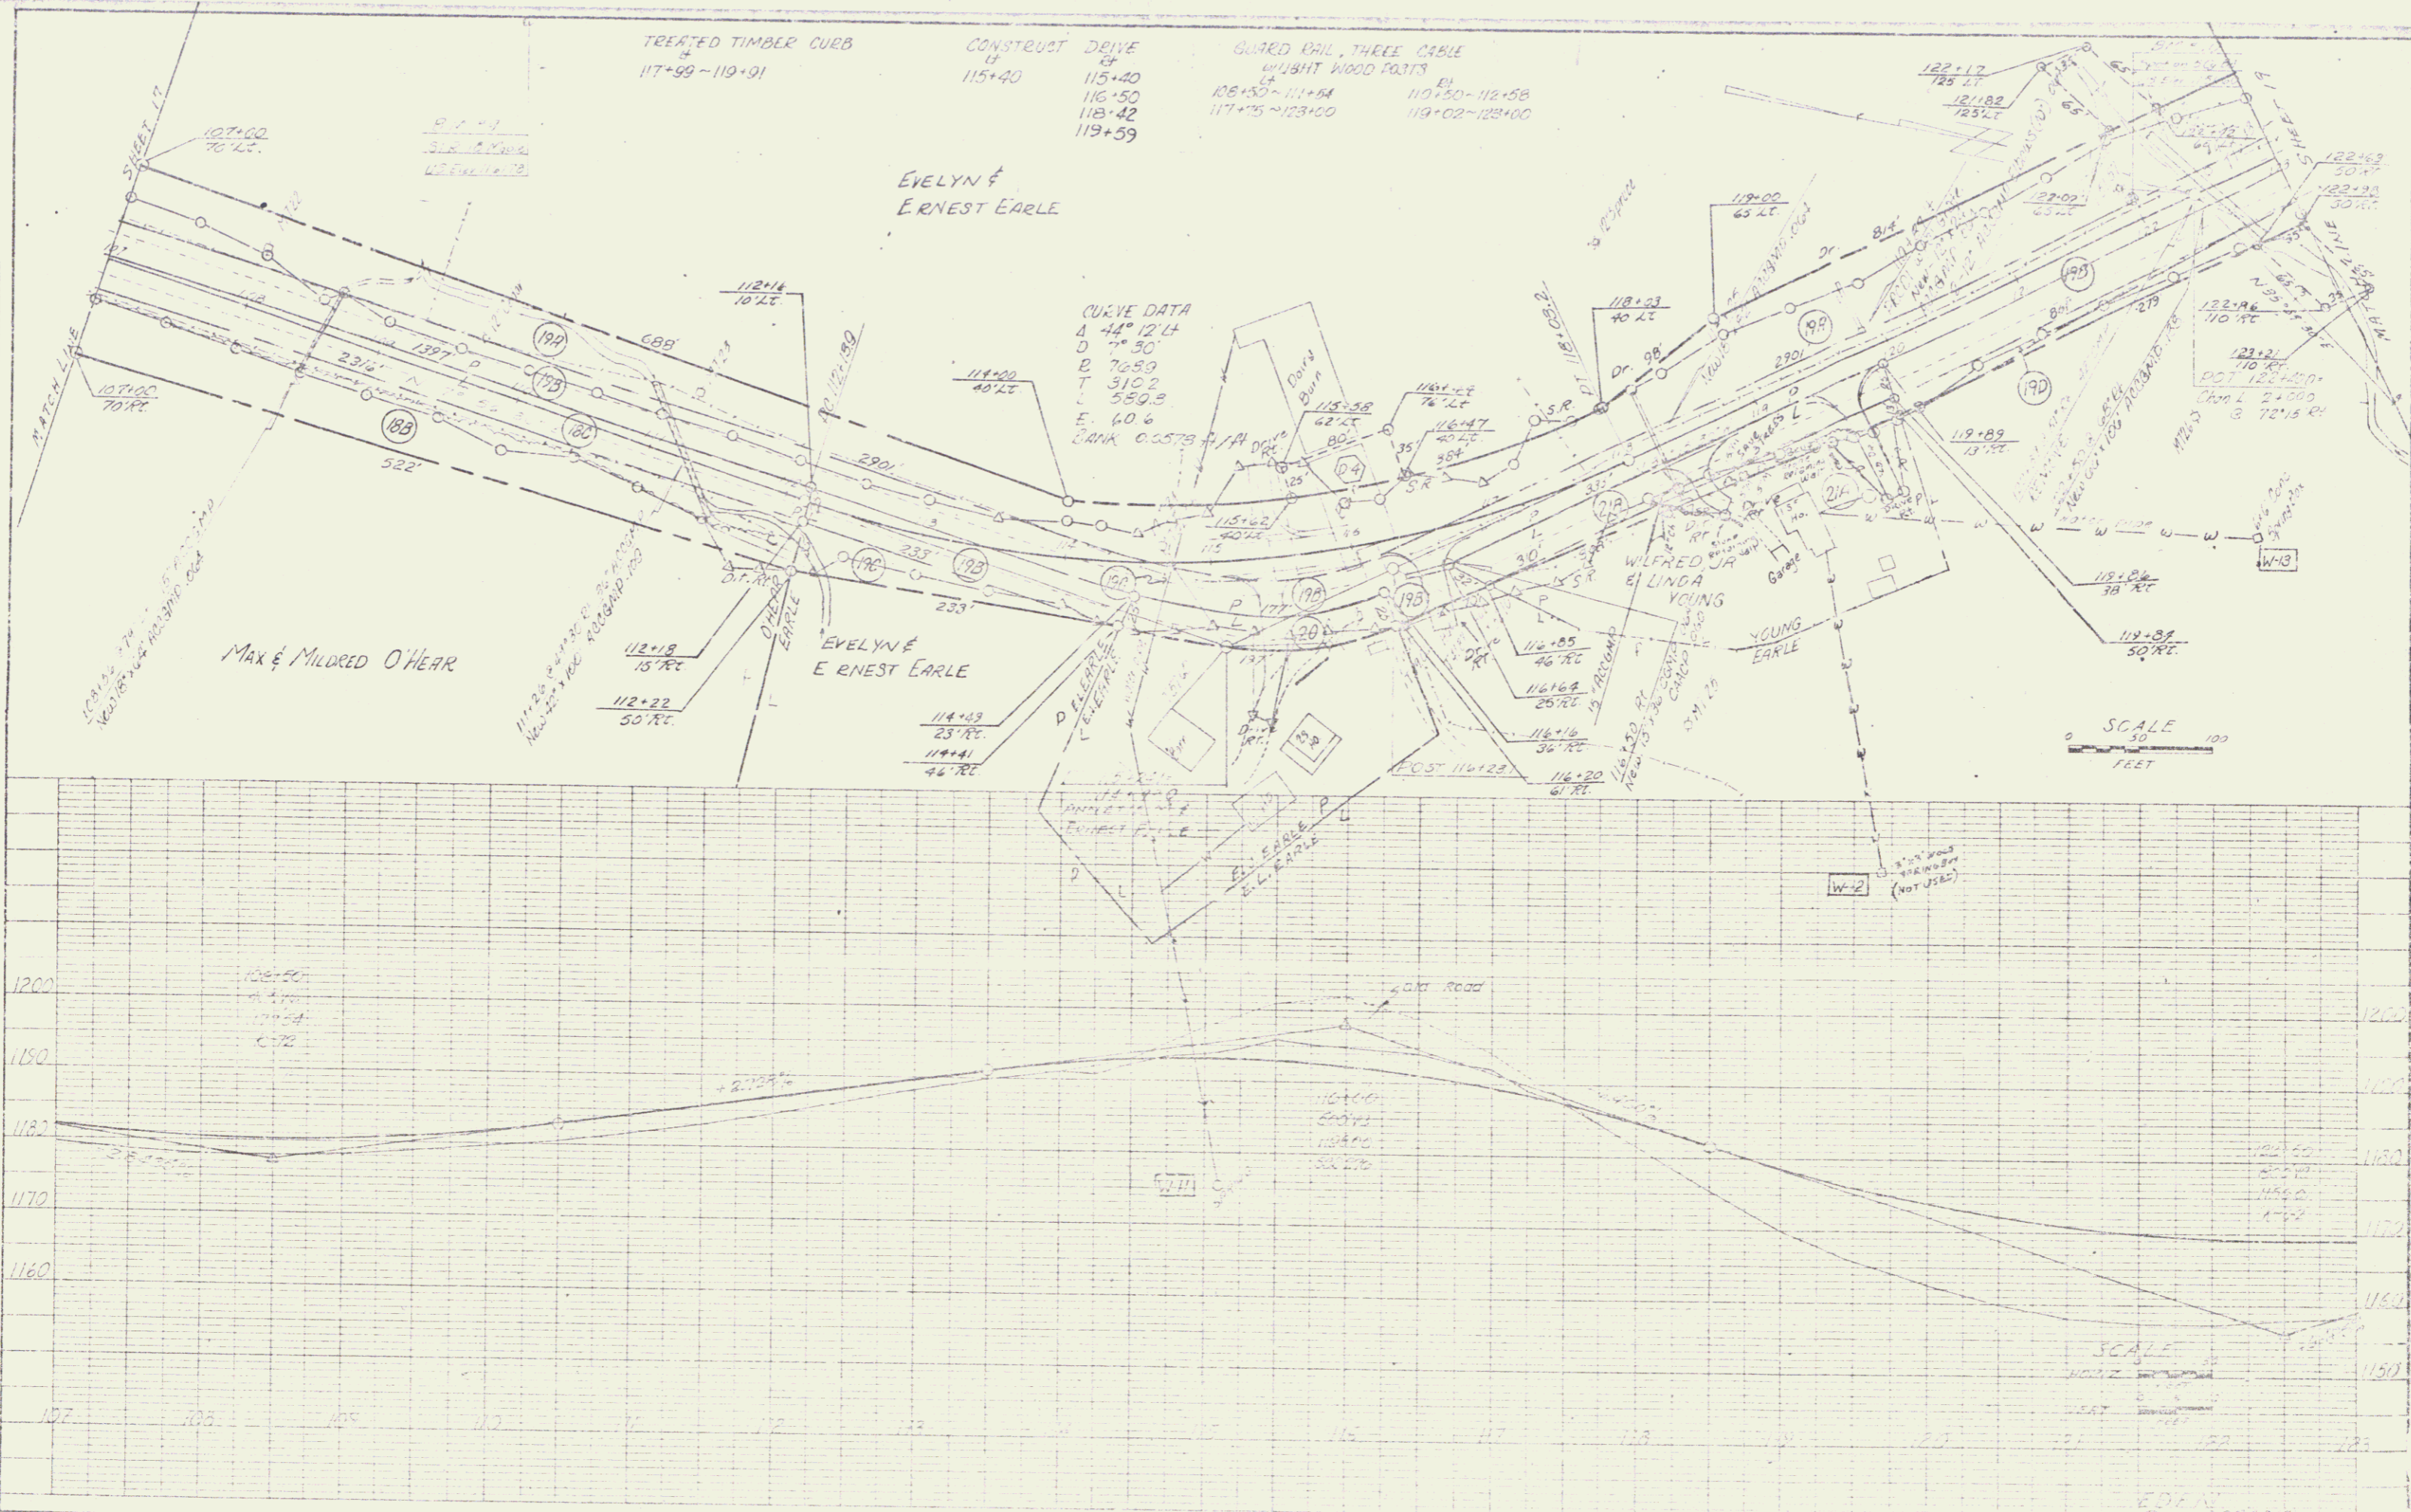
SCALE
1" = 100'
FEET