

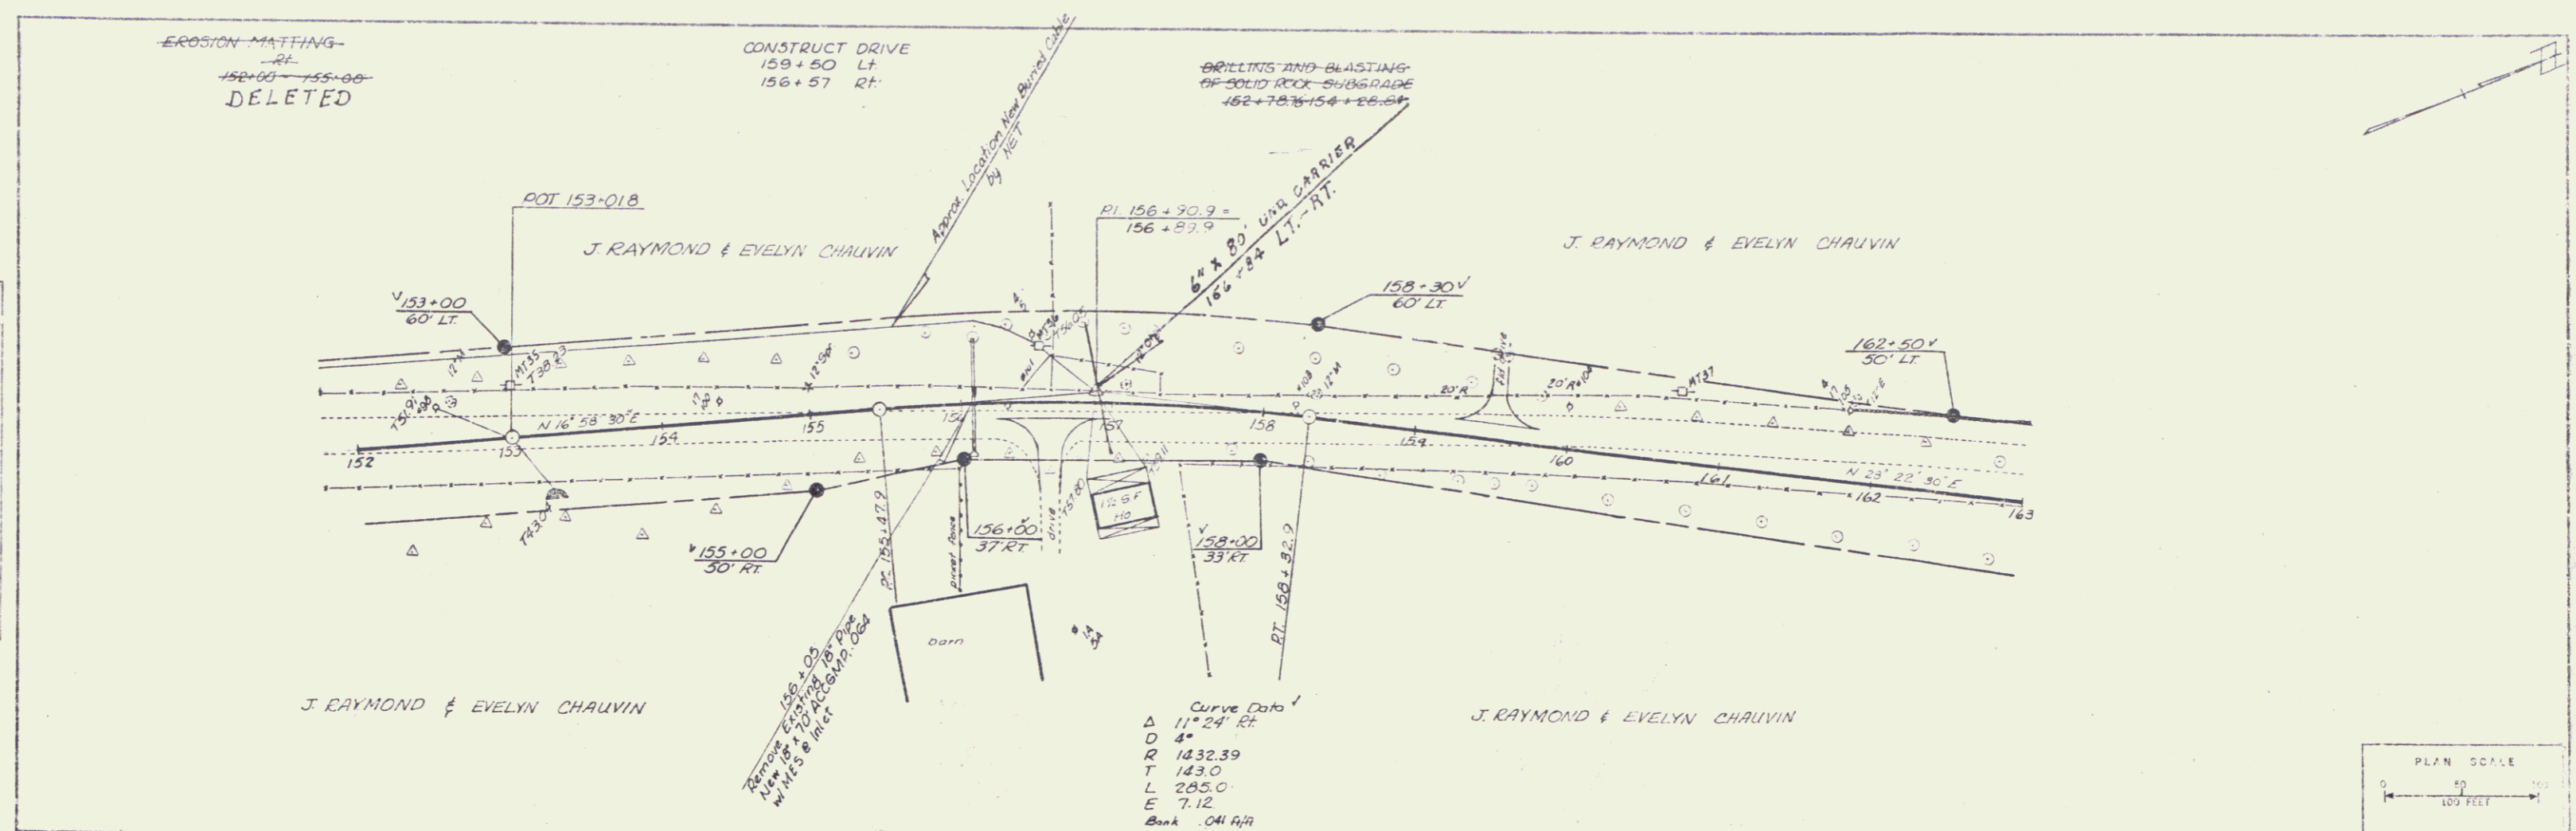


PLAN  
 NOTES:  
 1. ALL DIMENSIONS ARE IN FEET UNLESS OTHERWISE NOTED.  
 2. ALL ANGLES ARE IN DEGREES.  
 3. ALL DISTANCES ARE ALONG THE CENTERLINE UNLESS OTHERWISE NOTED.

PROFILE  
 NOTES:  
 1. ALL ELEVATIONS ARE IN FEET UNLESS OTHERWISE NOTED.  
 2. ALL DISTANCES ARE ALONG THE CENTERLINE UNLESS OTHERWISE NOTED.

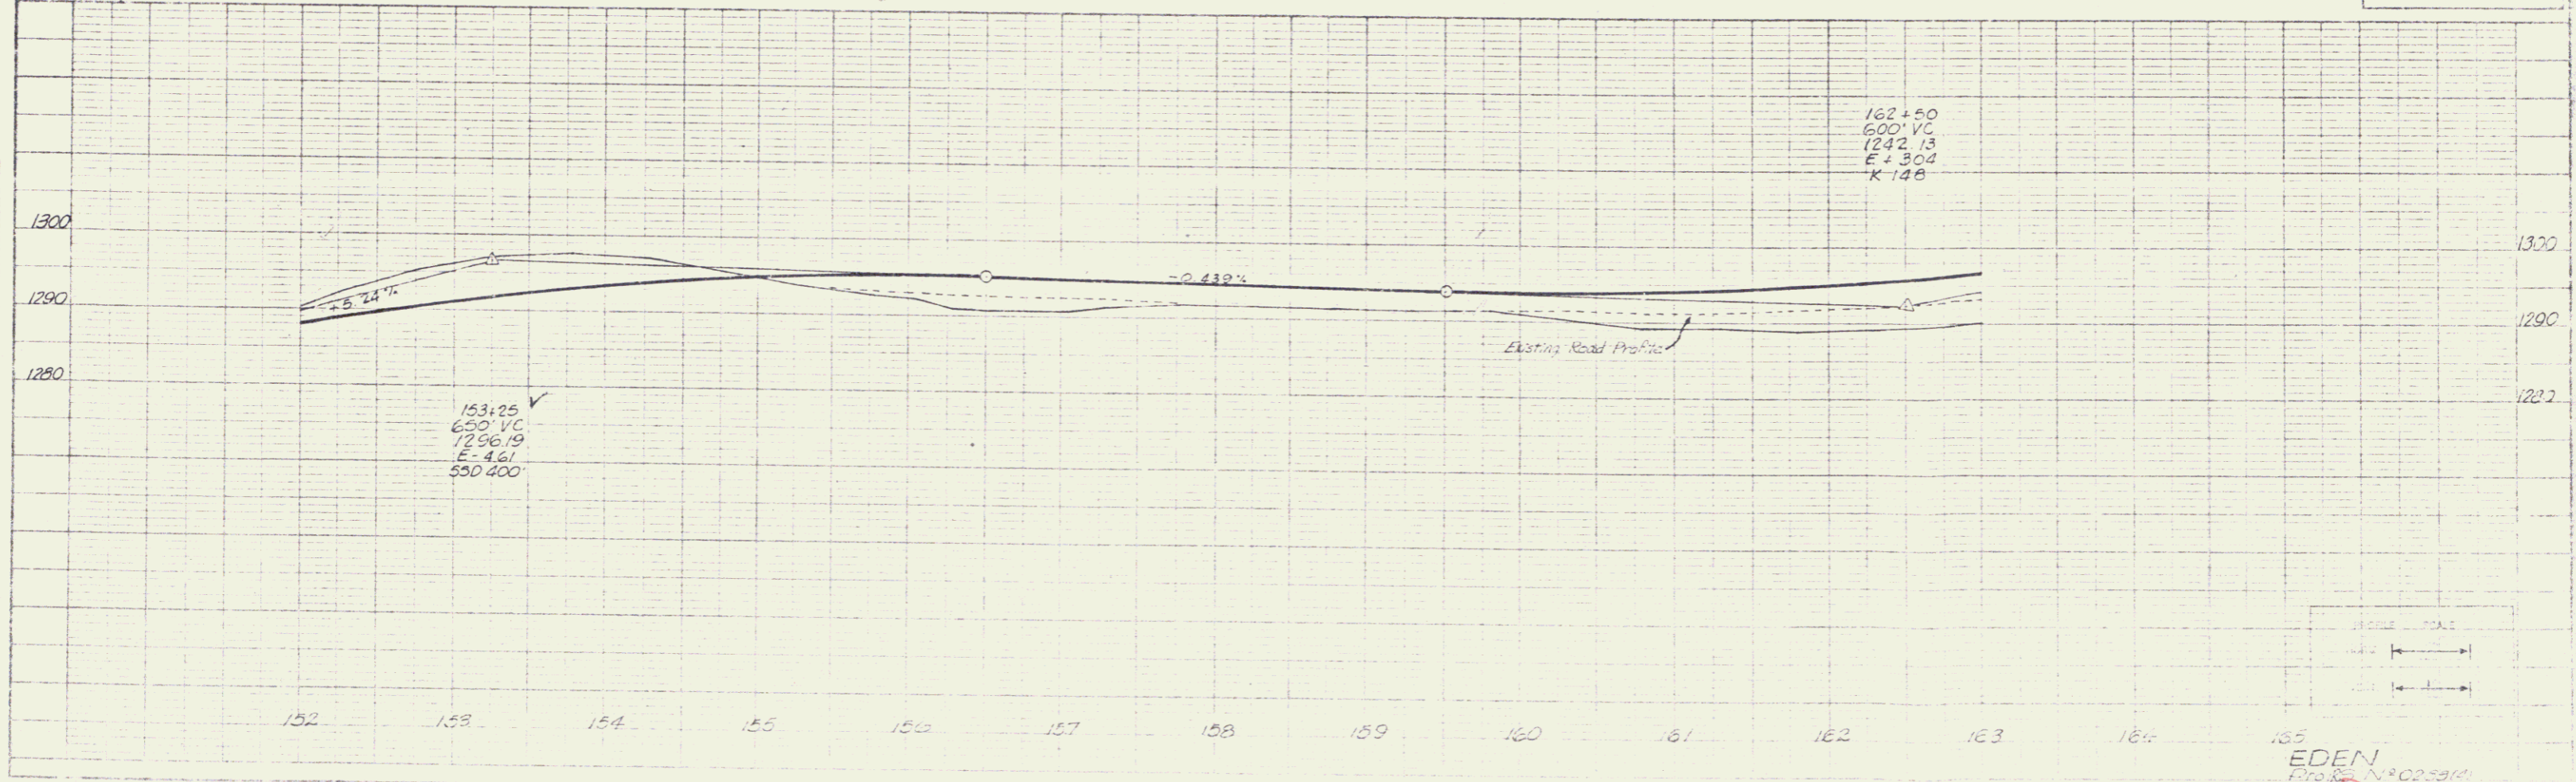

Curve Data  
 Δ 11° 24' 42"  
 D 4'  
 R 1432.39  
 T 143.0  
 L 285.0  
 E 7.12  
 Bank 0.41 ft

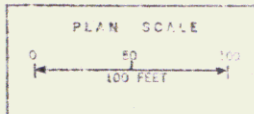

EDEN  
 PROFESSIONAL ENGINEERS  
 CIVIL ENGINEERS  
 18  
 7