
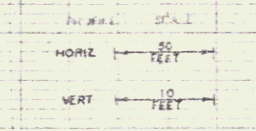
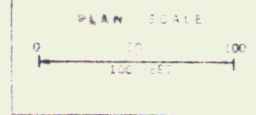


PLAN
 DATE: 05/11/11
 DRAWN BY: J. J. JAMES
 CHECKED BY: J. J. JAMES
 PROJECT: 0229(4)
 SHEET: 19 OF 13 SHEETS

PROFILE
 DATE: 05/11/11
 DRAWN BY: J. J. JAMES
 CHECKED BY: J. J. JAMES
 PROJECT: 0229(4)
 SHEET: 19 OF 13 SHEETS

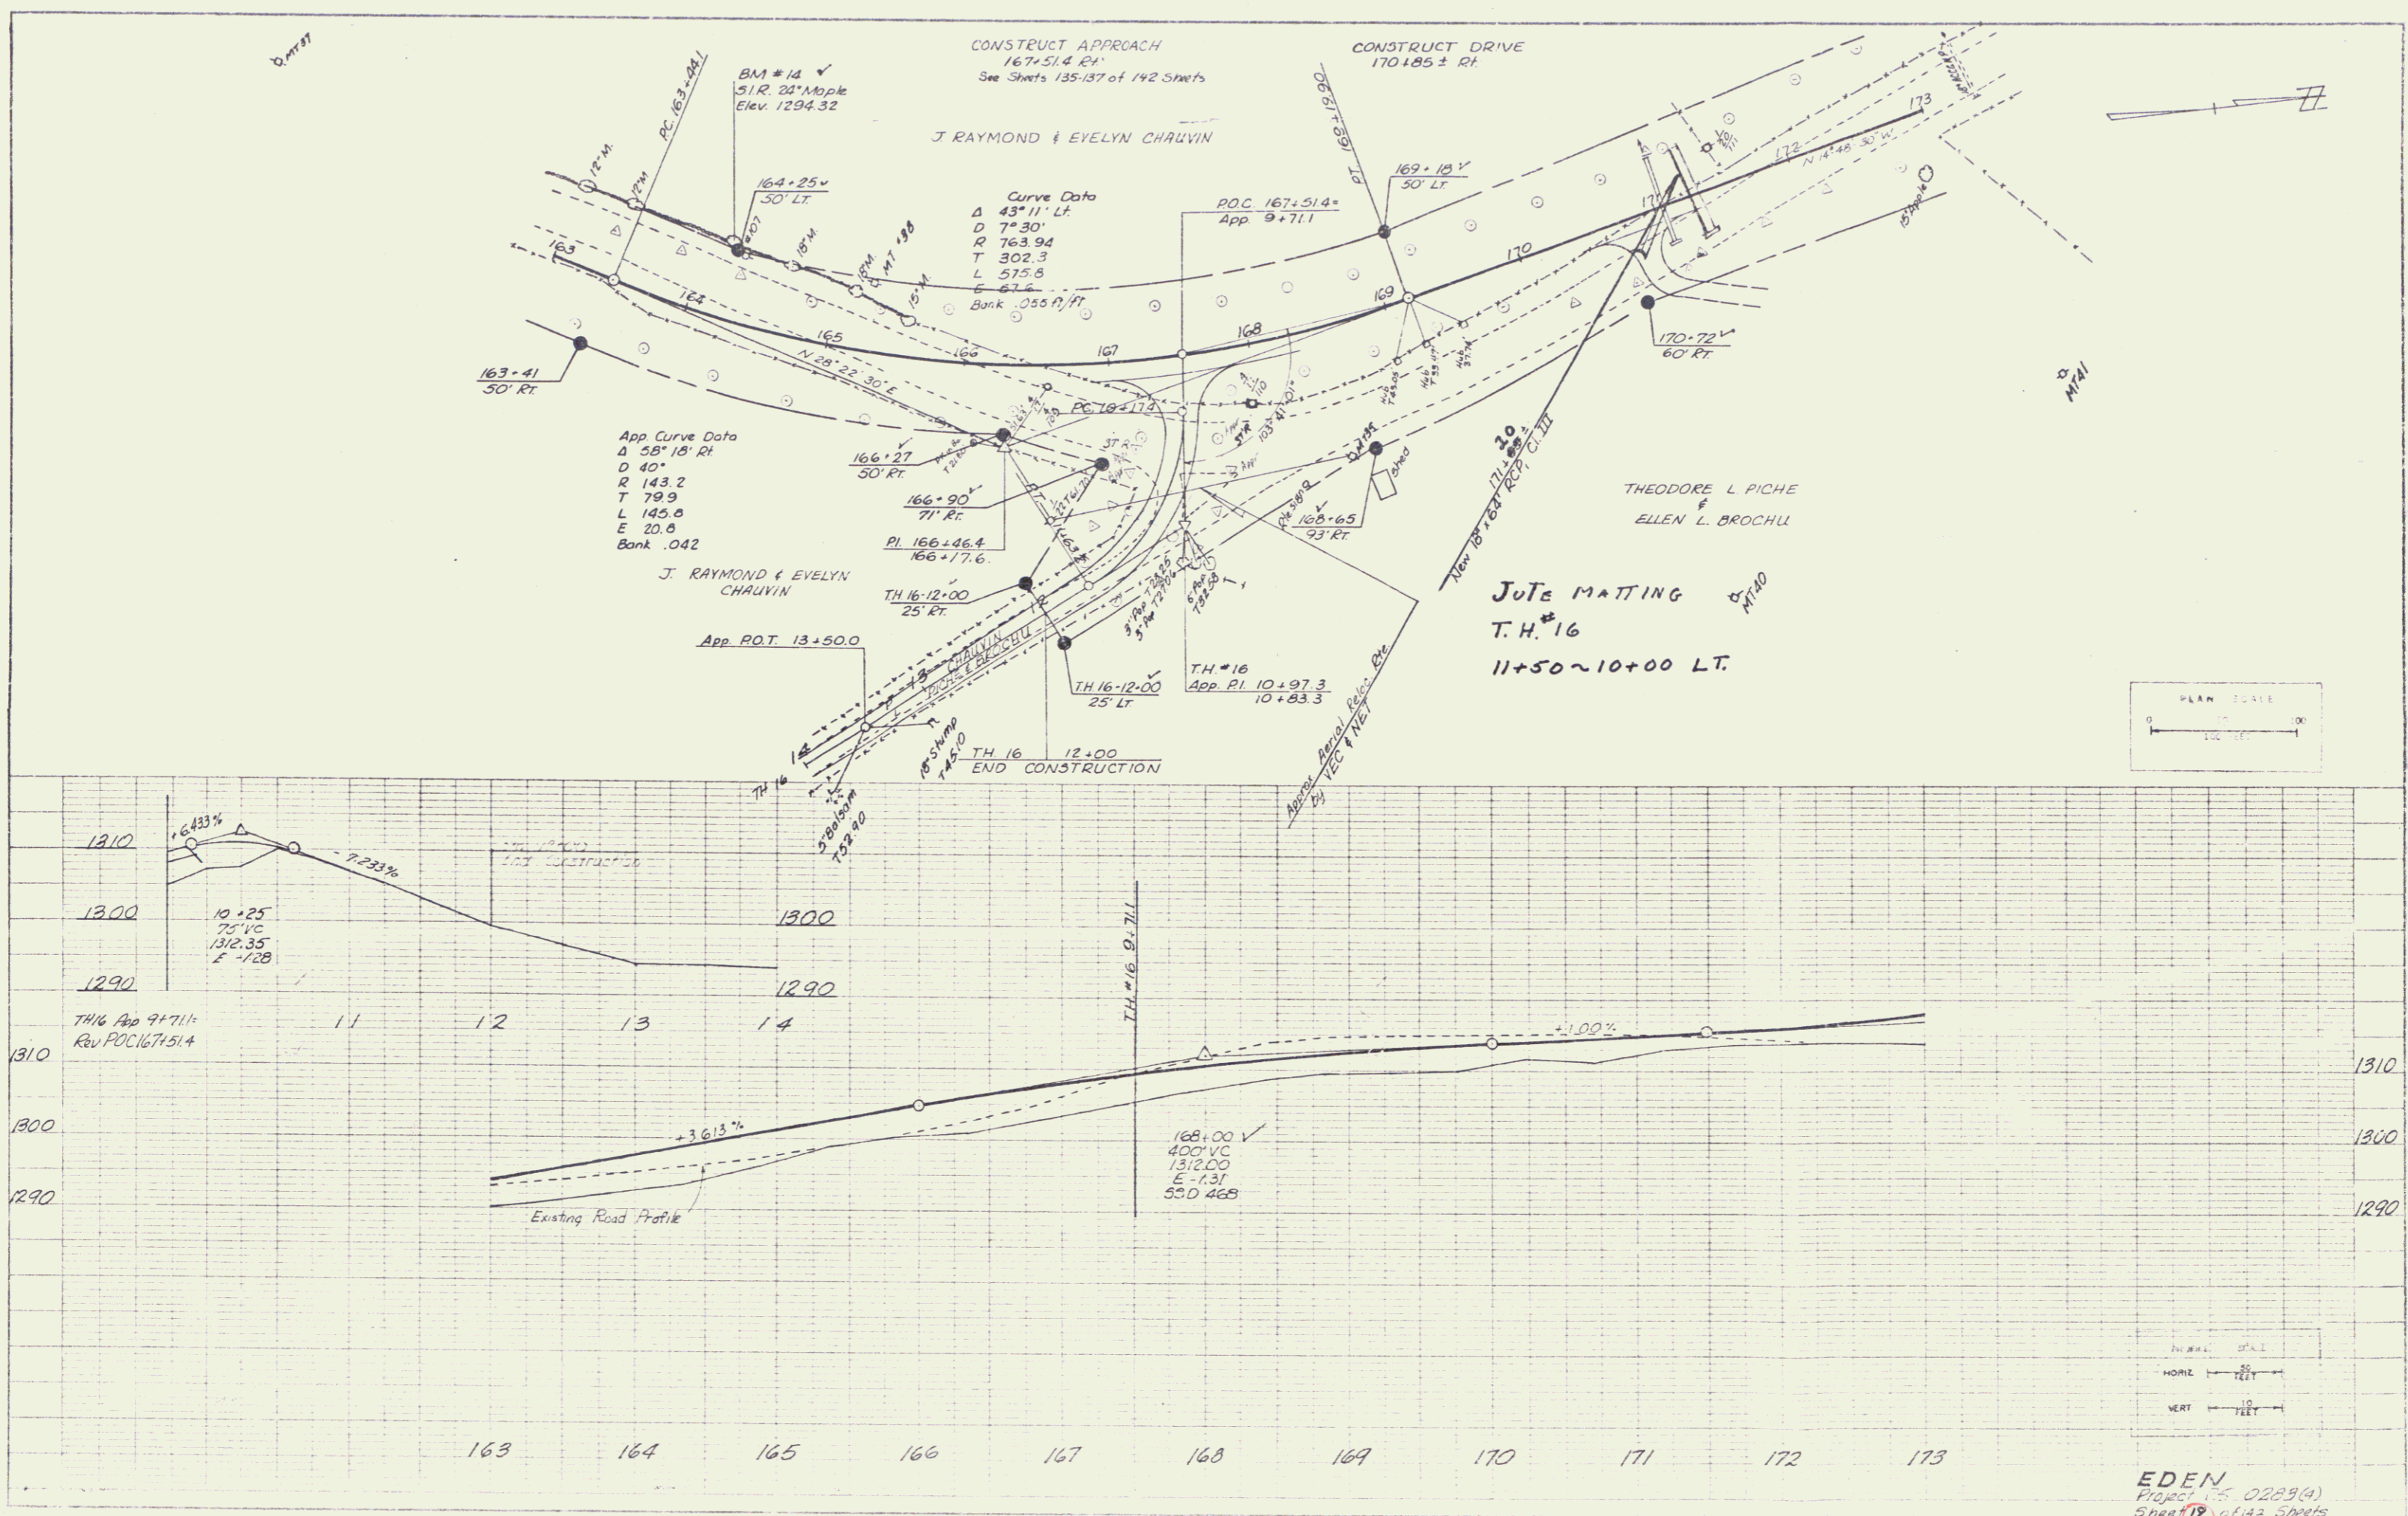

EDEN
 Project 0229(4)
 Sheet 19 of 13 Sheets