


DRILLING AND BLASTING  
OF SOLID ROCK SUBGRADE  
177+70.14 - 181+19.67  
177+90 ~ 182+0

CONSTRUCT DRIVE  
178+00 LF V  
180+70 RT V  
179+10 LF V

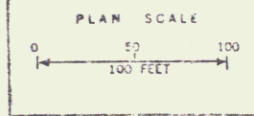

Surveyed by Spaulding DATE 7.7.74  
 DRAWN BY Spaulding DATE 8.2  
 TRACED BY Spaulding DATE 8.2  
**EDEN**  
 PROJ RS NO. 0283(4)  
 SHEET 20 OF 142  
 0-7