



PLAN
 1:25
 1" = 25'

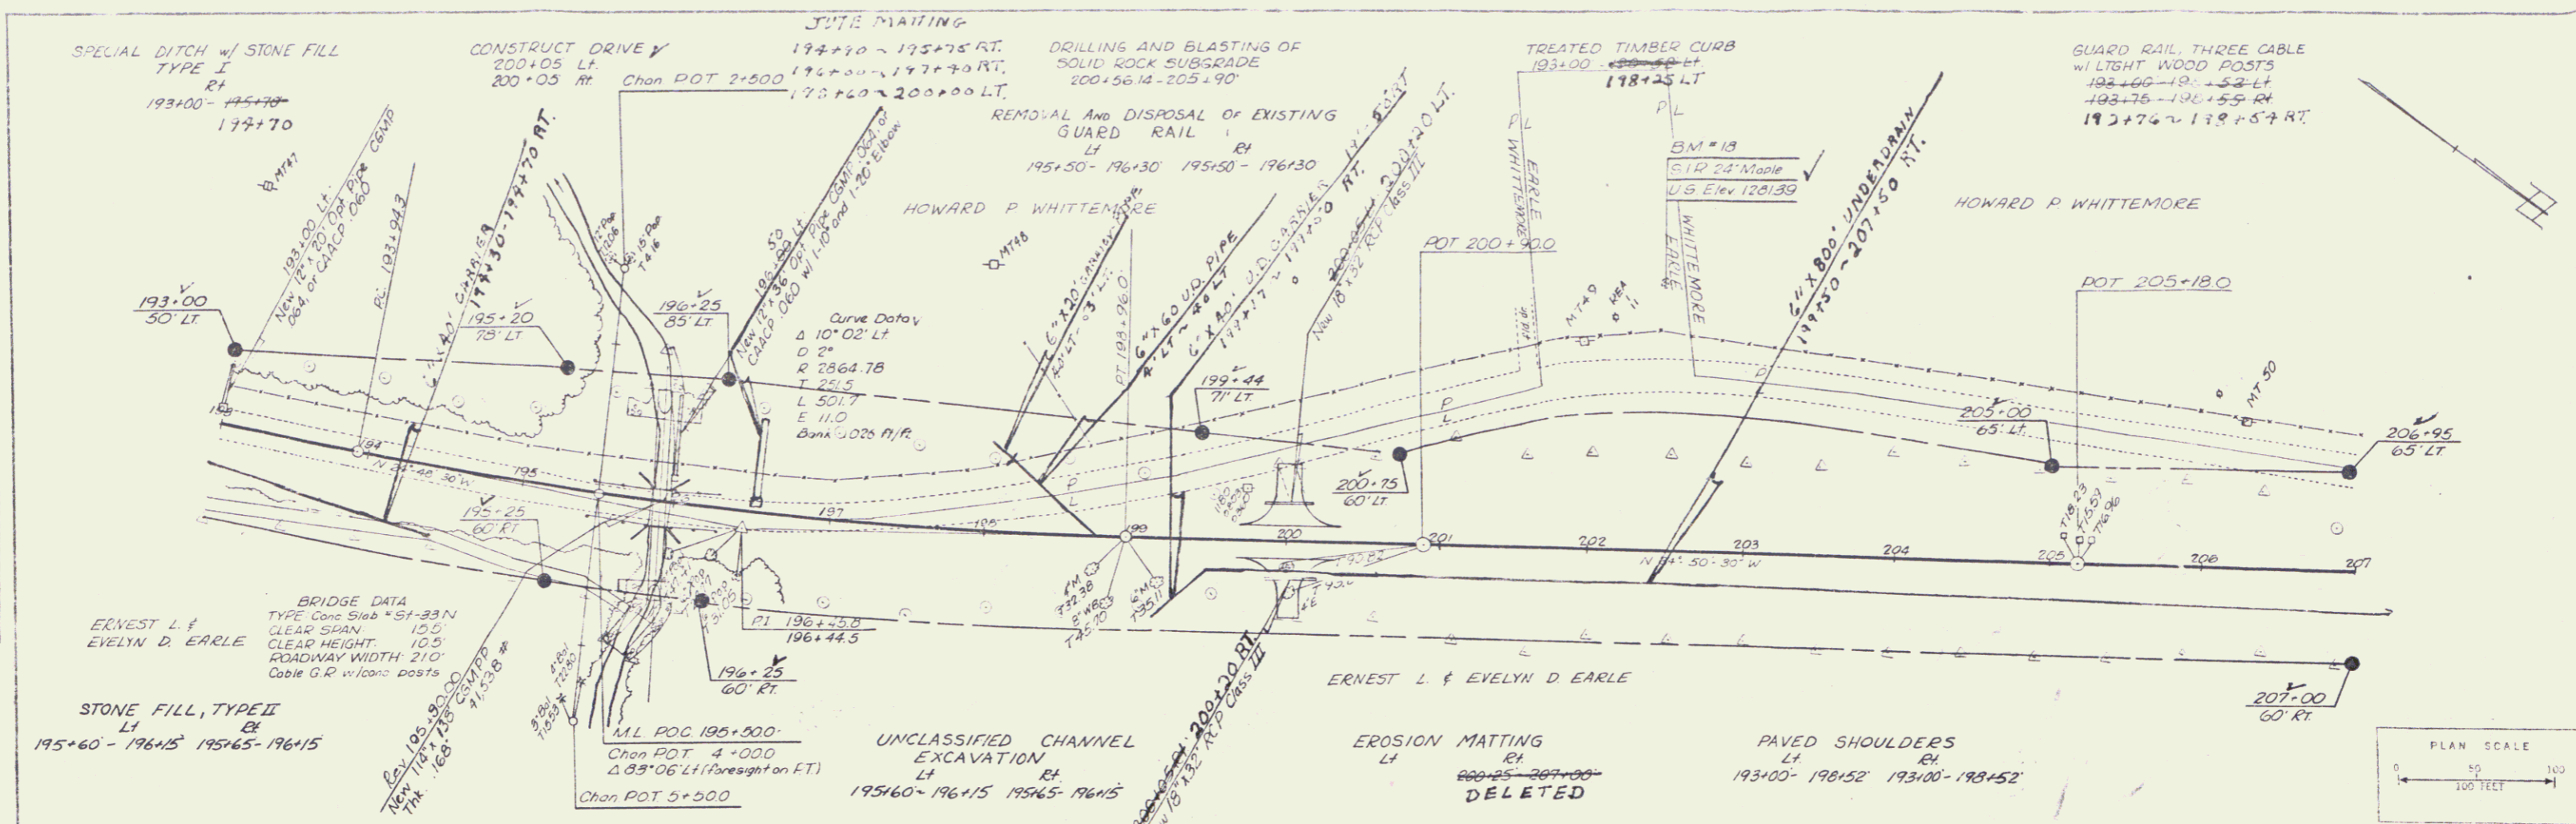

PROFILE
 1:25
 1" = 25'

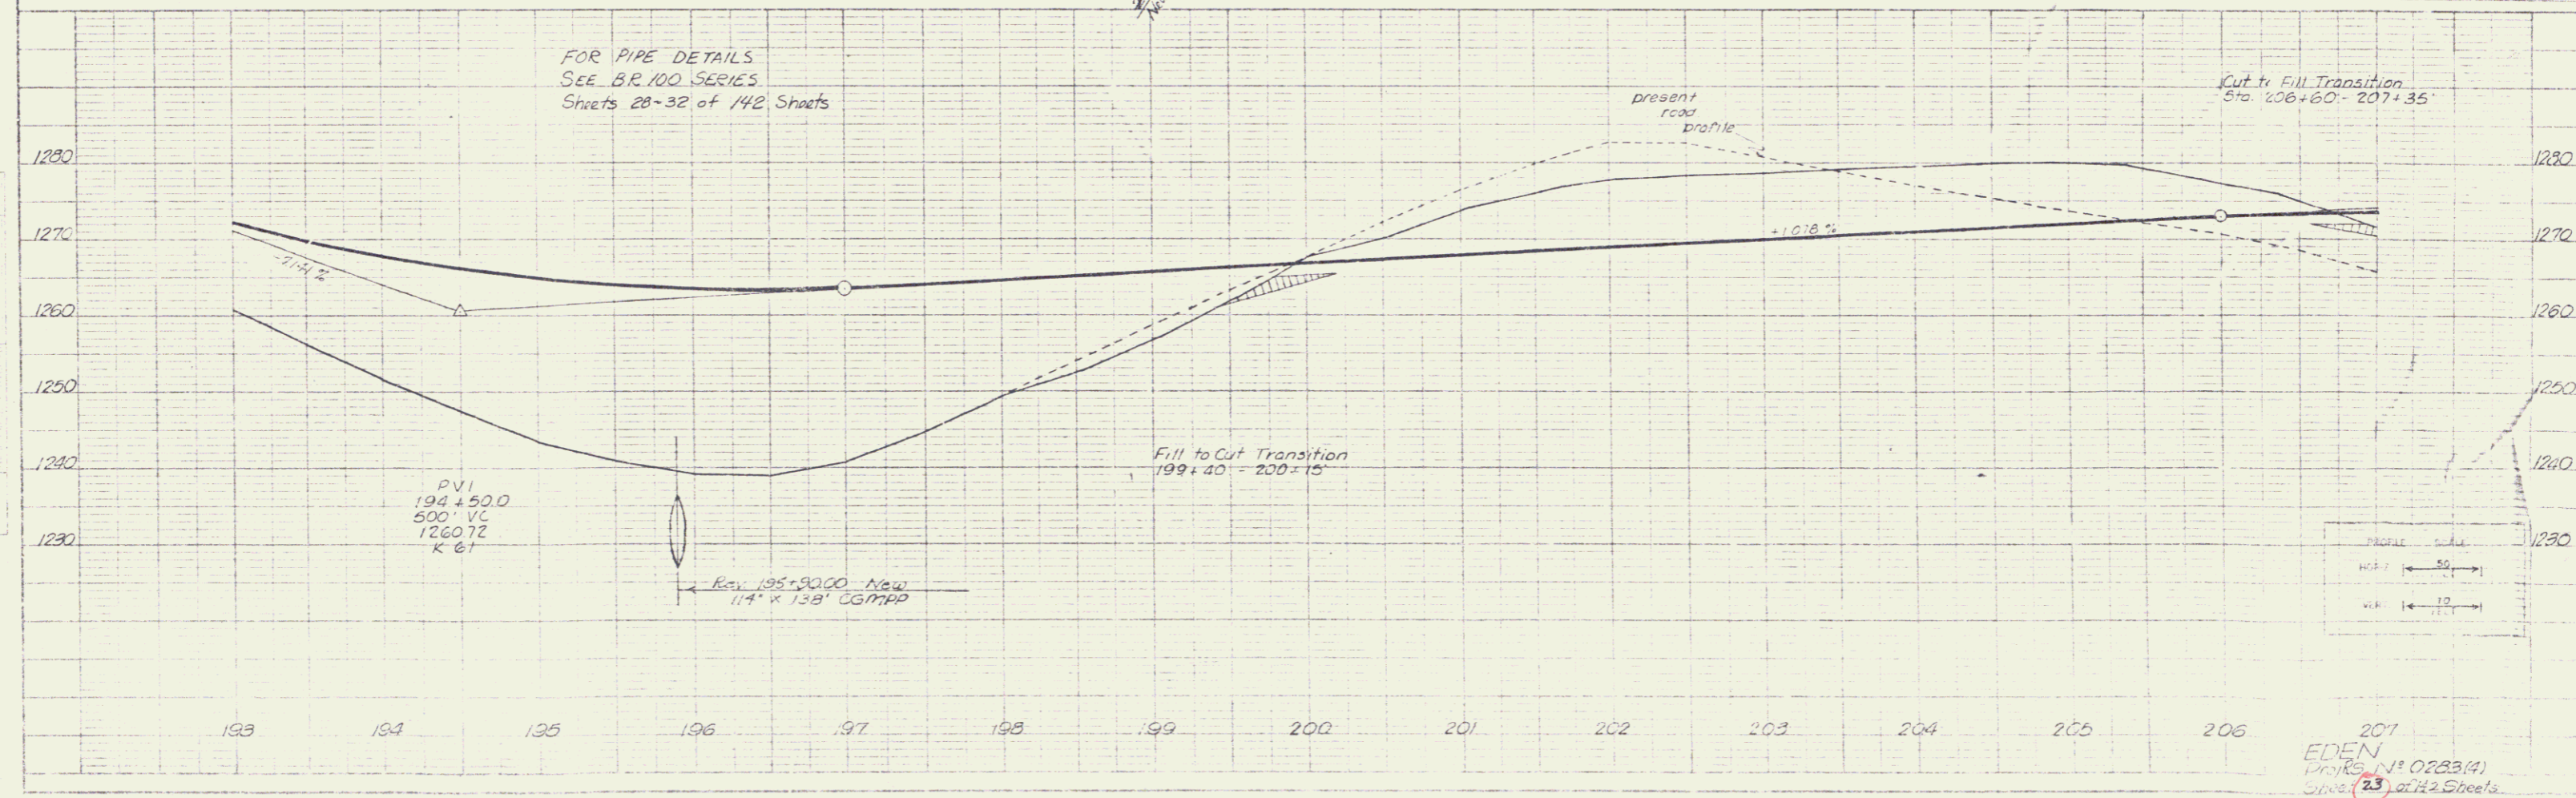

EDEN
 Proj. No. 0223(4)
 Sheet 23 of 12 Sheets