


PLAN
 DATE: 7-62
 DRAWN BY: [illegible]
 CHECKED BY: [illegible]

PROFILE
 DATE: 7-62
 DRAWN BY: [illegible]
 CHECKED BY: [illegible]

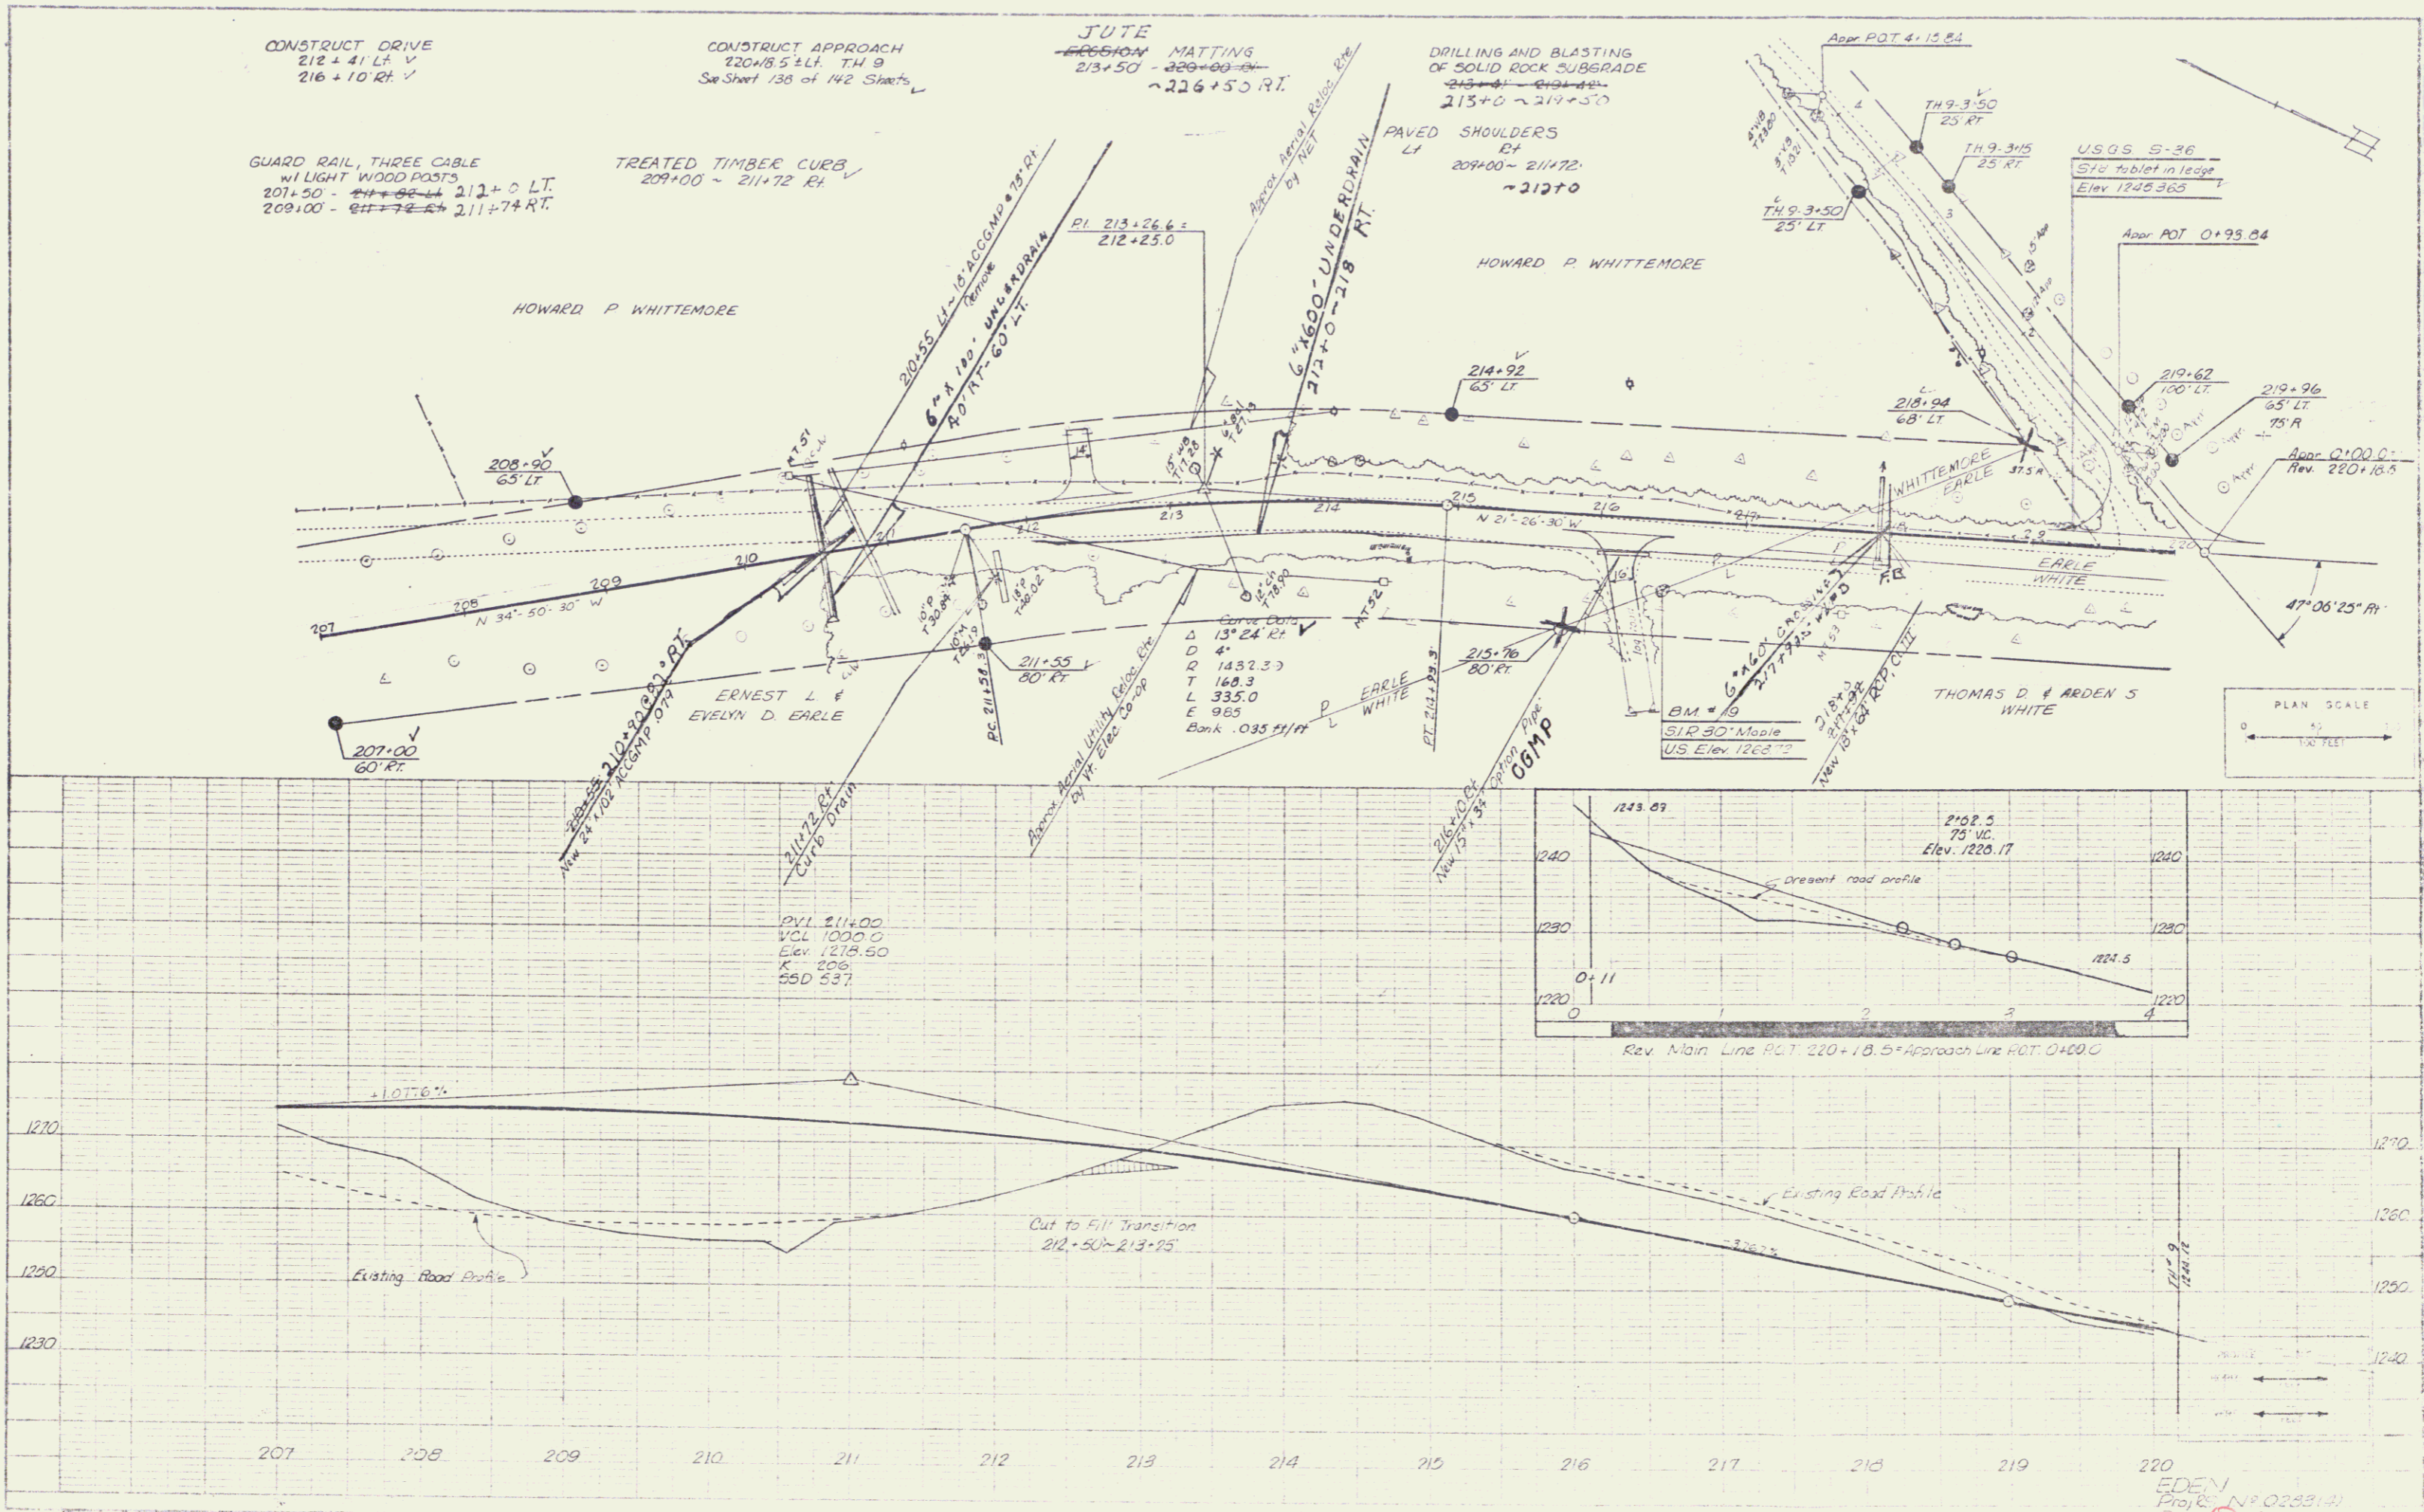

EDEN
 Proj. No. 0223-41
 Sheet 24 of 14 sheets
 12