


PLAN
 1/2" = 100'
 7/8" = 100'
 1" = 100'

PROFILE
 1/4" = 10'
 1/8" = 10'

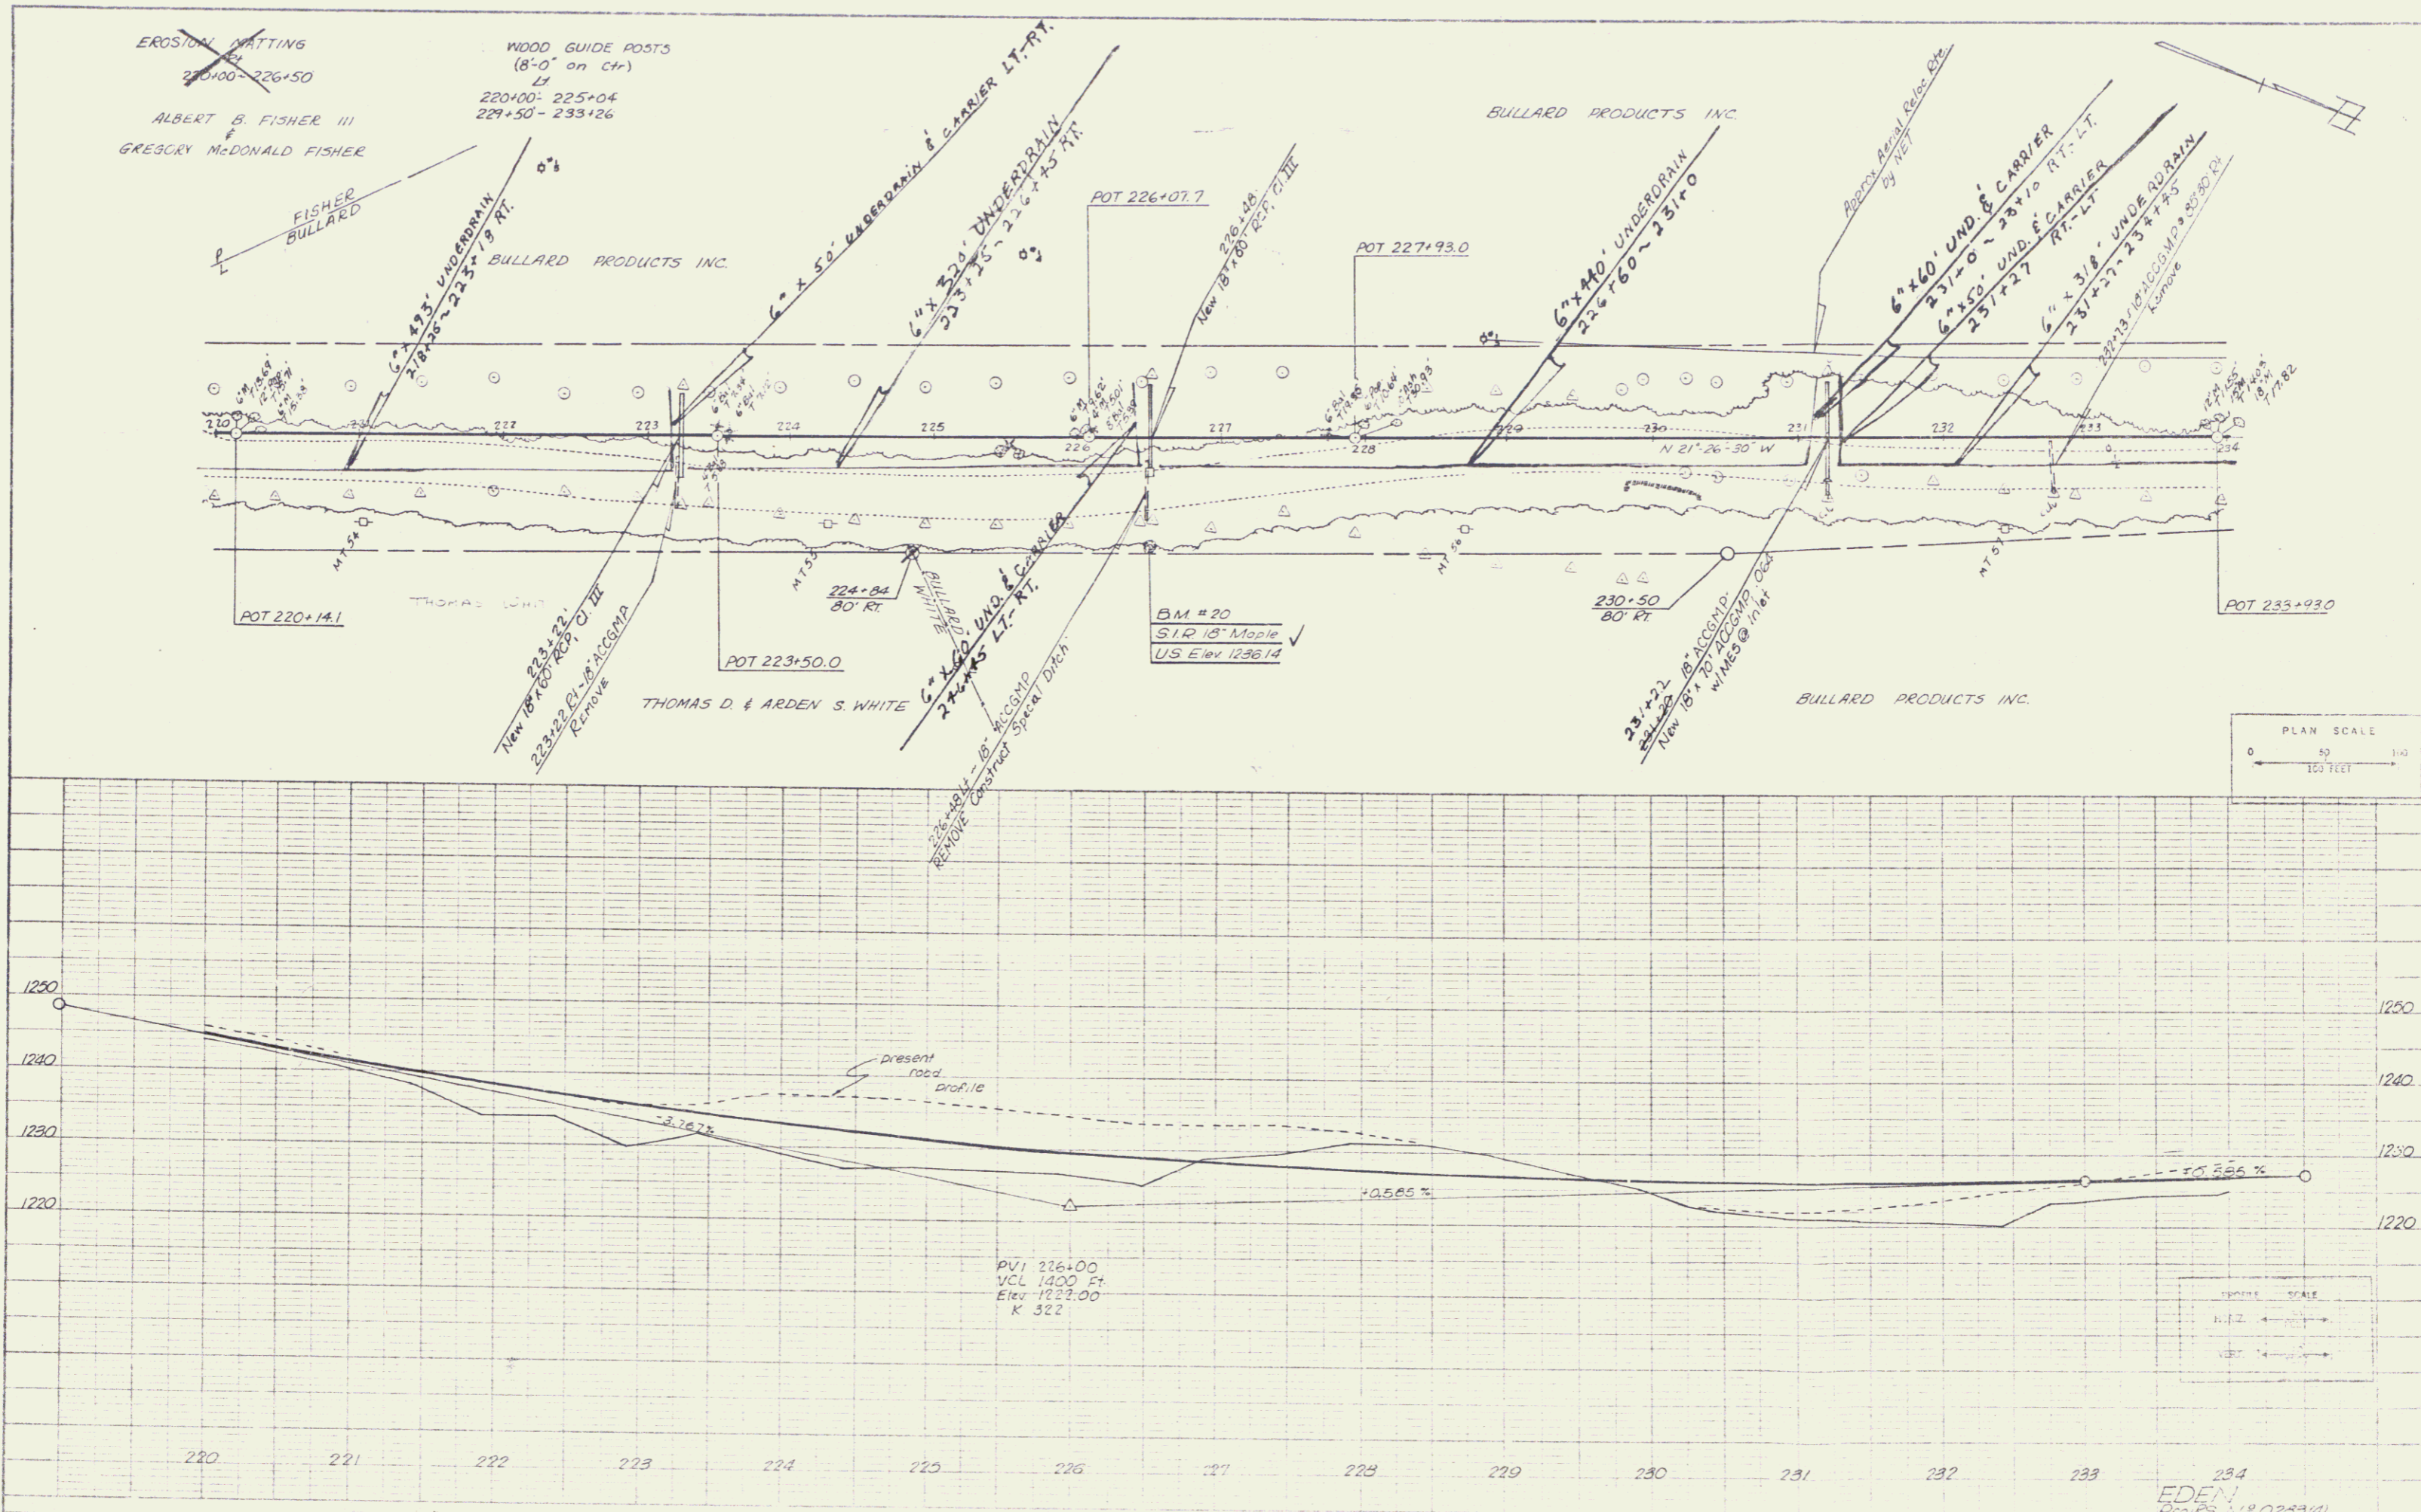

PLAN SCALE
 0 50 100
 1" = 100'

VERTICAL SCALE
 1/4" = 10'
 1/8" = 10'

EDEN
 Proj. RS 19 0233(4)
 Sheet 35 of 12 Sheets