


~~DRAWINGS AND BLASTING
OF SOLID ROCK SUBGRADE
248+00 - 252+44~~

PLAN
 DRAWN BY: [Signature]
 CHECKED BY: [Signature]
 DATE: 11/15/66
 PROJECT: EDEN
 SHEET: 27 OF 142

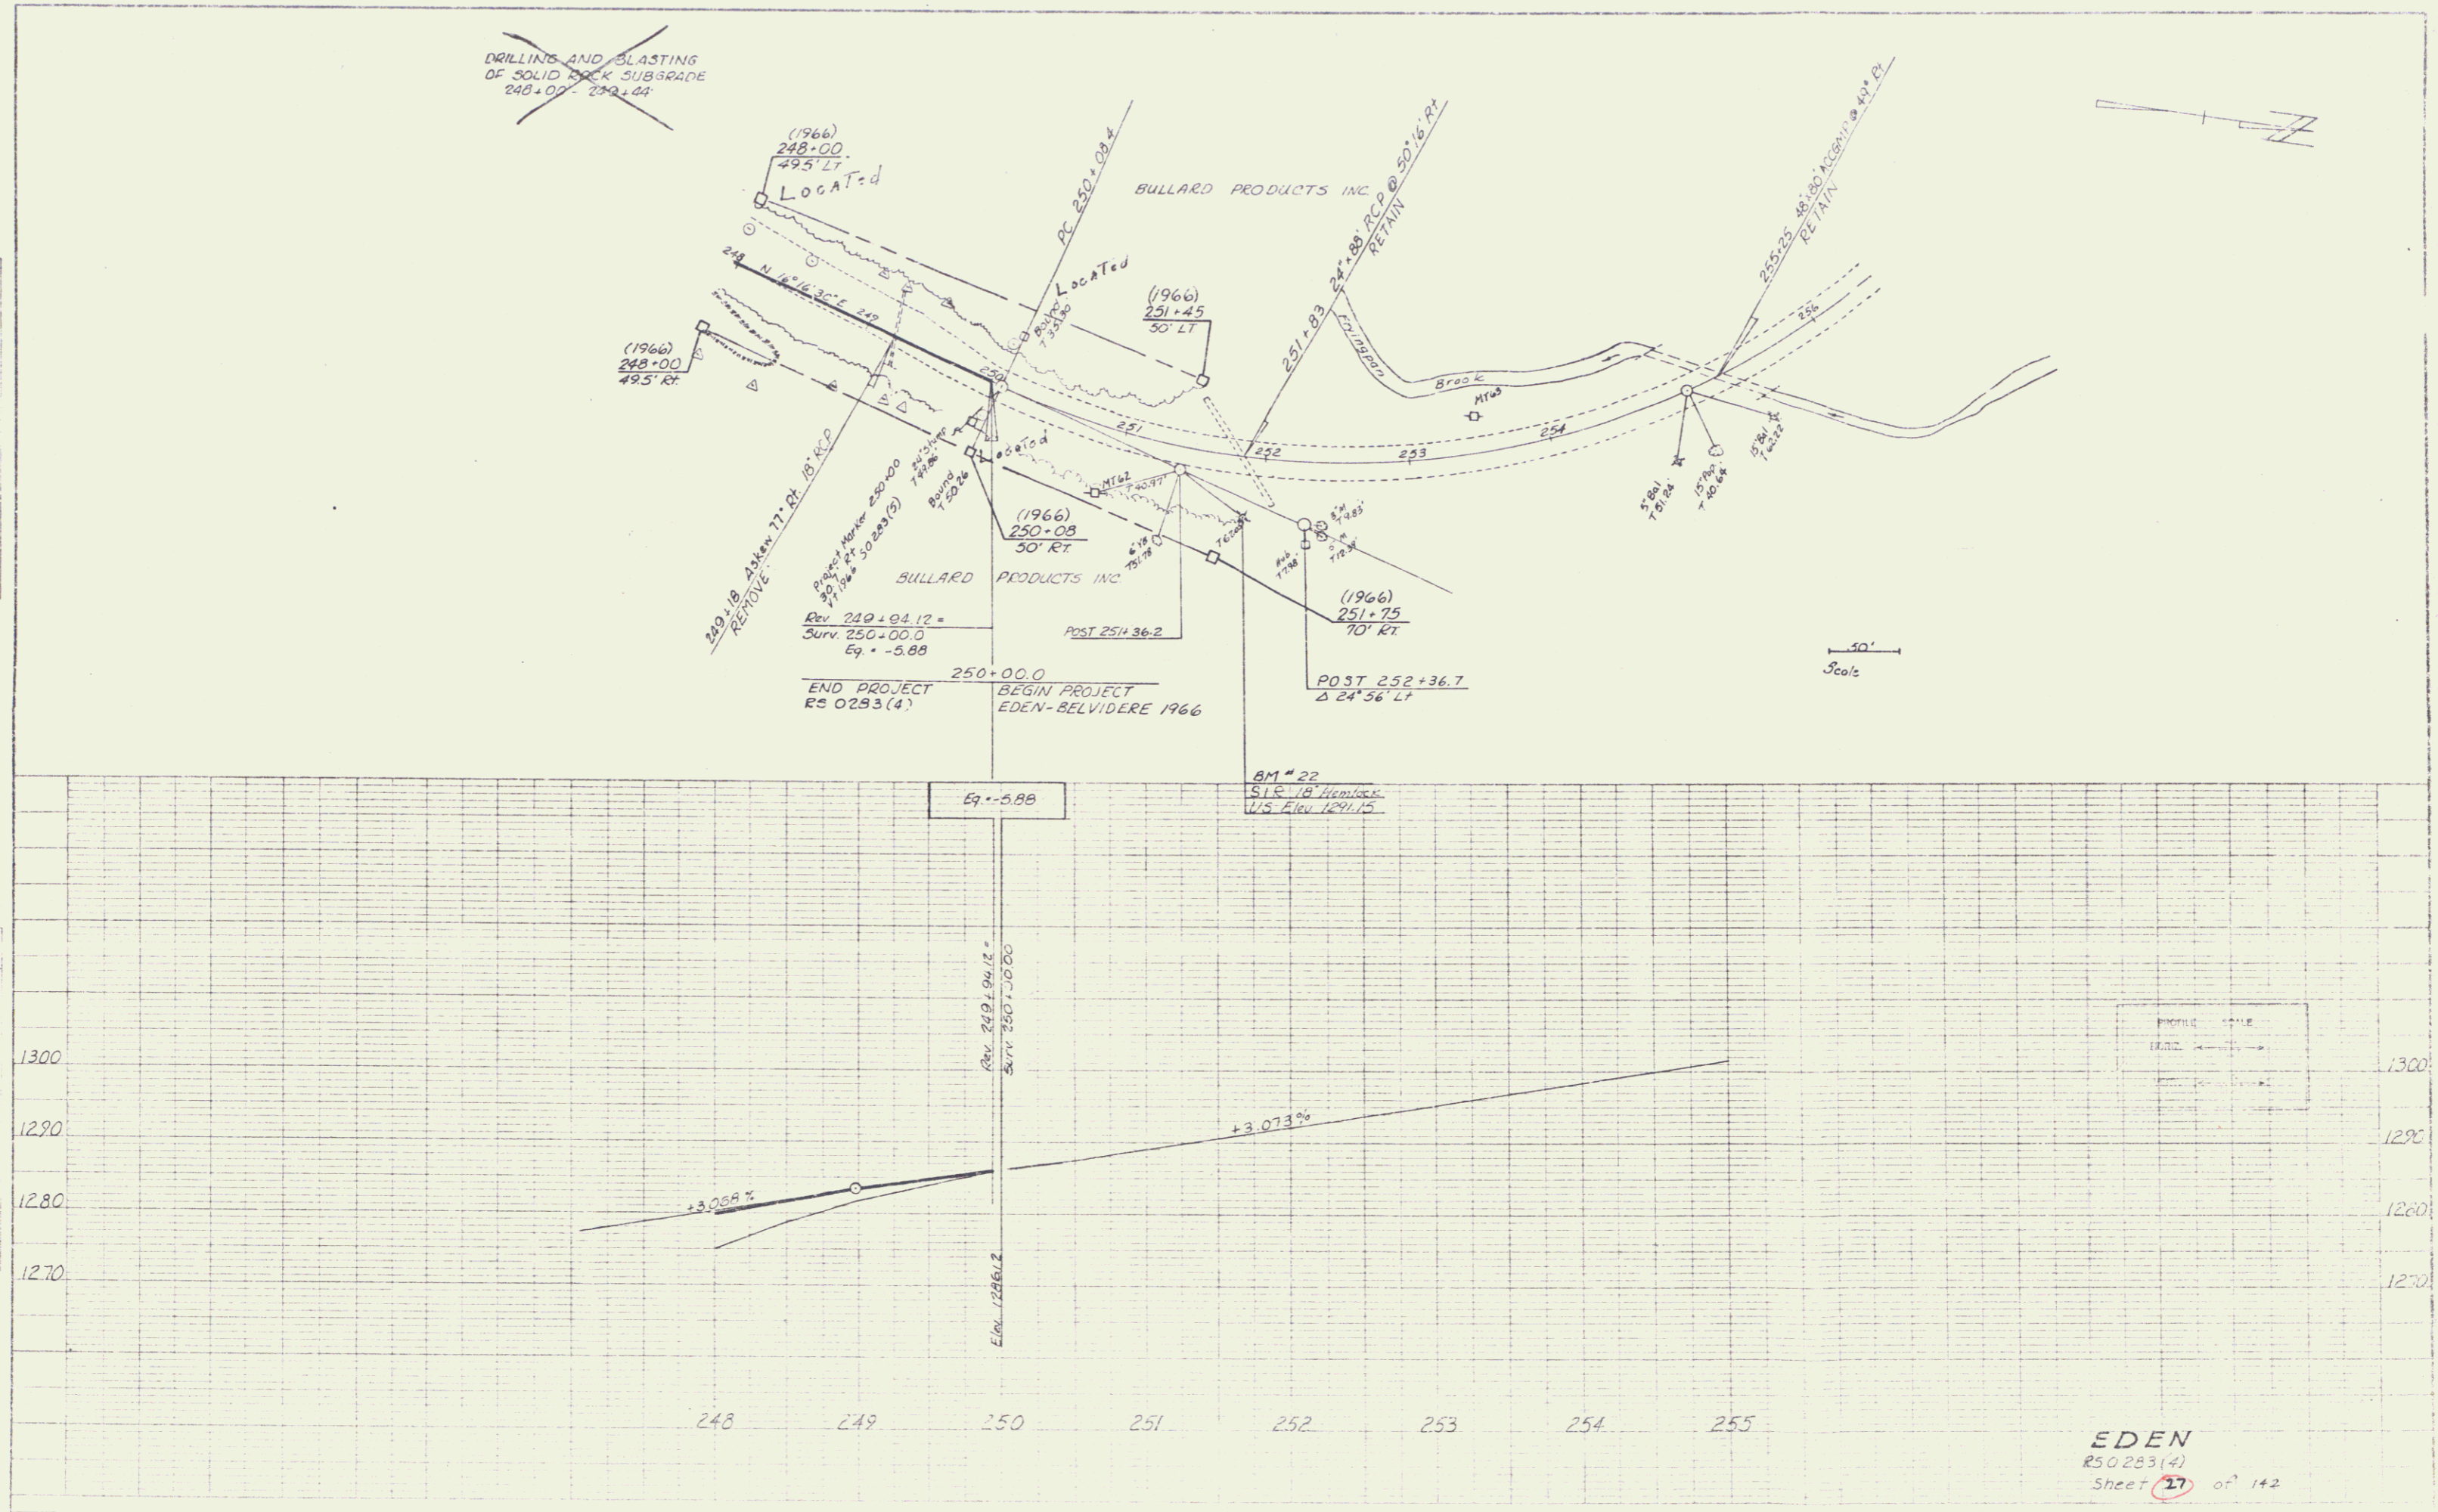

EDEN
 R50 283(4)
 Sheet 27 of 142