


POOR ORIGINAL COPY

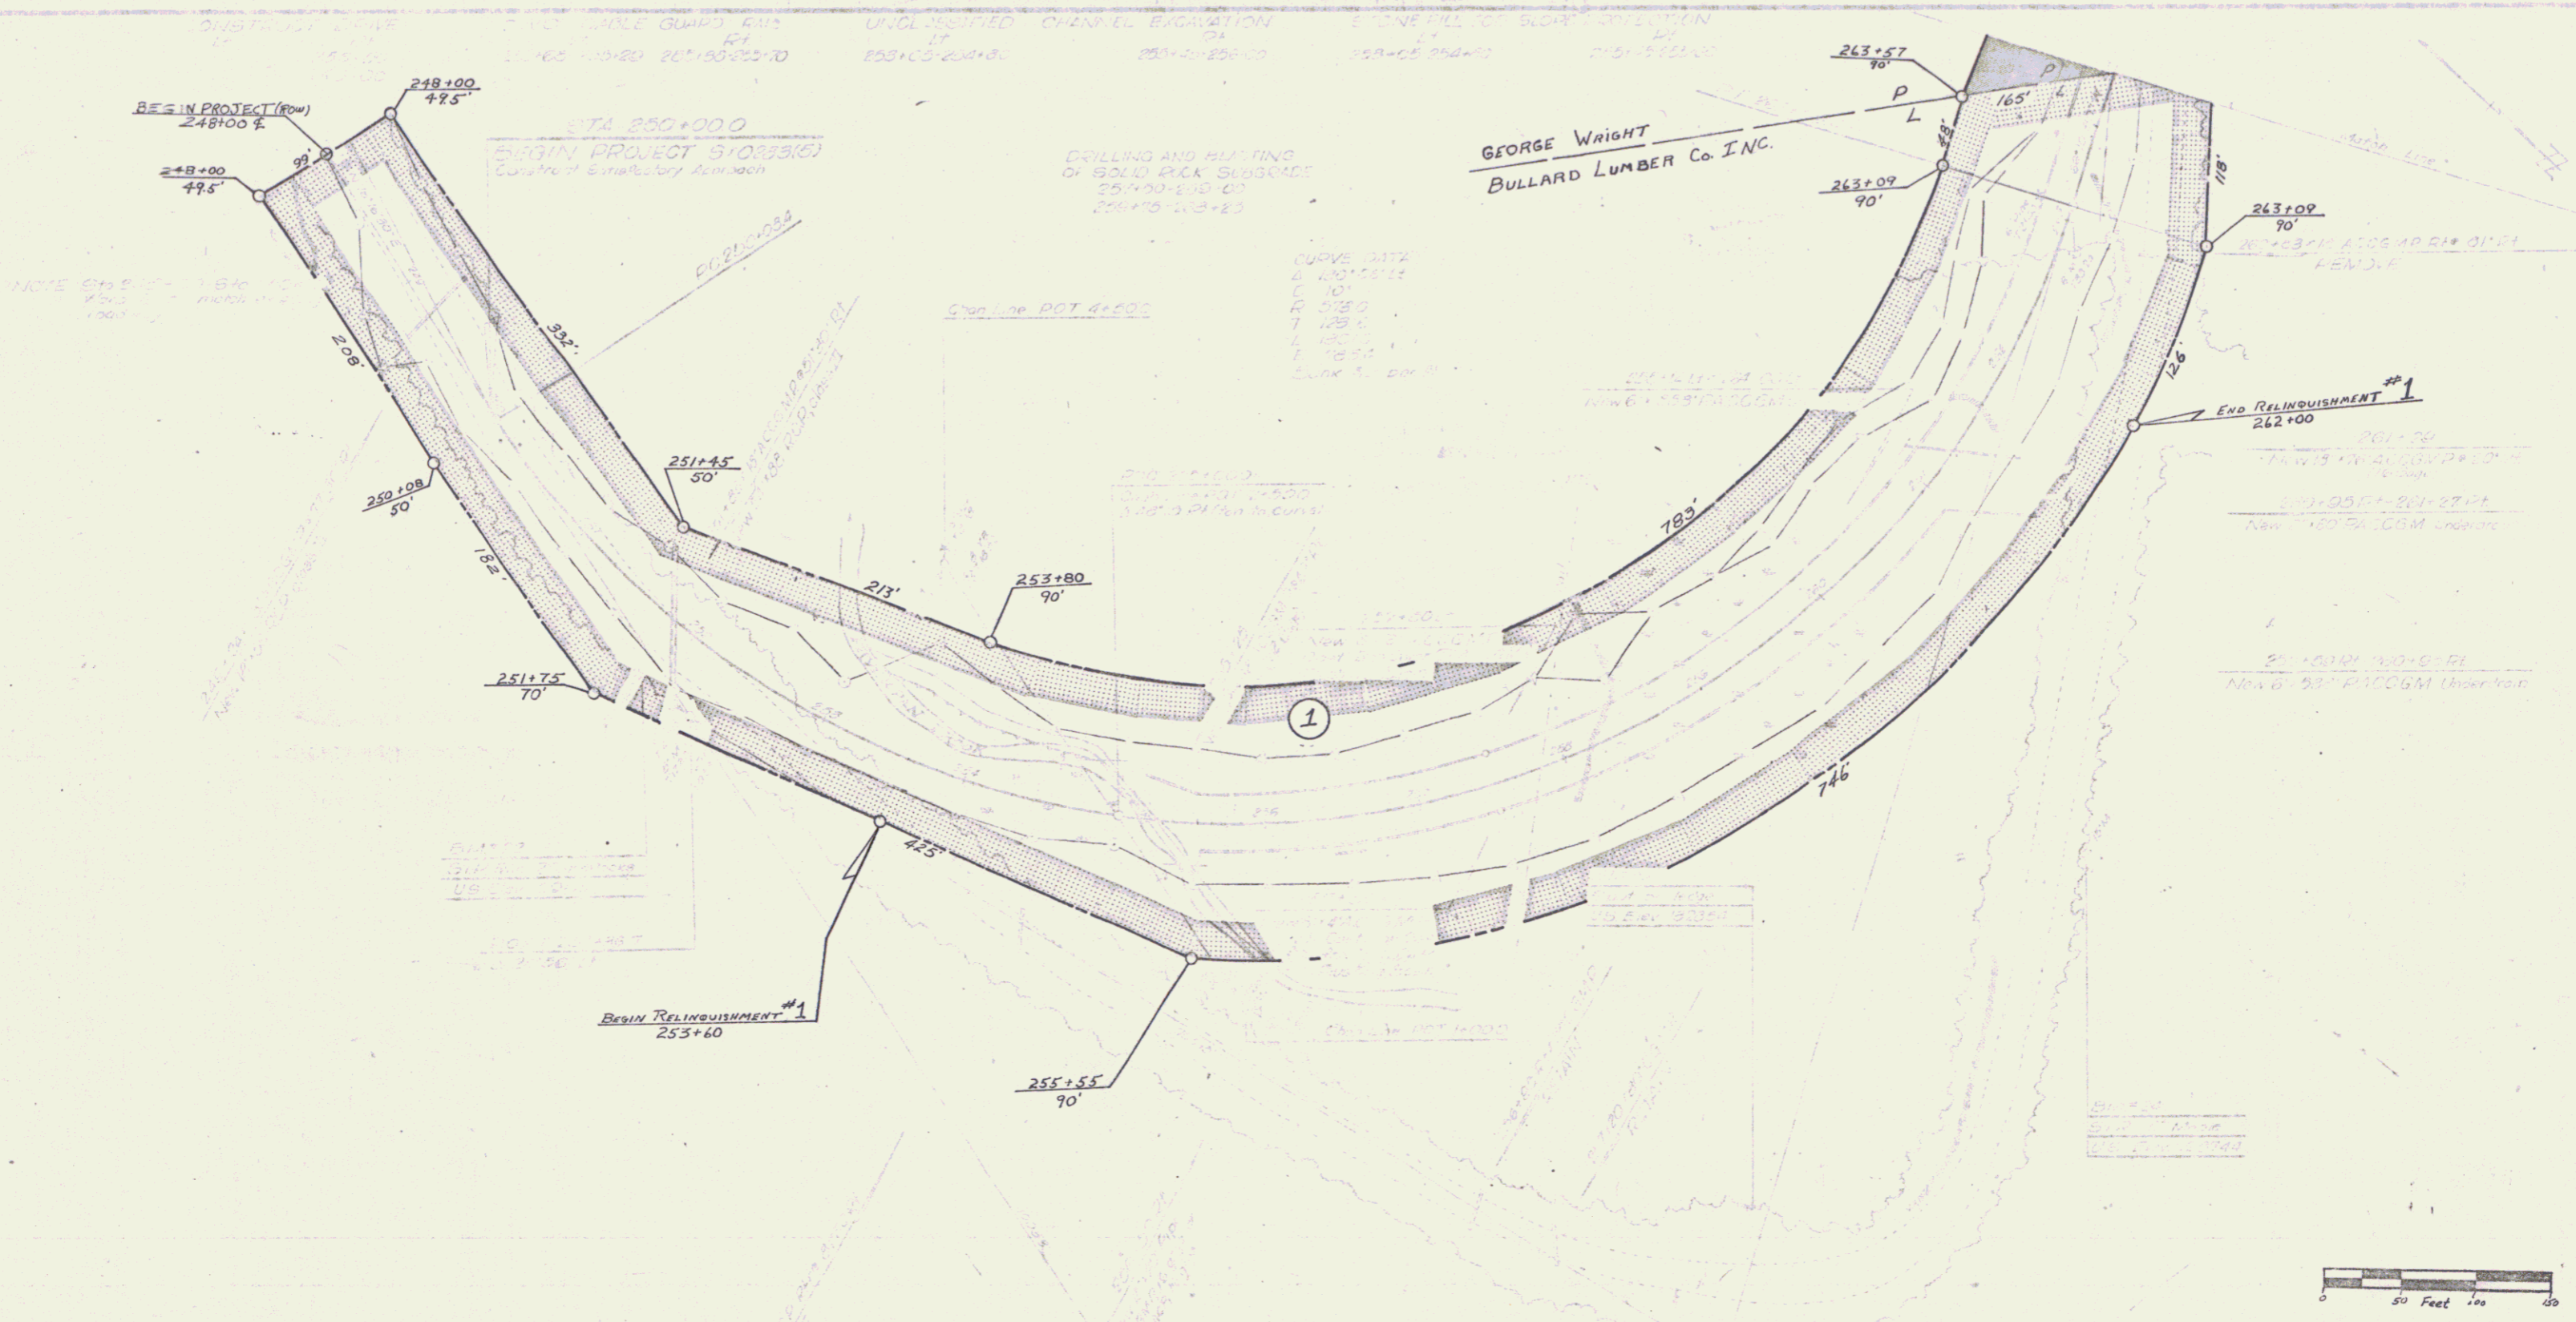

VERMONT DEPARTMENT OF HIGHWAYS
 RIGHT - OF - WAY PLANS
 PROJECT: EDEN - BELVIDERE
 No. S0283 (5)
 SHEET 6 OF 13

SHEET 25A