


POOR ORIGINAL COPY

State of Vt to
Peter O. Wright by ACS
dated 5/19/67
recorded - Eden Bk? P5?

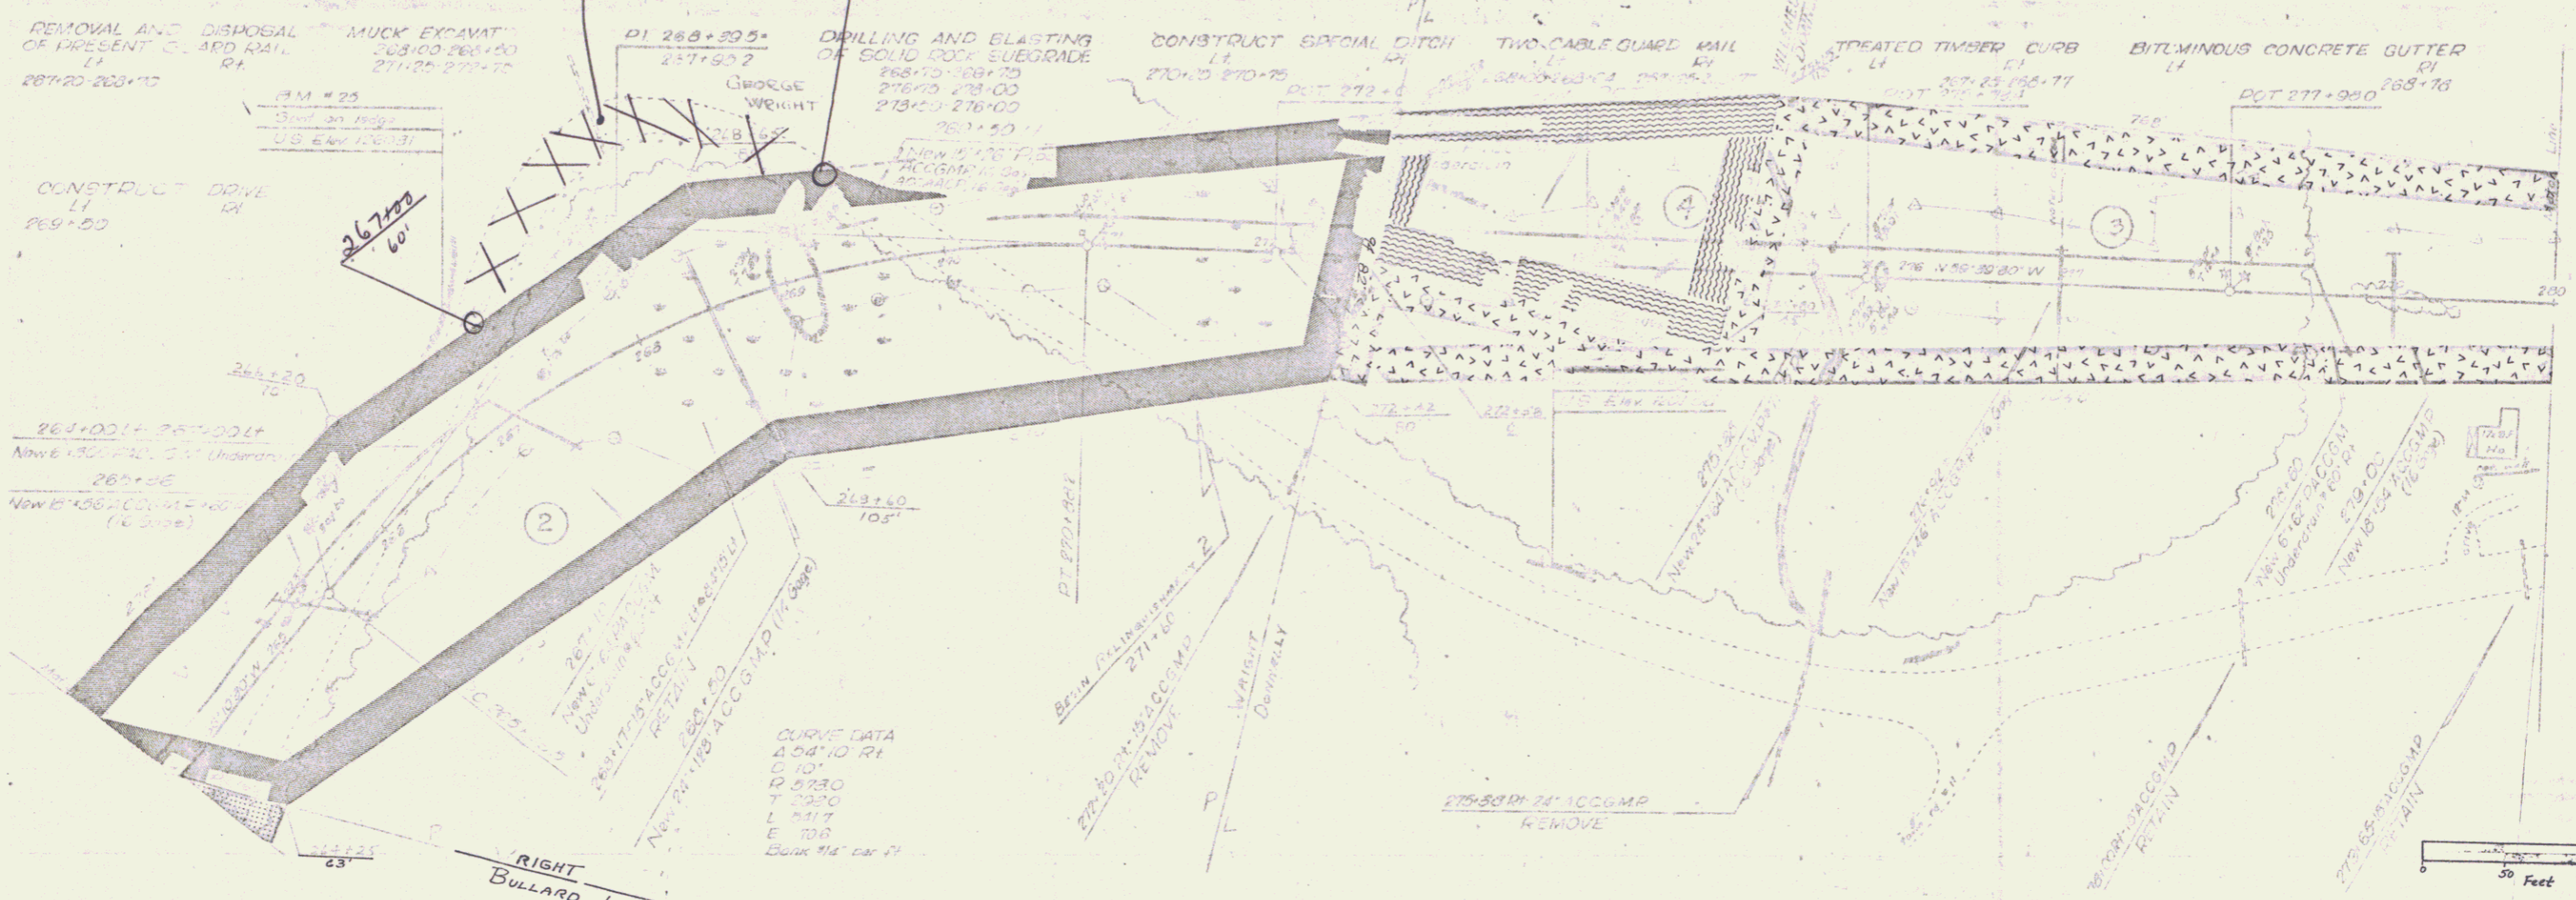

VERMONT DEPARTMENT OF HIGHWAYS
 RIGHT-OF-WAY PLANS
 PROJECT: EDEN - BELVIDERE
 No. S 0283 (5)
 SHEET 7 OF 13

SHEET 27A

6