
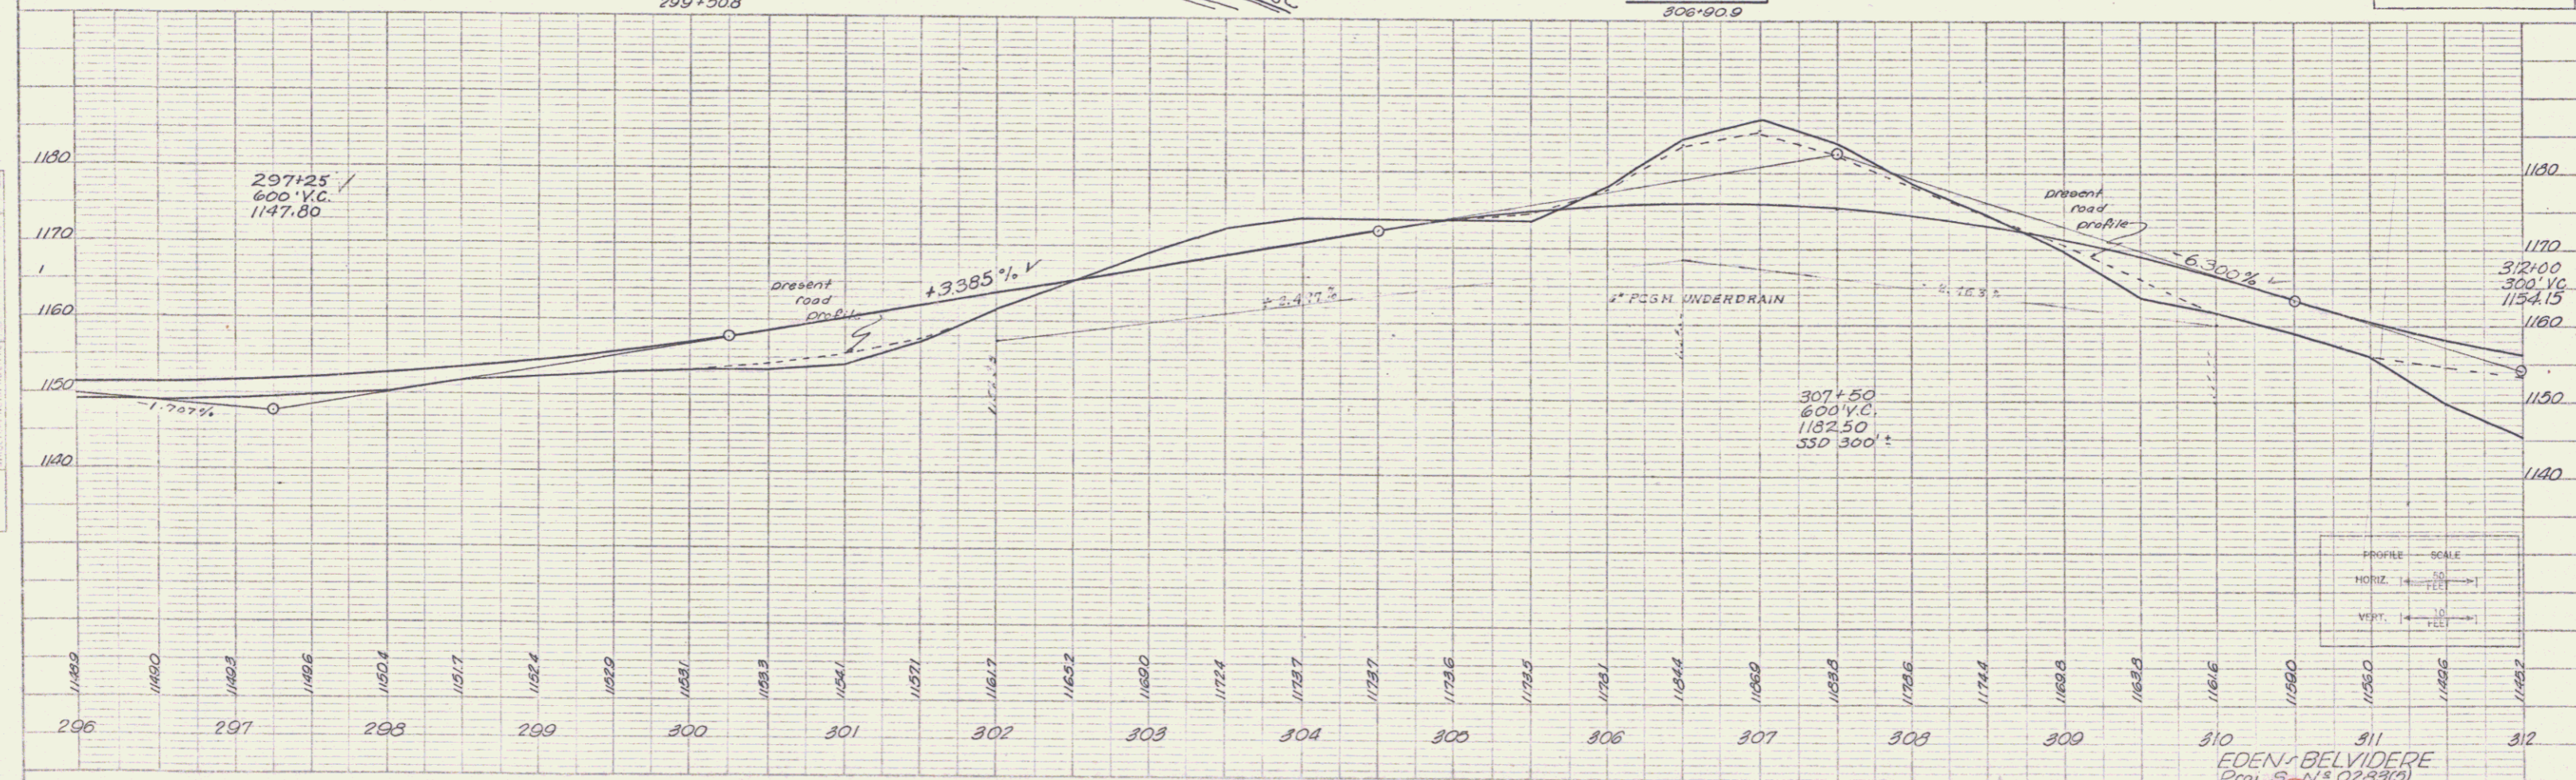


POOR ORIGINAL COPY

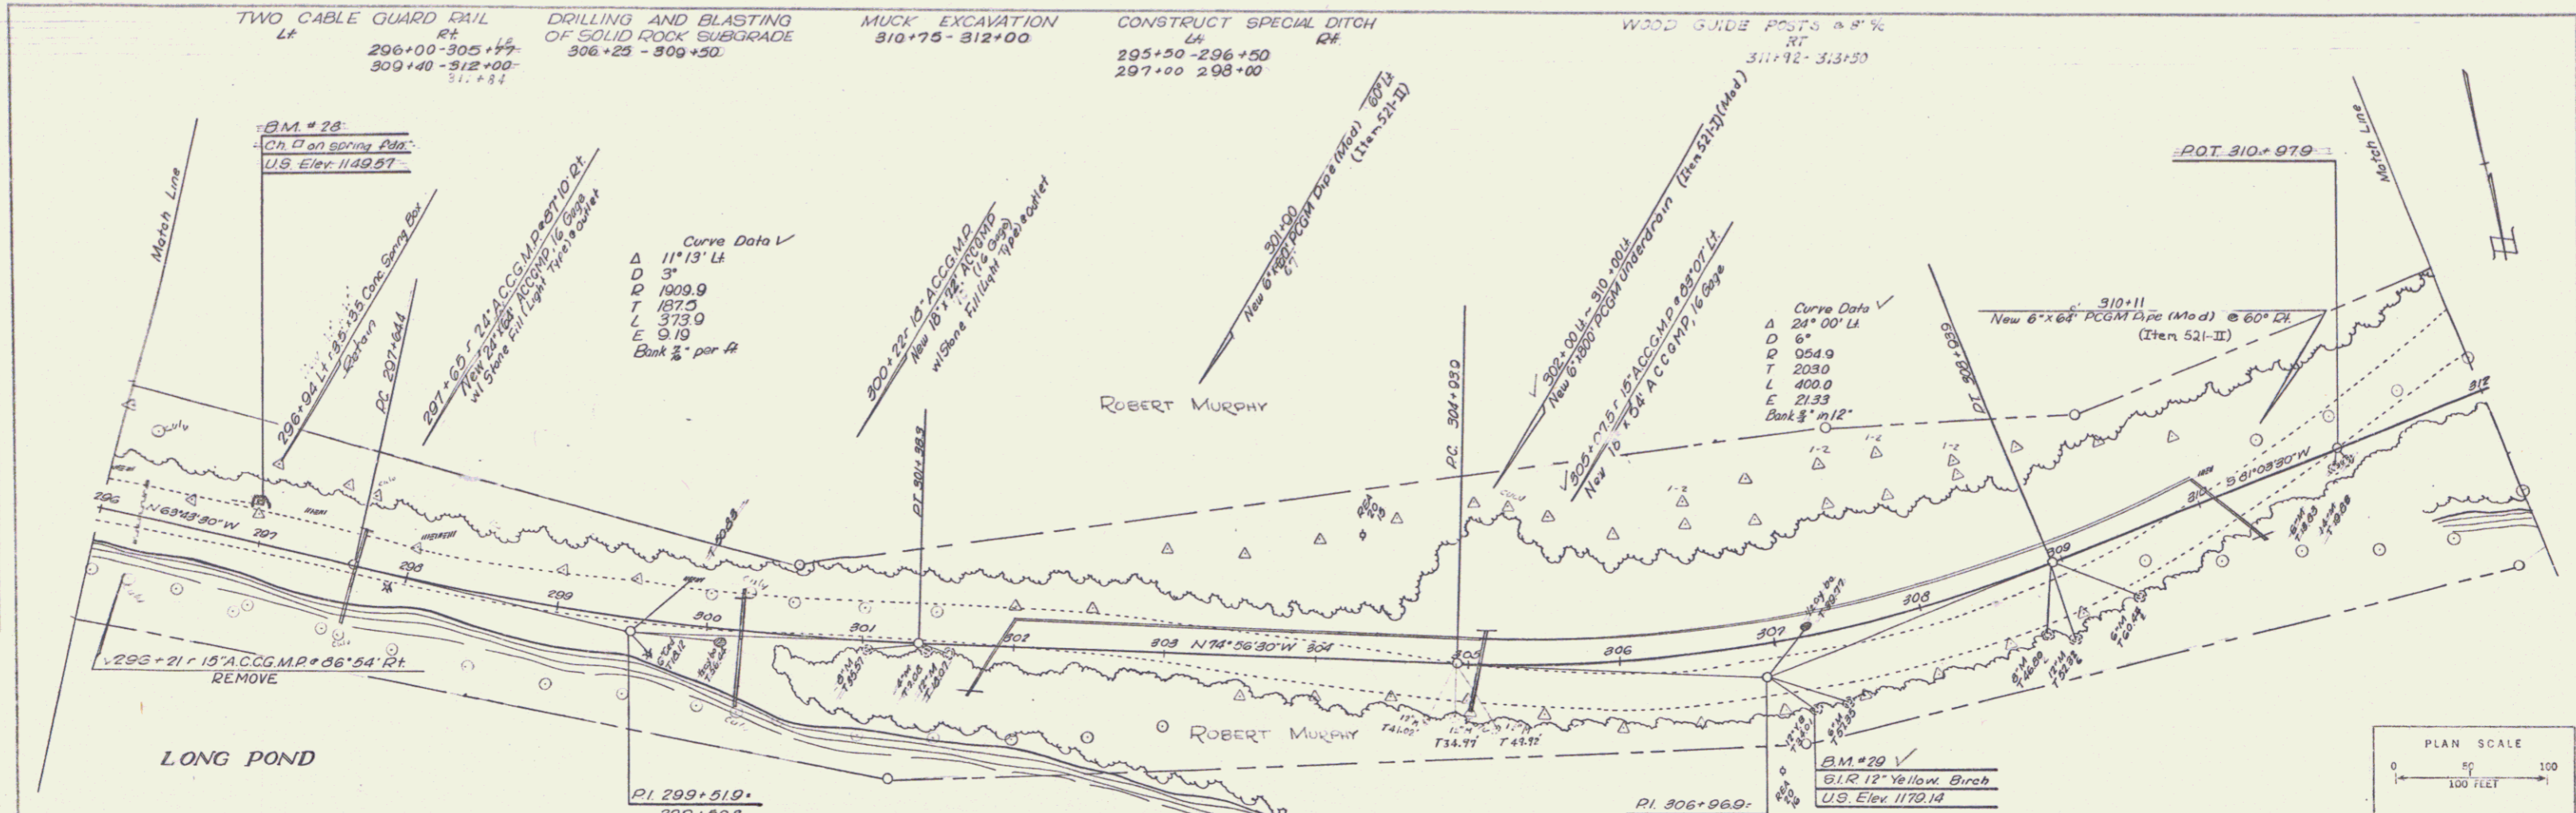

PLAN
 DATE: 10-27-52
 DRAWN BY: Valerius Larshen
 CHECKED BY: G. J. ...
 PROJECT: ...

PROFILE
 DATE: 1-15-53
 DRAWN BY: G. J. ...
 CHECKED BY: ...
 PROJECT: ...

EDEN-BELVIDERE
 Proj. S. 13 0233(0)
 Sheet 20 of 26 Sheets