

POOR ORIGINAL COPY

MUCK EXCAVATION  
312+00 - 312+50  
312+50 - 312+75

TWO CABLE GUARD RAIL  
315+11 - 315+50  
312+00 - 310+04  
308+61 - 308+80

CONSTRUCT TURNOUT  
314+25 - 315+25

CONSTRUCT DRIVE  
317+00

Incr. DI 320+00.5  
315+70.6


POST 322+0.10  
4 10' 0" 14

686'

MURPHY BARRY 895' for MURPHY

LONG POND

CURVE DATA  
A 28' 00" 20' 01"  
C 6'  
D 6643  
T 20' 0"  
L 6' 00"  
E 0' 06"  
Conv. 11" in 12'

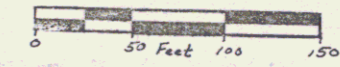

VERMONT DEPARTMENT OF HIGHWAYS  
EDEN - BELVIDERE  
PROJECT - EDEN - BELVIDERE  
NO. S 0283 (5)  
SHEET 10 OF 13

SHEET 30A