

INDEX EXCAVATION
326+51 - 331+00

326+10
144'

326+75
160'

70'

220+00
140'

732'

9

POT 333+84

335+25
85'



928'

5B

1062'

5C


852'

POT 337+025

DATE: 5/27/70
BY: J. J. [unclear]
Elev. 114.70'

331+25
M.P. 331+25
P.L. 331+25

331+72
M.P. 331+72
P.L. 331+72

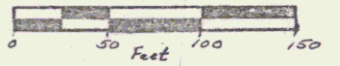

END RELINQUISHMENT #4 BEGIN RELINQUISHMENT #5
333+50

VERMONT DEPARTMENT OF HIGHWAYS
RIGHT-OF-WAY PLANS
PROJECT: EDEN - BELVIDERE
NO. S 0283(5)
SHEET 11 OF 13

SHEET 31A