
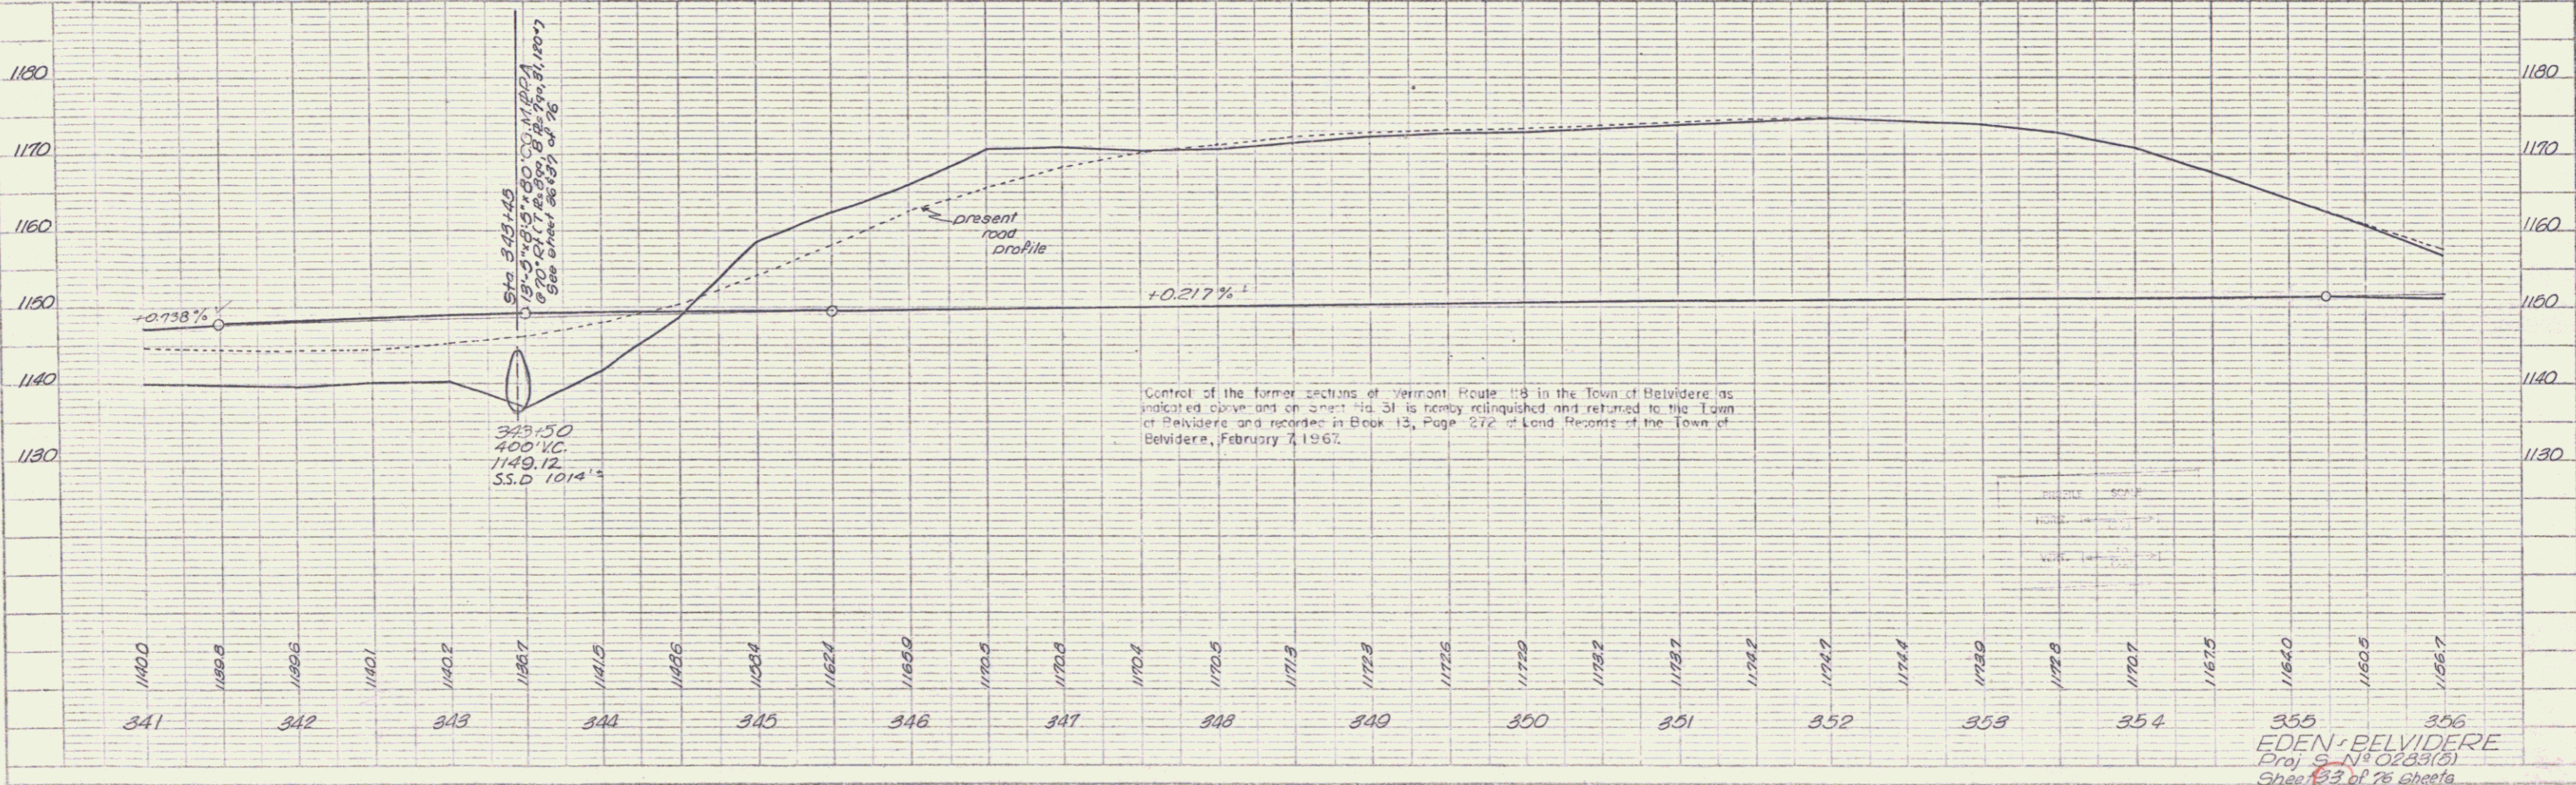


PLAN
 DATE: 10/1/54
 DRAWN BY: [Signature]
 CHECKED BY: [Signature]

PROFILE
 DATE: 10/1/54
 DRAWN BY: [Signature]
 CHECKED BY: [Signature]

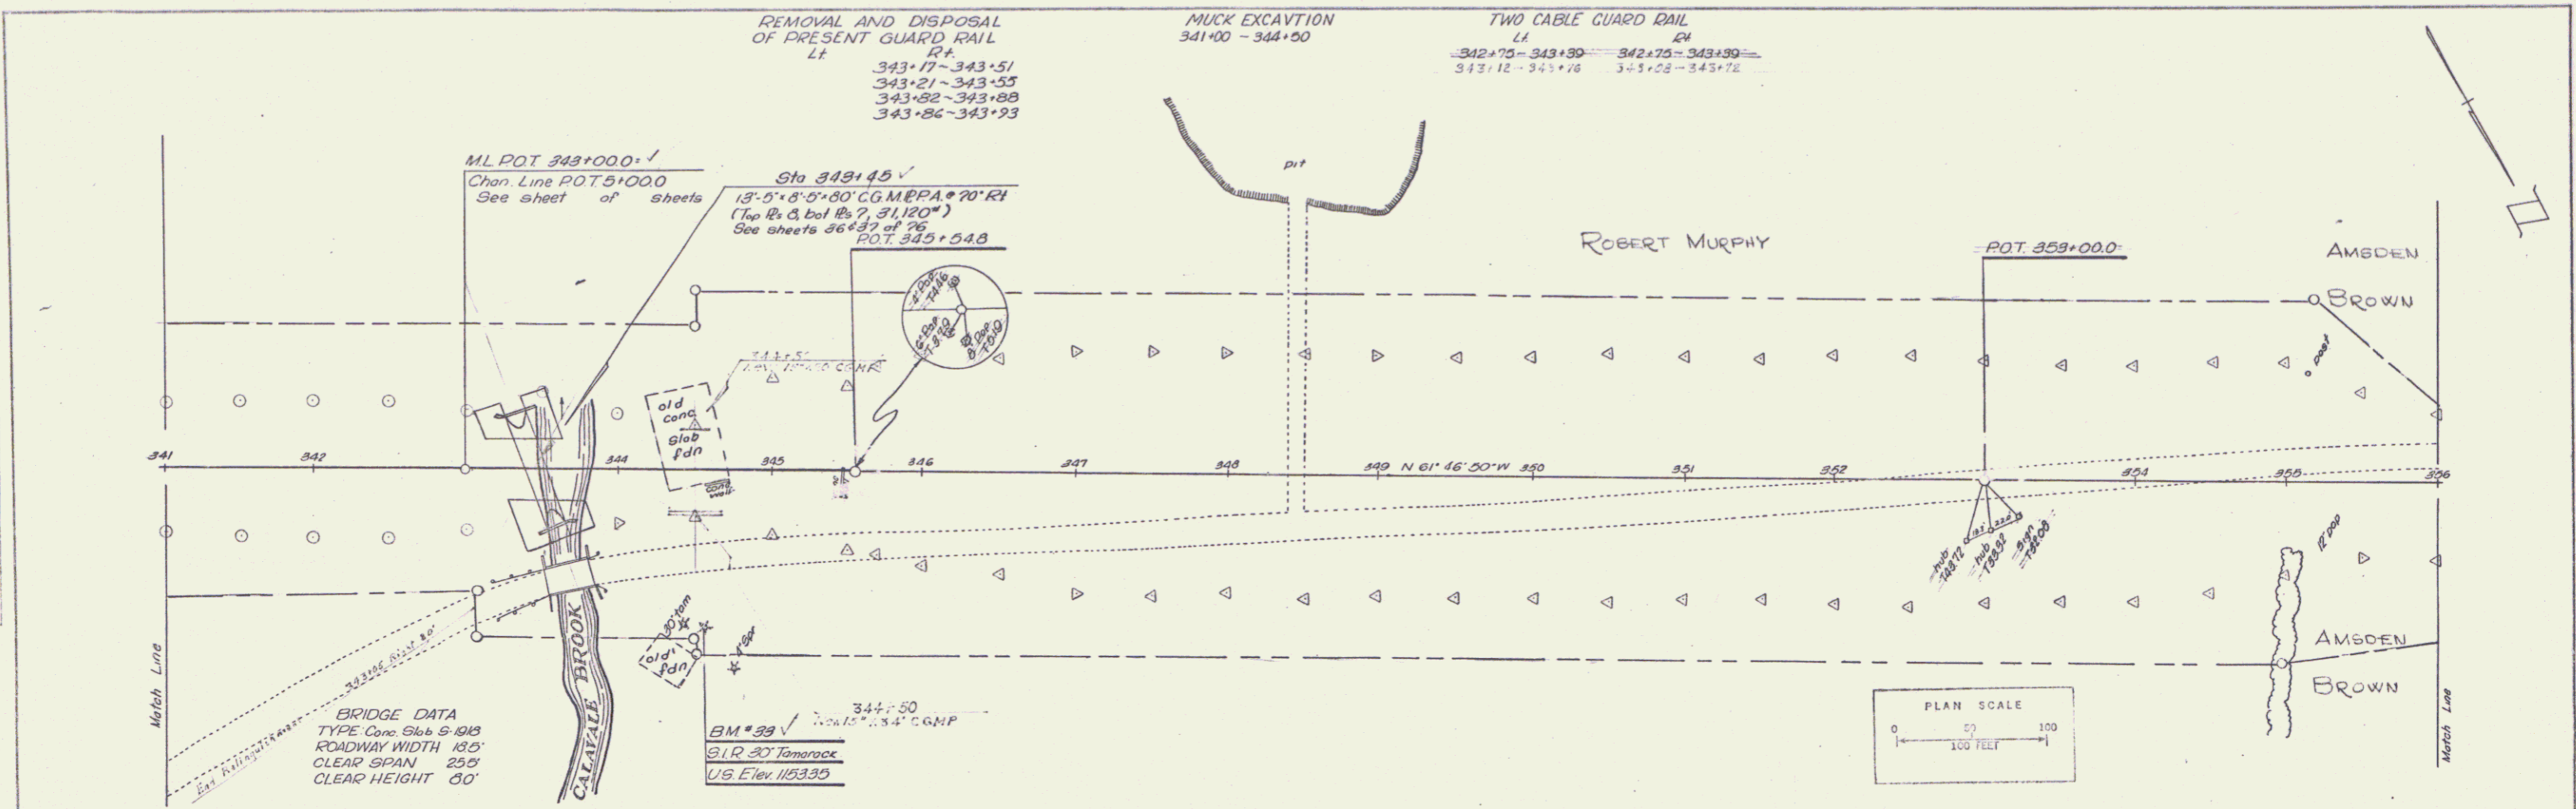

EDEN-BELVIDERE
 Proj. No. N-0233(5)
 Sheet 13 of 75 sheets