


POOR ORIGINAL COPY

MUCK EXCAVATION  
341+00 - 343+00

TWO CABLE GUARD RAIL  
342+70 - 343+30    342+75 - 343+90

ML DOT 342+00.0  
Clear Line DOT 340.00  
See sheet 12 of sheets

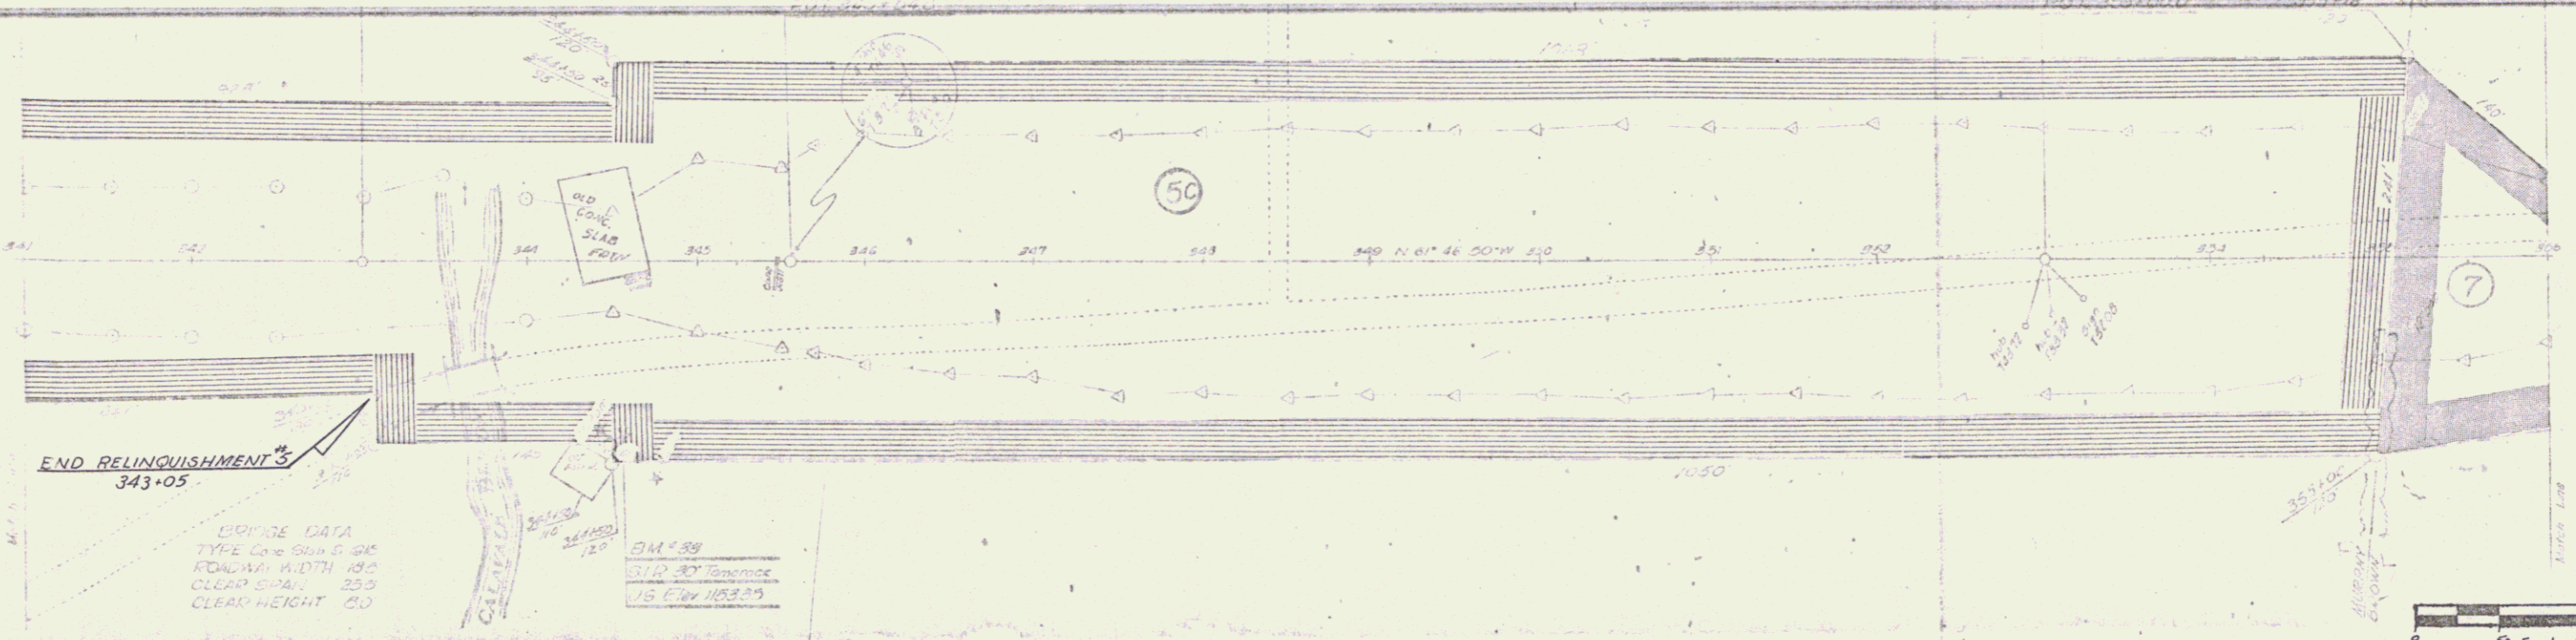

END RELINQUISHMENT  
343+05

BRIDGE DATA  
TYPE Concrete Slab  
ROADWAY WIDTH 18'0"  
CLEAR SPAN 25'0"  
CLEAR HEIGHT 10'0"

E.M. 89  
11'12" 30" Reference  
15' Elev 105.25

VERMONT DEPARTMENT OF HIGHWAYS  
RIGHT-OF-WAY PLANS  
PROJECT EDEN - BELVIDERE  
NO. S 0283 (5)  
SHEET 12 OF 13

SHEET 33A

16