

INDEX OF SHEETS	
SHEET NO. 1	TITLE SHEET
2	TYPICAL CROSS SECTION OF IMPROVEMENT—(BITUMINOUS CONCRETE PAVEMENT, MODIFIED—ITEM 361-B)
3	QUANTITY SHEET (ITEMS & DRAINAGE)
4-6	EARTHWORK SHEETS
7-15	PLAN & PROFILE SHEETS
16	STANDARD SHEET A-61 (DRILLING & BLASTING OF SOLID ROCK SUBGRADE)
17	STANDARD SHEET B-1 (BANKING TABLES)
18	STANDARD SHEET B-5 (TYPICAL SLOPE GRADING)
19	STANDARD SHEET B-6 (MUCK EXCAVATION)
20	STANDARD SHEET B-7 (DRAINAGE IN FILL SECTIONS)
21	STANDARD SHEET B-10 (EMBANKMENT OF SLOPES)
22	STANDARD SHEET D-2 (DRAINAGE)
23	STANDARD SHEET E-1 (BARRICADES, SIGNS & LIGHTS)
24	STANDARD SHEET G-2a (TWO CABLE GUARD RAIL)
25	STANDARD SHEET G-4 (WOOD MARKER POST)
26	STANDARD SHEET J-1 (PROJECT & BOUNDARY MARKERS)
27-68	CROSS SECTION SHEETS
69-70	CURVE BANKING TRANSITIONS

**STATE OF VERMONT
DEPARTMENT OF HIGHWAYS
PROPOSED IMPROVEMENT**

TOWN OF BELVIDERE

COUNTY OF LAMOILLE

VERMONT ROUTE #118

EDEN-MONTGOMERY ROAD


BEGINNING AT APPROXIMATELY 200' EAST OF ROUTE JUNCTION 109/118 AND EXTENDING NORTH FOR A DISTANCE OF 11,420.9 FEET

LENGTH OF PROJECT 11,420.9 FEET = 2.163 MILES

1958 ADT = 145
1980 ADT = 215
1980 DHV = 40
V = 50 MPH
D = 65 %
T = 15 %

PROJECT NAME & NUMBER BELVIDERE S 0283 (1)	TYPE PAVEMENT Bituminous Concrete 29,251 sq. yd.	AREA 29,251 sq. yd.
RECORD PLANS		
MATERIALS		
SUBBASE OF GRAVEL - Burnham Pit, Belvidere, Vt.		
ACCGMETAL PIPE - N.E. Metal Pipe Co., Westminster, Vt.		
REINF. CONC. PIPE - American Marietta Co., Windsor, Vt.		
TWO CABLE GUARD RAIL, WOOD GUIDE & MARKER & BOUNDARY MARKERS - S. T. Griswold Inc., Essex Jct., Vt.		
CUTBACK ASPHALT - Trimount Bituminous Products Co., St. Albans, Vt.		
BIT. CONCRETE PAVEMENT - L.M. Pike & Son, Laconia, N.H.		
CONTRACTOR - L. S. R. Laperle	CONTRACT DATED: Nov. 2, 1960	
90 Main St., St. Johnsbury	STARTED: Nov. 15, 1960	
RES. ENG'R - H. J. Washer	COMPLETED: Nov. 3, 1961	
RECORD PLANS - T. Kambour	ACCEPTED - Nov. 3, 1961	

FED. ROAD DISTRICT NO.	STATE	PROJECT NO.	FISCAL YEAR	SHEET NO.	TOTAL SHEETS
1	VT	S-0283(1)	1960	1	70

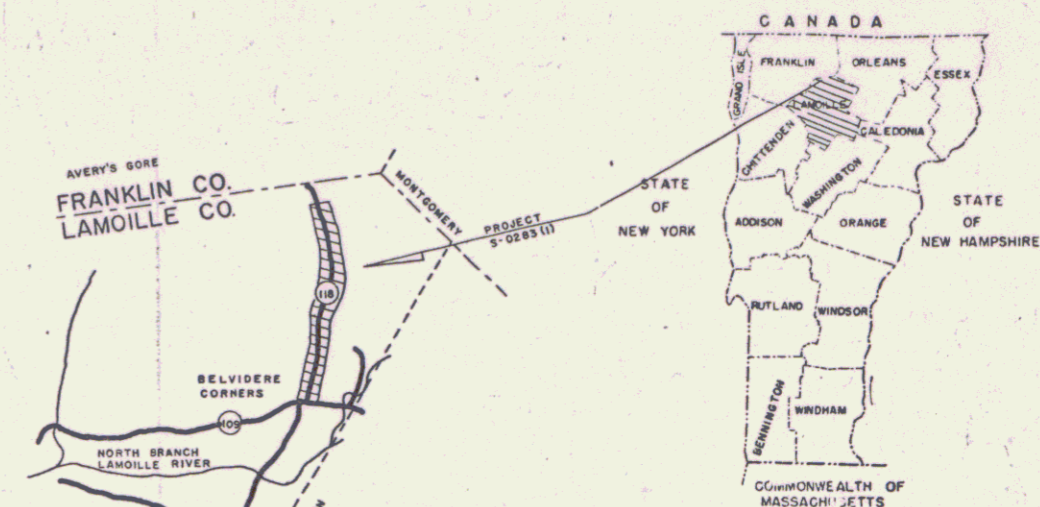

MP 0.476
355+000 V
BEGIN PROJECT
S-0283 (1)



B.M. BASED ON U.S.G.S. B.M. #6 VT. 1922 LOCATED AT BELVIDERE CORNERS, 550 FT. WEST OF CROSSROADS; 100 FT. NORTH OF CENTER OF ROAD; 70 FT. WEST OF PIT; IN ROCK LEDGE, ELEV. 1197.674

STA. 355+00 - STA. 470+00
CONSTRUCTION AREA

RIGHT-OF-WAY DIVISION
TOWN FILE
PERPETUAL
Town of U-118
(To Be Returned To R.O.W. Division)

CONTRACT NO. 2.163
PROJECT S 0283 (1)
118th BITUMINOUS CONCRETE PAVEMENT
MODIFIED—ITEM 361-B
CONTRACTORS—LEO & ROLAND LAPERLE
ST. JOHNSBURY, VT.
LOCATION BEGINNING APPROXIMATELY 200' EAST OF ROUTE JUNCTION 109 & 118 AND EXTENDING NORTH FOR A DISTANCE OF 11,420.9 FEET
1320 60x16

CONTRACTOR	LEO & ROLAND LAPERLE
ENGINEER	H. J. WASHER
RECORD PLANS	T. KAMBOUR
DATE	NOV. 3, 1961

DATE	LINE
DATE	LINE

TITLE	SCALE
TYPICAL	1" = 400'
PLAN	1" = 50'
PROFILE	1" = 50'
CROSS-SECTIONS	1" = 5'

NOTE: ANY FURTHER INFORMATION CONCERNING FINAL QUANTITIES, AMOUNTS OR OTHER DETAILS RELATIVE TO THIS PROJECT MAY BE OBTAINED EITHER IN THE FIELD BOOKS OR THE ESTIMATE FILE.

THESE PLANS ARE SUBJECT TO SUCH REVISIONS AS MAY BE REQUIRED BY THE BUREAU OF PUBLIC ROADS OR THE COMMISSIONER OF HIGHWAYS.
CONSTRUCTION IS TO BE CARRIED ON IN ACCORDANCE WITH THE PLANS AND THE STANDARD SPECIFICATIONS FOR HIGHWAY AND BRIDGE CONSTRUCTION OF JANUARY 1956 SUBMITTED TO THE BUREAU OF PUBLIC ROADS AS APPROVED JULY 5, 1956, INCLUDING ALL SUBSEQUENT APPROVED REVISIONS AND SUCH REVISED SPECIFICATIONS AND SPECIAL PROVISIONS AS ARE SUBMITTED WITH THE PLANS.

DEPARTMENT OF COMMERCE
BUREAU OF PUBLIC ROADS
PIN # 00R509

APPROVED DATE <u>Jan 10 1960</u>	APPROVED DATE <u>Jan 18 1960</u>	APPROVED DATE <u>Jan 12 1960</u>	APPROVED DATE <u>Jan 15 1960</u>	APPROVED DATE <u>3/11/60</u>	APPROVED DATE <u>Dec 22 1960</u>
RECORDING ENGINEER	INSPECTOR	BRIDGE ENGINEER	DISTRICT ENGINEER	ENGINEER	CHIEF ENGINEER
PROJECT S NO. 0283 (1)					
SHEET 1 OF 70 SHEETS					