
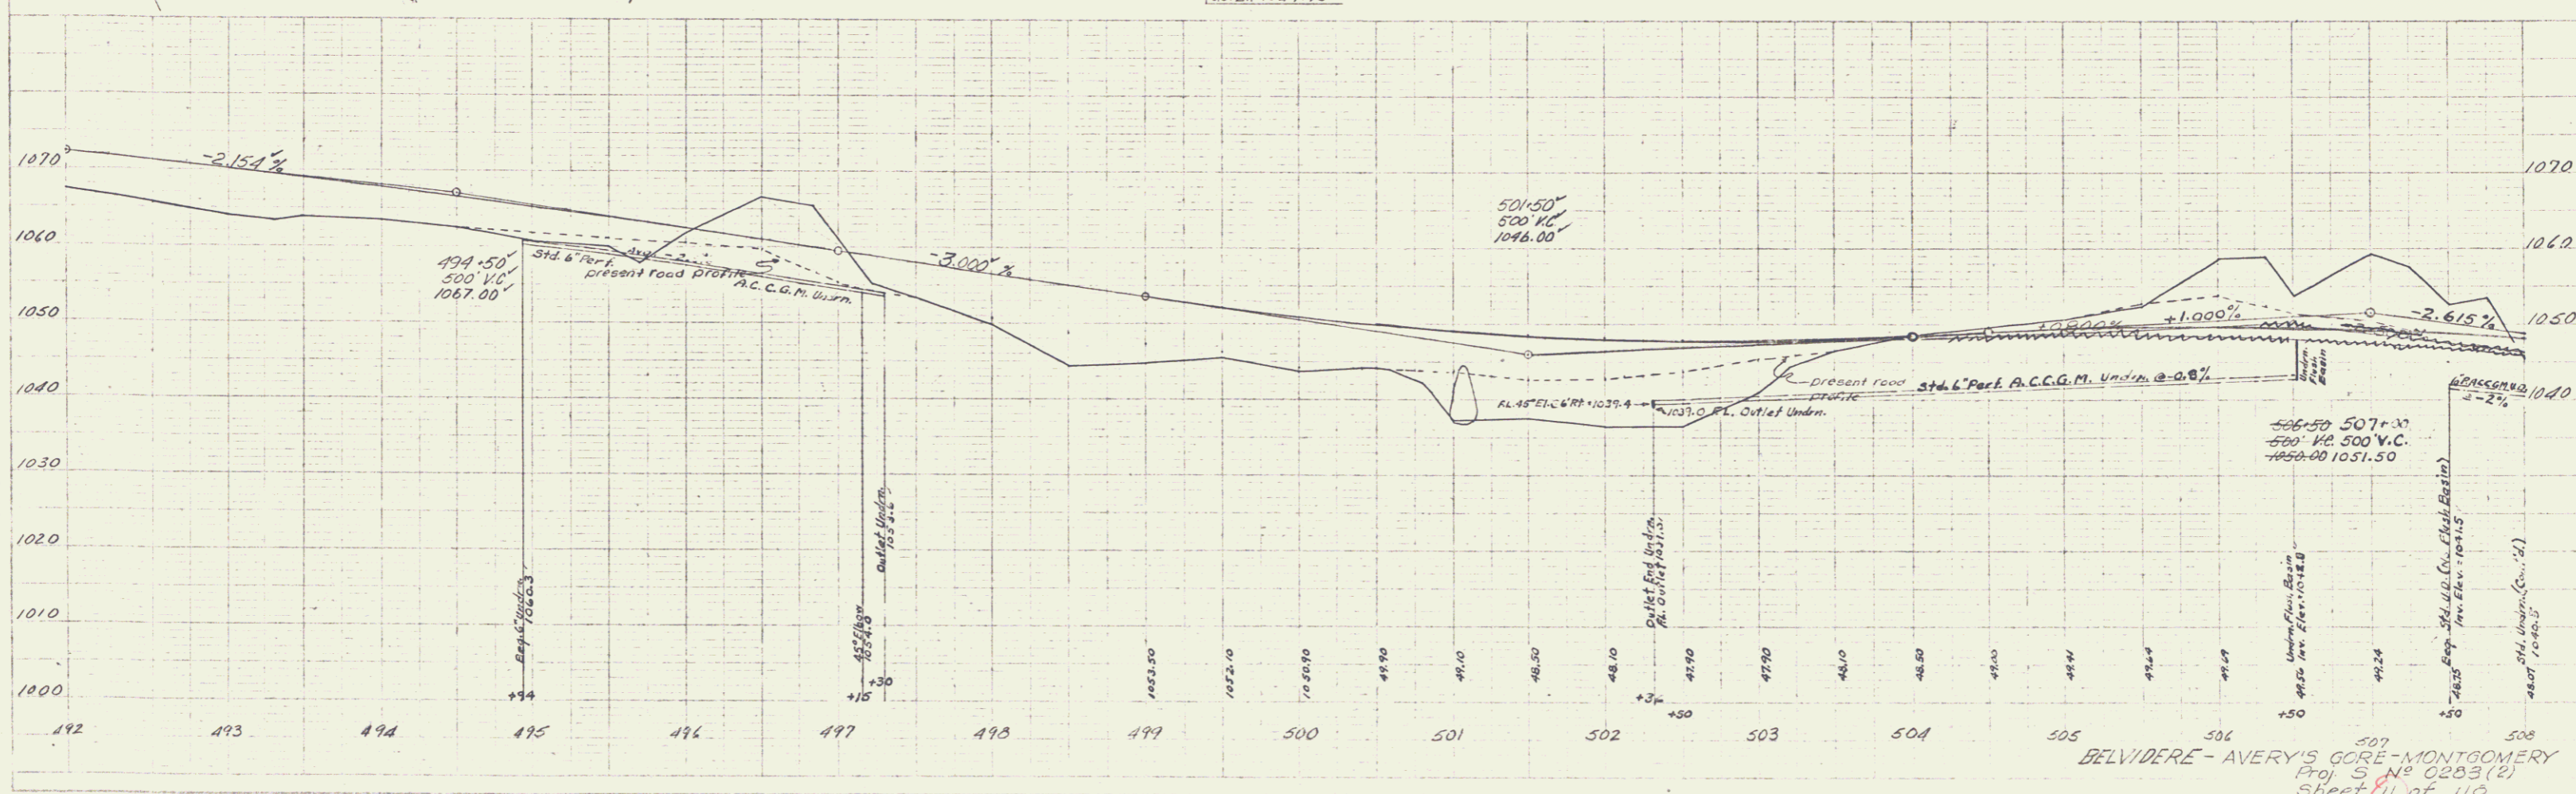


W. H. WEAVER, 1/25
 11/59
 M. General 2/59

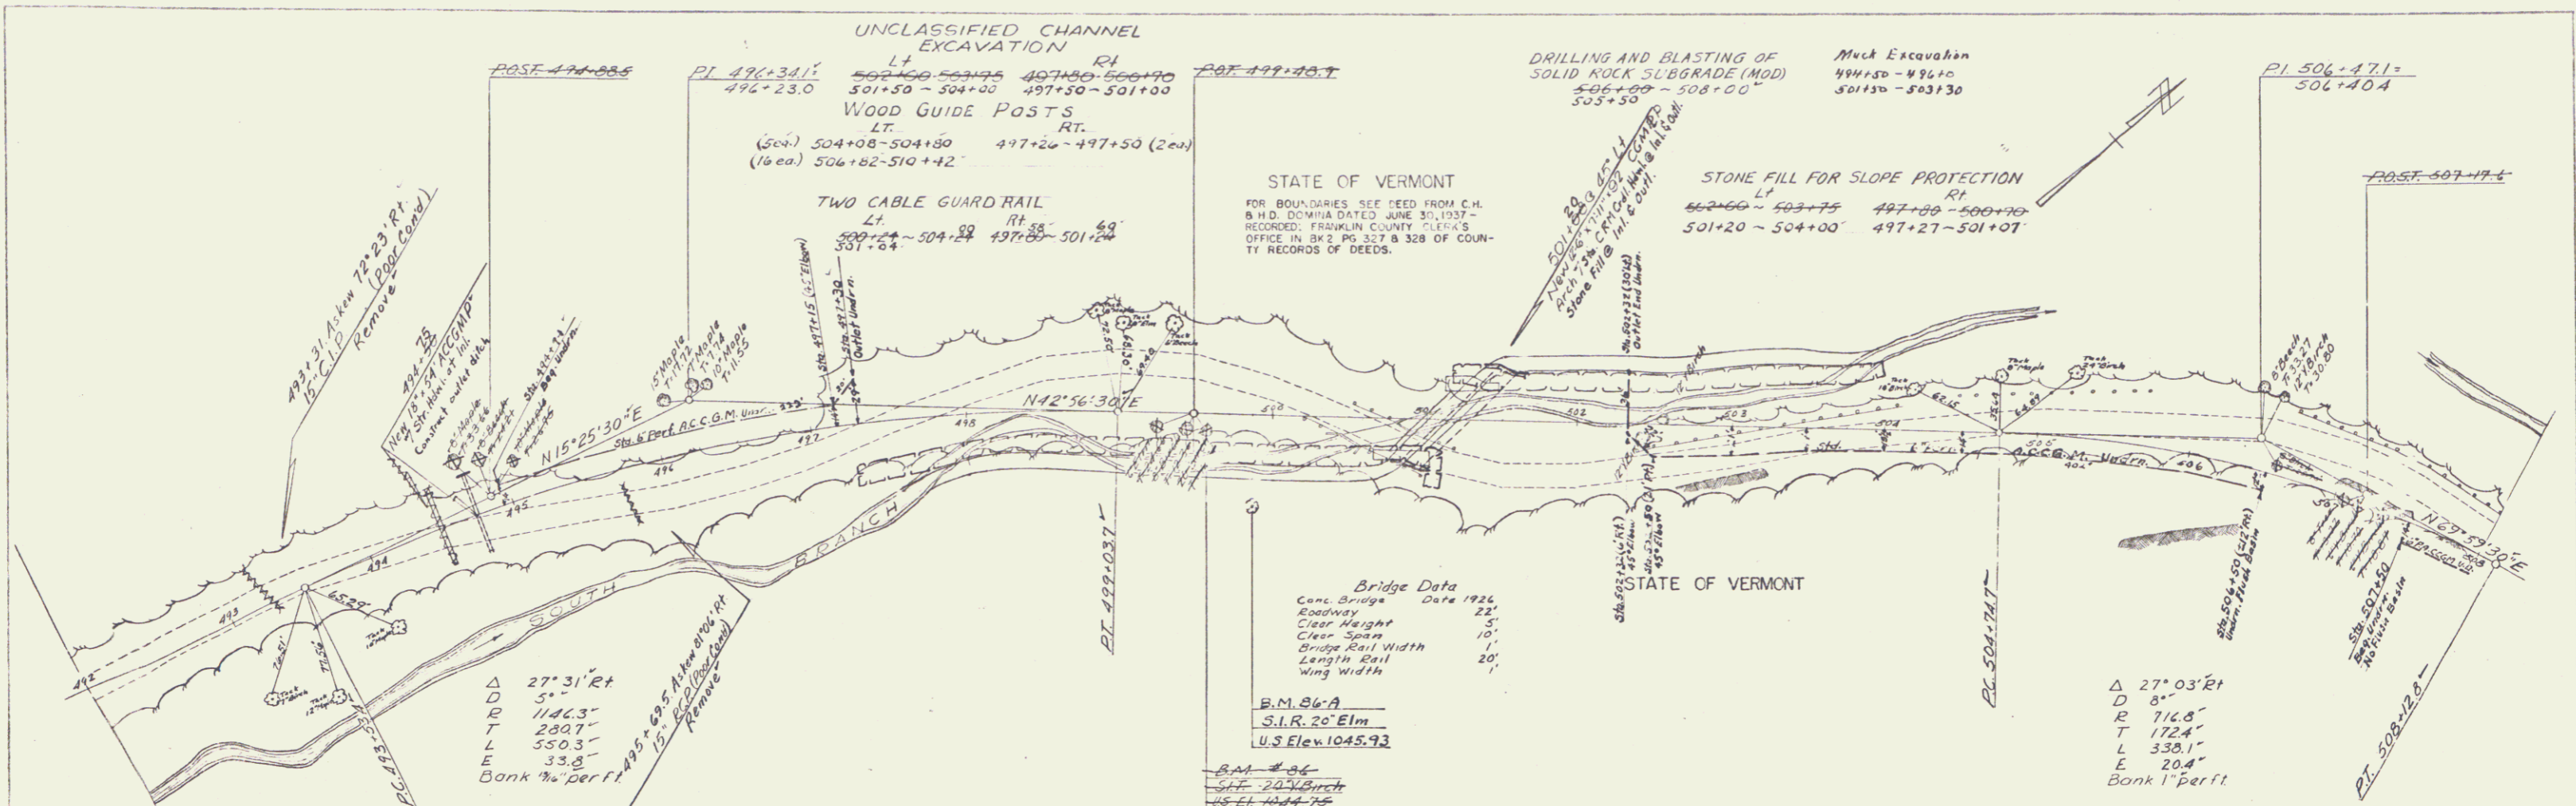

BELVIDERE - AVERY'S GORE - MONTGOMERY
 Proj. 5, No. 0203 (2)
 Sheet 11 of 110
 4