

TREATED TIMBER CURB
Lt.
558+75 ~ 564+70

CONSTRUCT DRIVES
Rt.
554+08'
567+30'


UNCLASSIFIED CHANNEL EXCAVATION
Lt. Rt.
560+50 ~ 561+25 560+35 ~ 560+60

STONE FILL FOR SLOPE PROTECTION
Lt. Rt.
560+50 ~ 561+25 560+35 ~ 560+60
559+15 ~ 560+15

TWO CABLE GUARD RAIL
Lt. Rt.
558+75 ~ 564+70 559+75 ~ 563+75
568+75 ~ 570+00

Scale	1" = 40'
North Arrow	True North
Projection	Universal Transverse Mercator
Zone	18N
Grid	18N 11E

Scale	1" = 40'
North Arrow	True North
Projection	Universal Transverse Mercator
Zone	18N
Grid	18N 11E

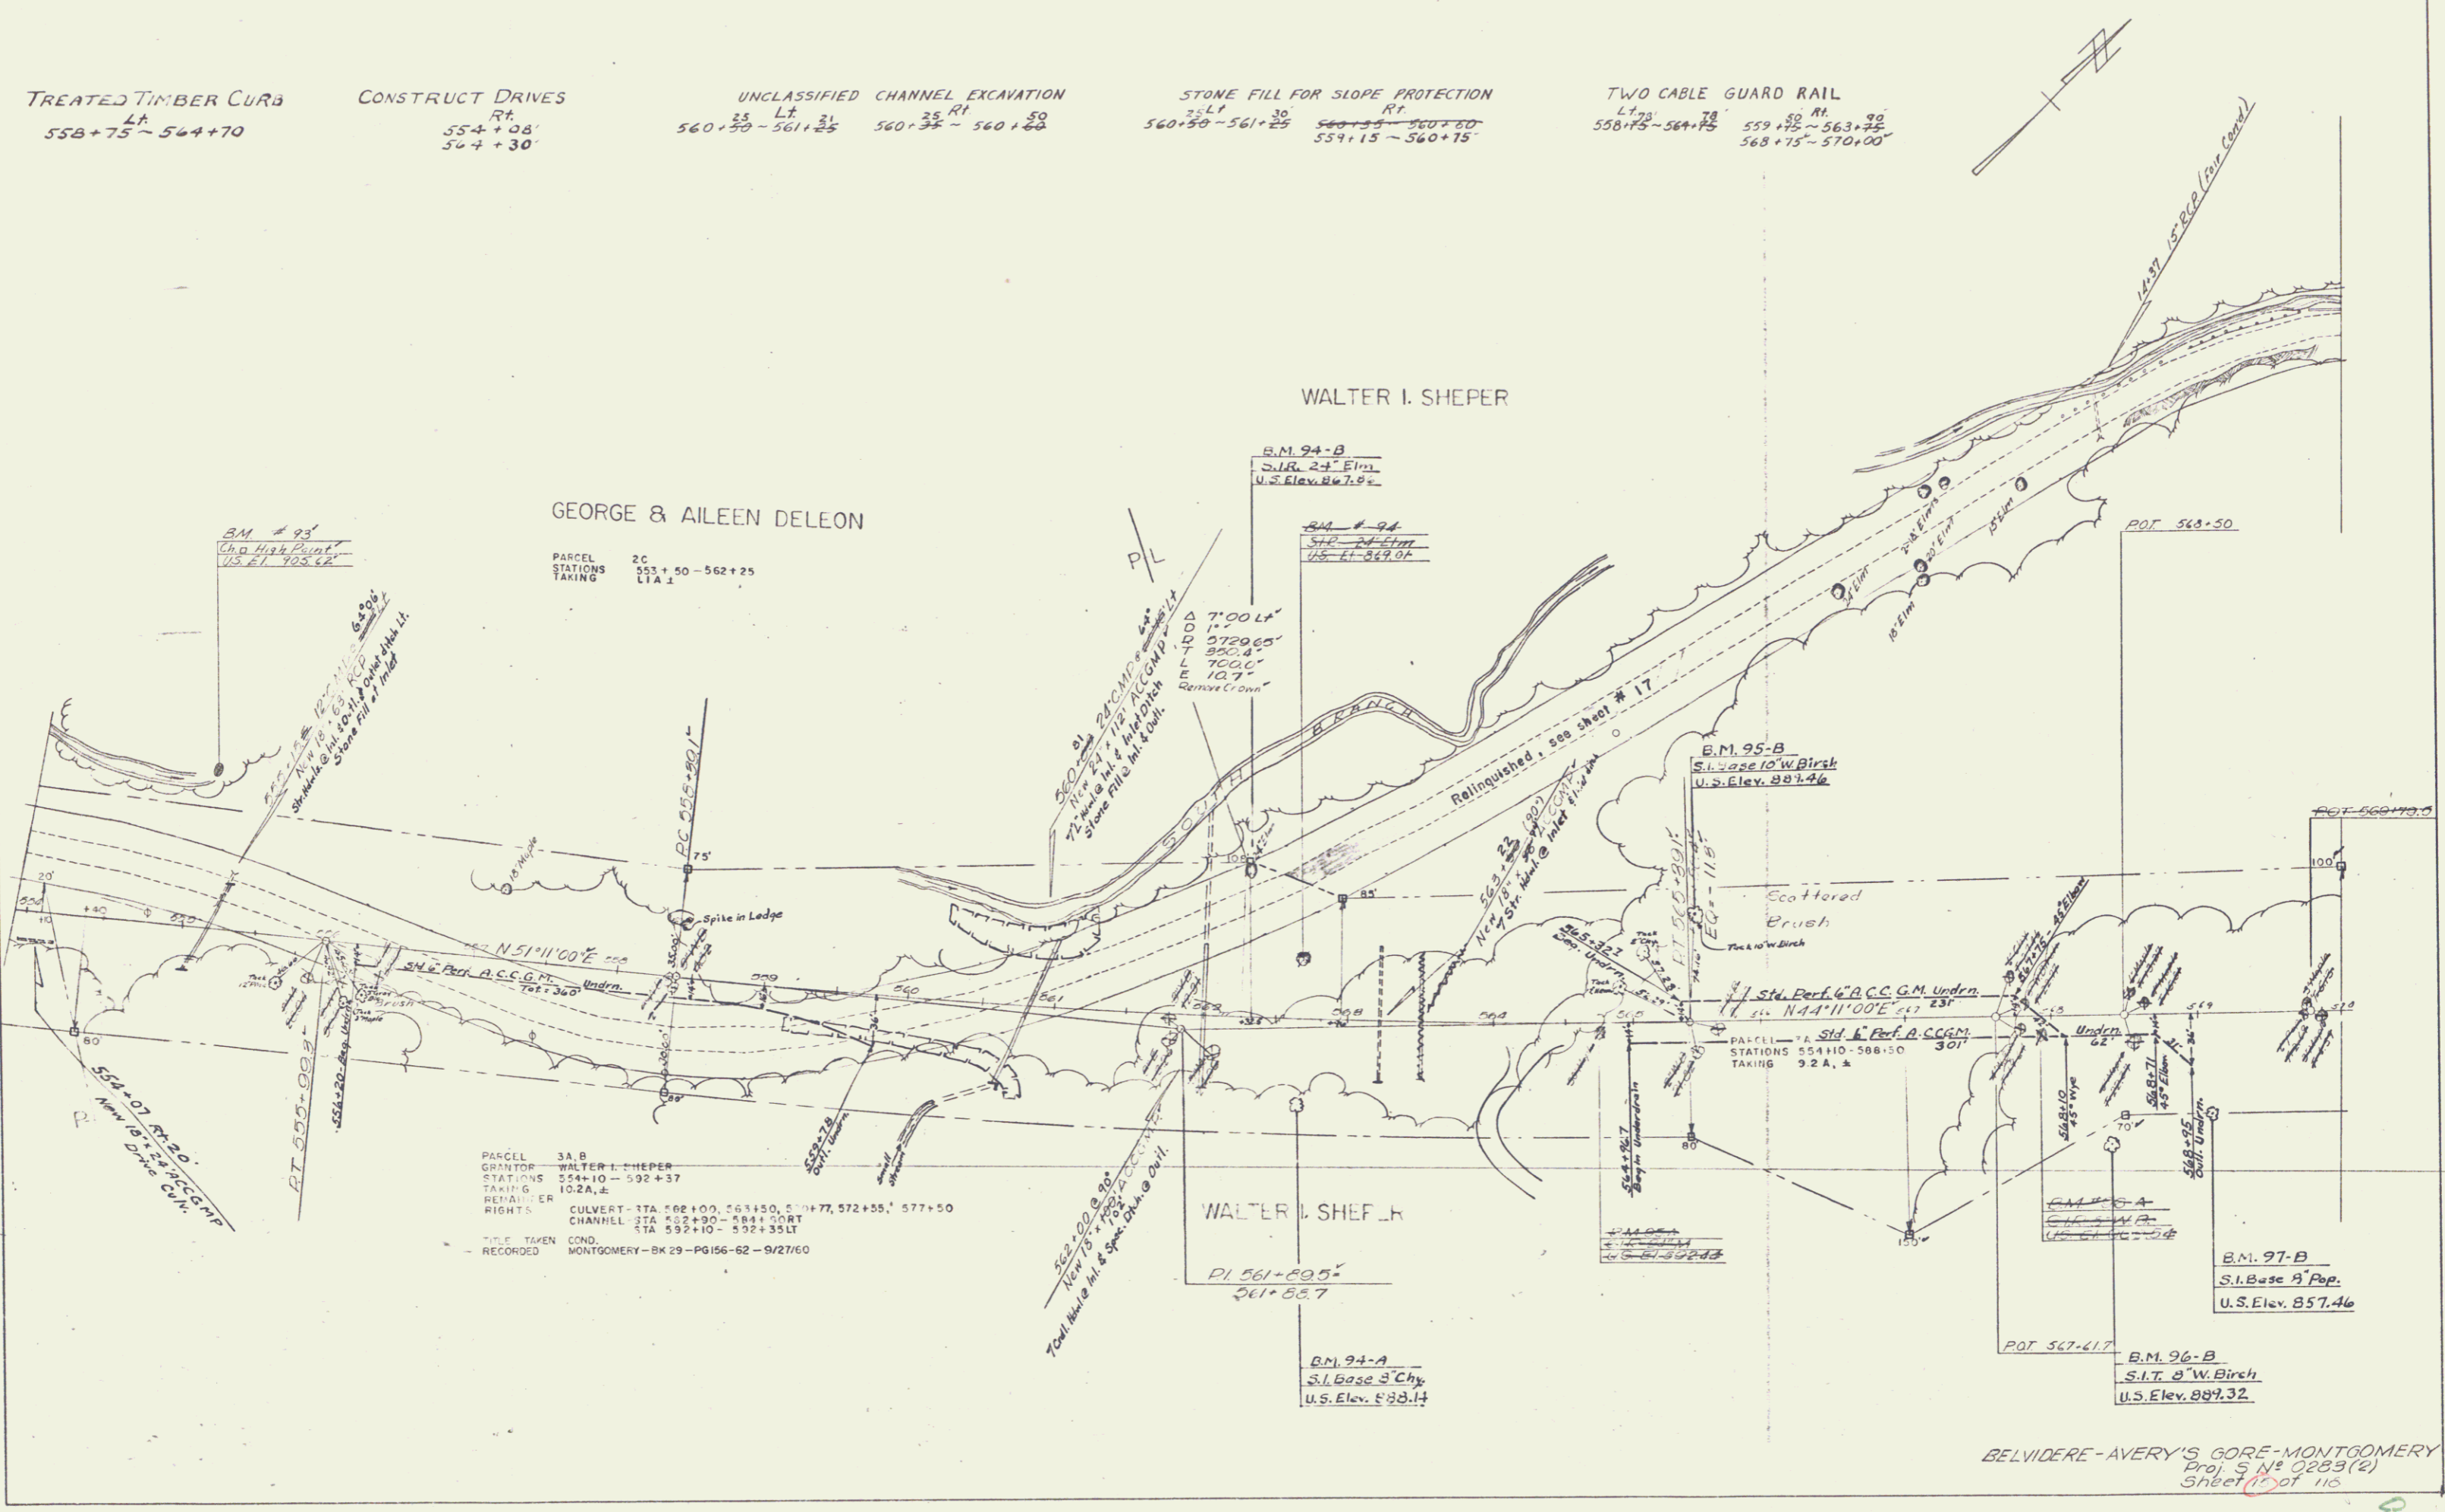

GEORGE & AILEEN DELEON

WALTER I. SHEPER

WALTER I. SHEPER

PARCEL 3A B
GRANTOR WALTER I. SHEPER
STATIONS 554+10 ~ 592+37
TAKING 10.2A, 4
REVERTER RIGHTS
CULVERT STA 562+00, 563+50, 577+55, 577+50
CHANNEL STA 592+00 ~ 592+35 LT
COND. STA 592+00 ~ 592+35 LT
RECORDED MONTGOMERY - BK 29 - PG 156-62 - 9/27/60

BELVIDERE - AVERY'S GORE - MONTGOMERY
Proj. S N° 0283(2)
Sheet 10 of 110