
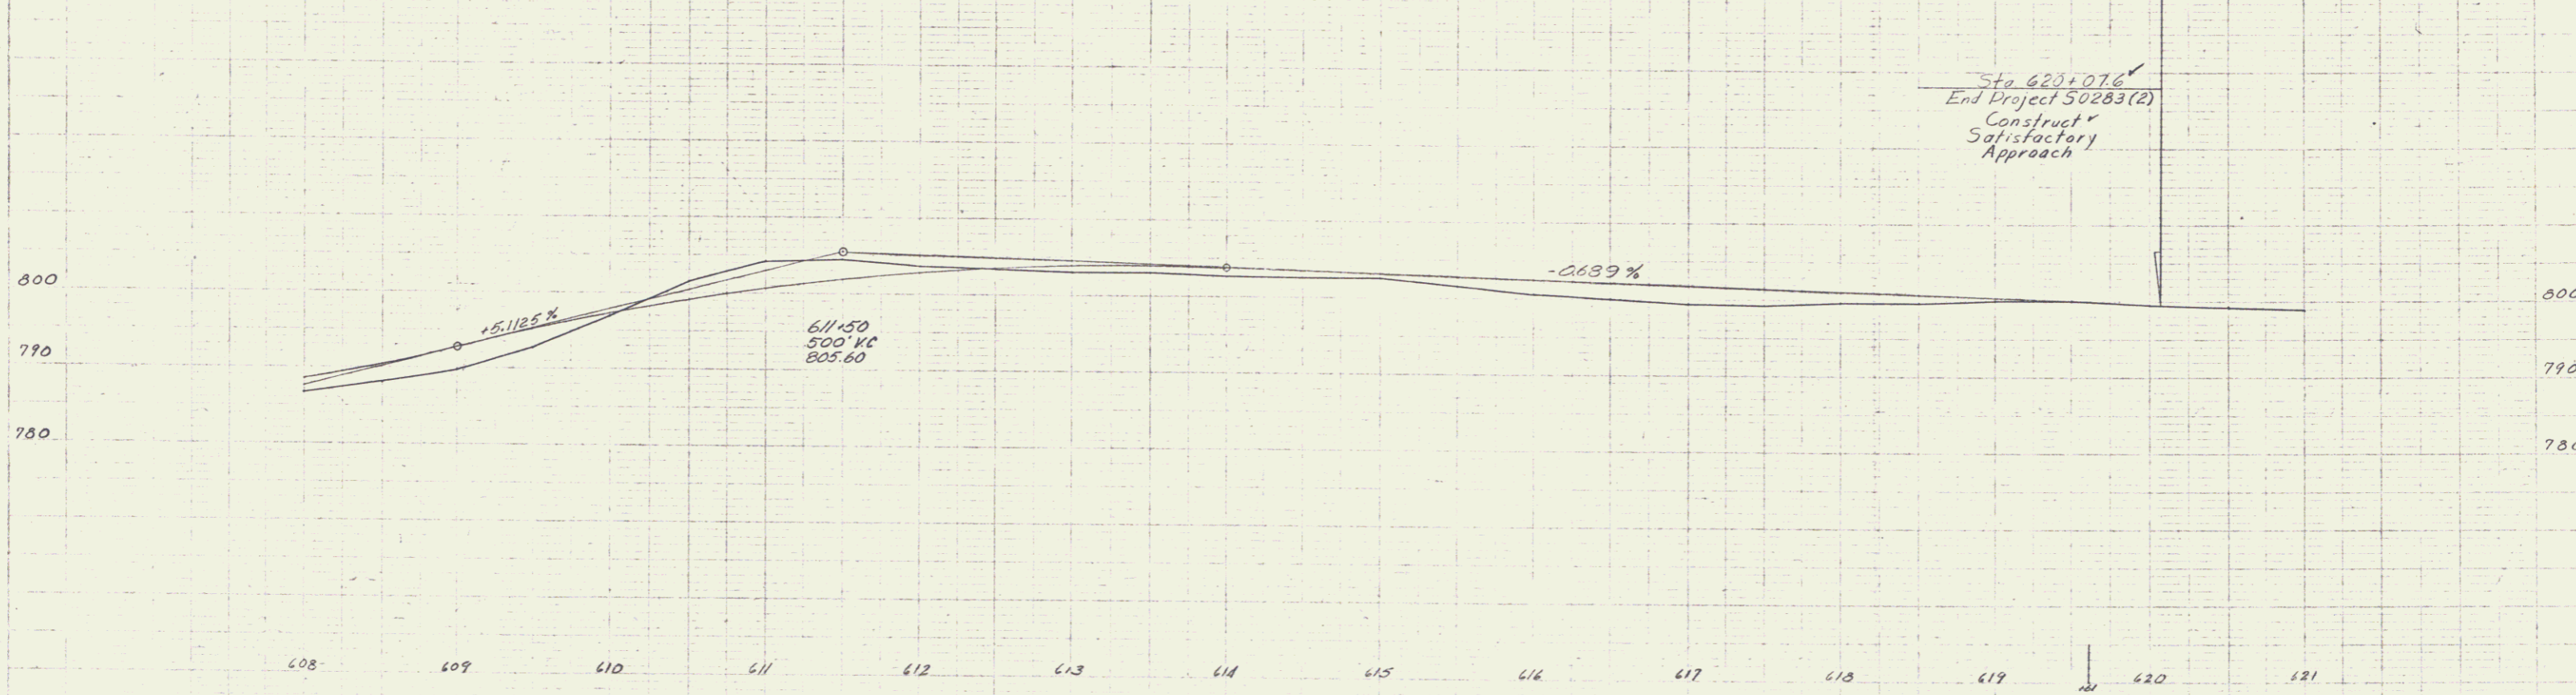


M.G. Warren 1/59
 M.G. Warren 1/59
 M.G. Warren 1/59

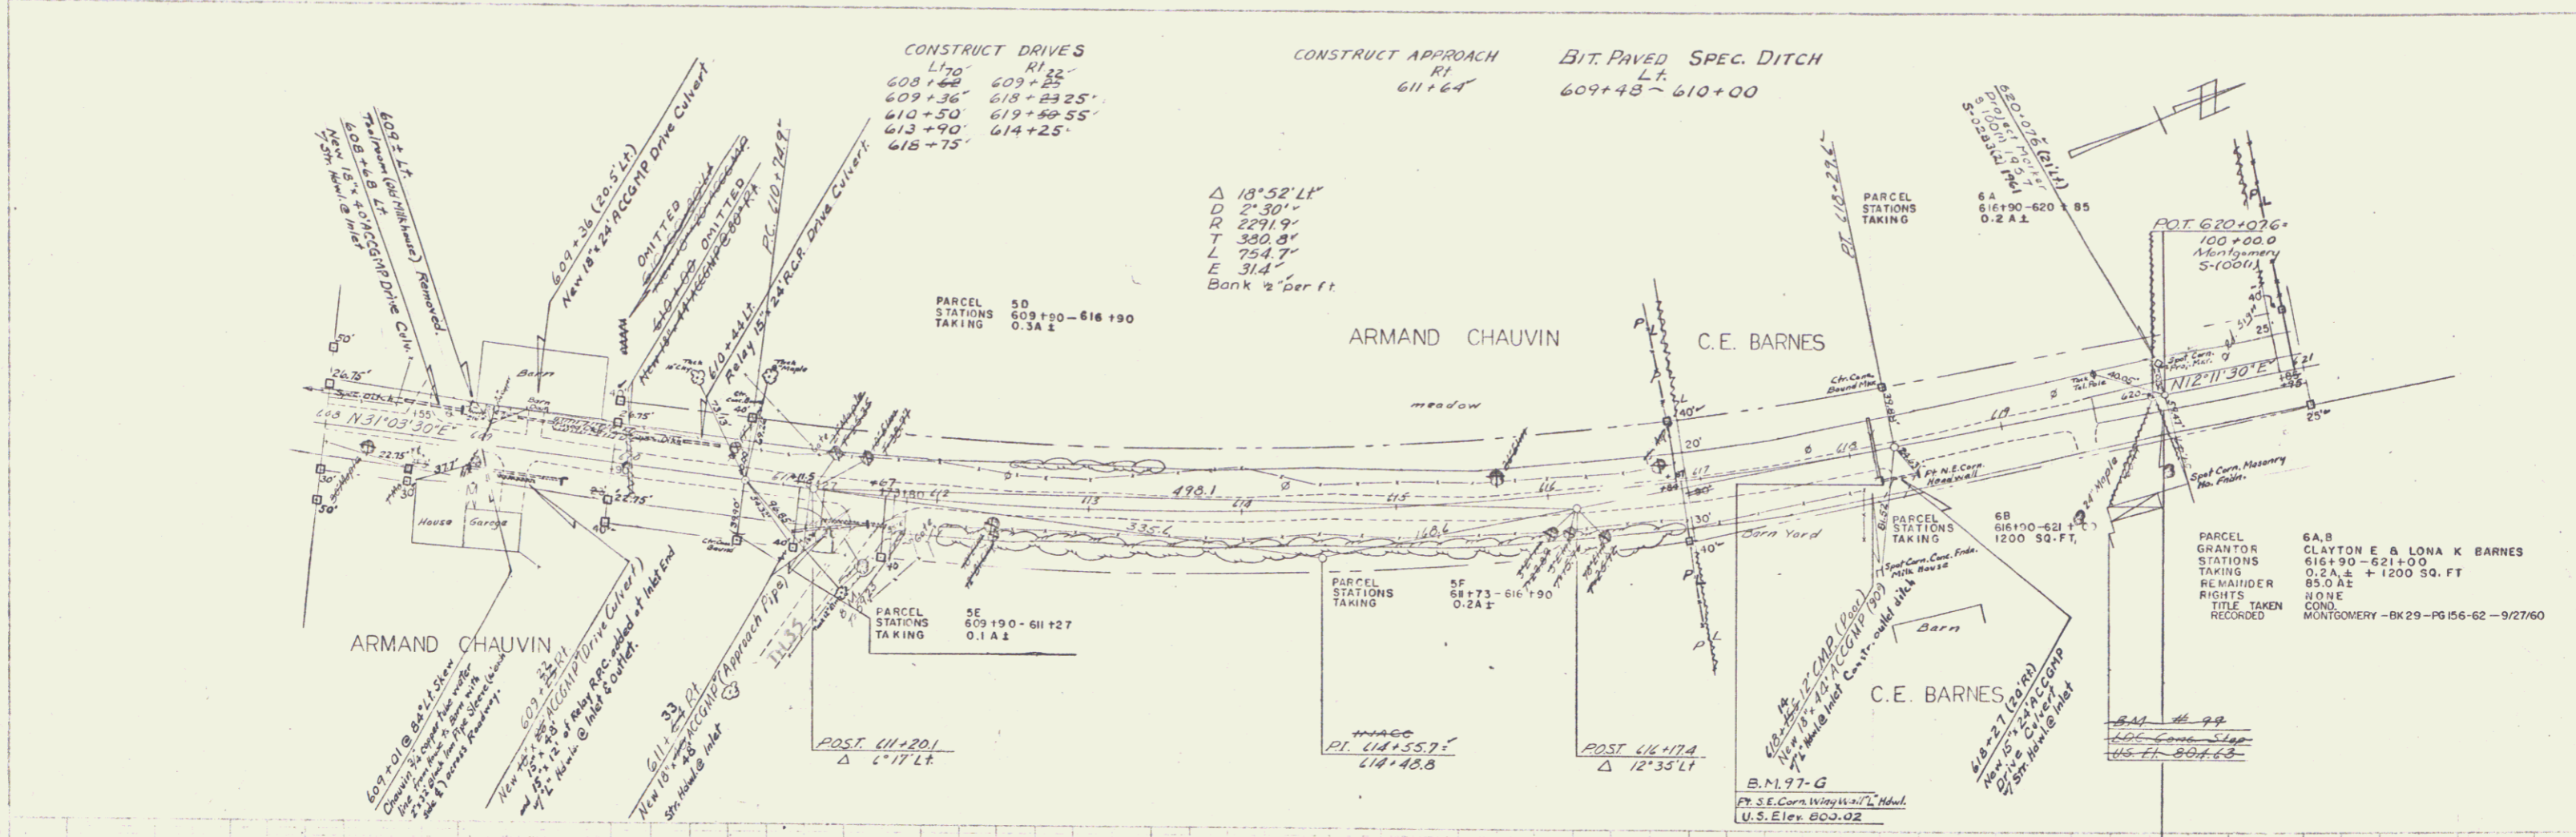

BELVIDERE - AVERY'S GORE - MONTGOMERY
 Proj. 50283(2)
 Sheet (2) of 110