

Wood Guide Posts  
~~128+00-129+00~~  
 128+44 - 130+190

CONSTRUCT	DRIVES
130 + 00	LT ✓
131 + 18	RT ✓
131 + 62	LT ✓
139 + 60	RT ✓ 13145 RT
142 + 40	RT ✓ 14175 LT

Two Cable Guard Rail  
 LI  
~~132+00-136+00~~  
 132+89 - 141+56  
 132+34 - 136+18  
 141+95 - 145+10



#48 RAYMOND E. & FLORENCE M. PERRY  
 (A 1.260±) STA 133+00-152+12±LT  
 O.D. 9/1/56  
 RECORDED MONTGOMERY-BK25-PG274-11/1/56

#6A JOSEPH C. & MARION M. LUMBA  
 (A 0.32±) STA 131+35-139+00±RT  
 W.D. 8/31/56  
 RECORDED MONTGOMERY-BK27-PG343-9/8/56

FREDERICK M. & SHIRLEY M. KENNETT #5  
 (A 0.014±) STA 129+19 - 130+00±RT  
 W.D. 9/6/56  
 RECORDED MONTGOMERY-BK27-PG350-11/1/56

PLAN  
 WESTER-MARTIN, INC. P-55  
 WESTER-MARTIN, INC. 10-58  
 1100 N. W. 10th St., Ft. Lauderdale, Fla.

PROFILE  
 WESTER-MARTIN, INC. P-18  
 WESTER-MARTIN, INC. 10-58  
 1100 N. W. 10th St., Ft. Lauderdale, Fla.

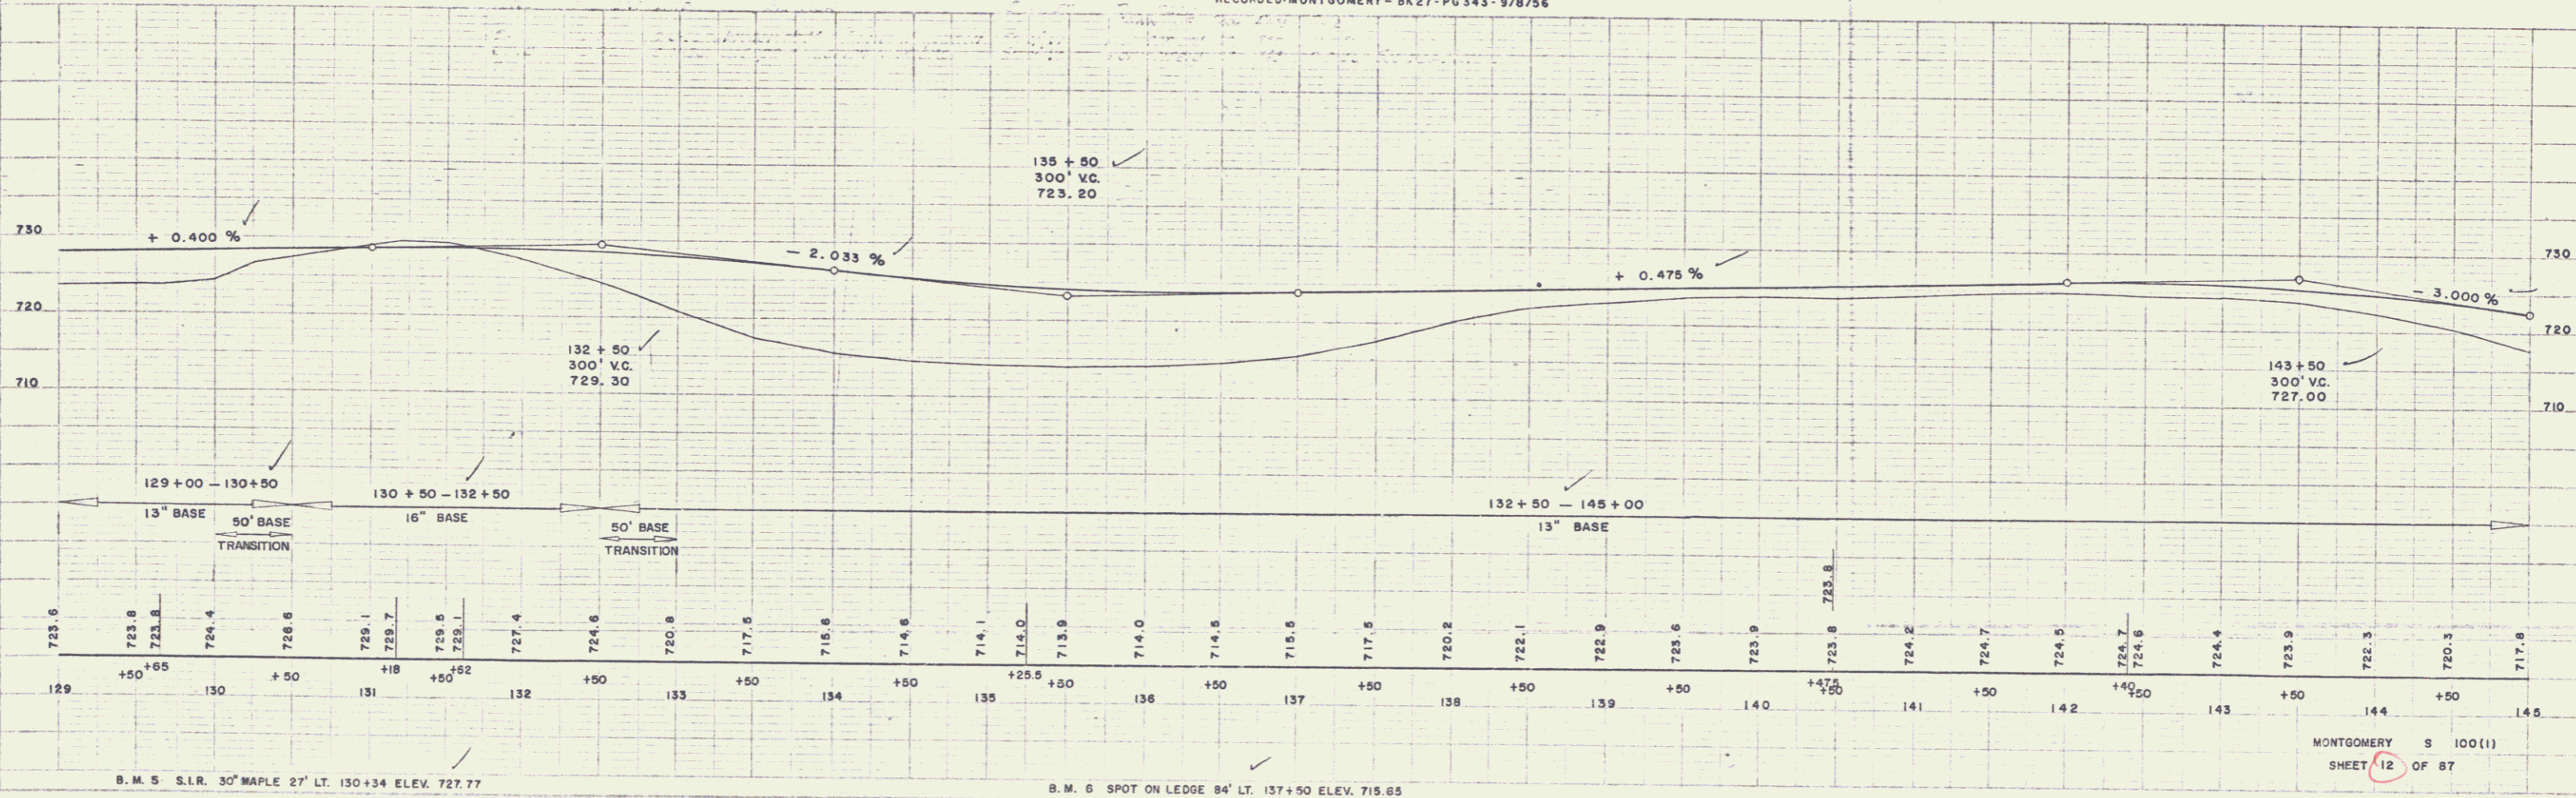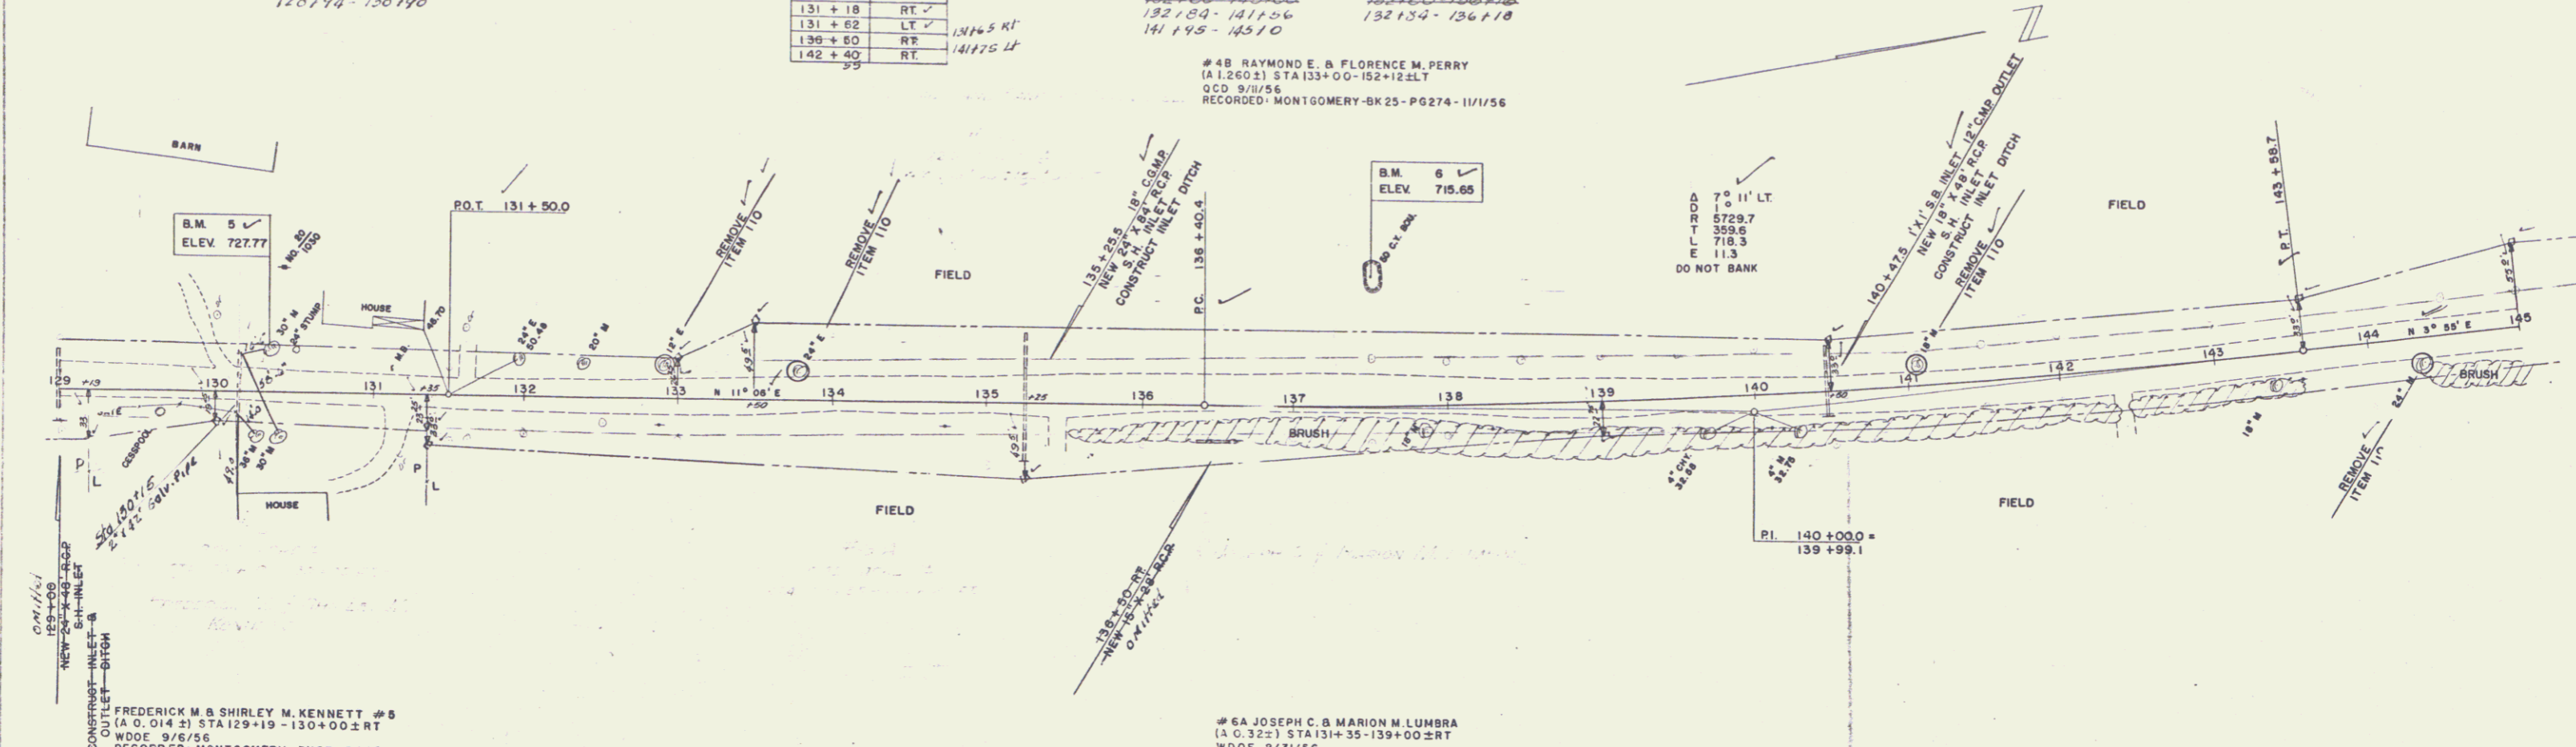

B. M. 5 S.L.R. 30' MAPLE 27' LT. 130+34 ELEV. 727.77

B. M. 6 SPOT ON LEDGE 84' LT. 137+50 ELEV. 715.65

MONTGOMERY S 100(1)  
 SHEET 12 OF 87

4