


WEBSTER-MARTIN, INC. 8-55
 WEBSTER-MARTIN, INC. 10-55
 FAY
 ARCHITECTS
 1100 N. W. 10th St.
 MIAMI, FLA.

WEBSTER-MARTIN, INC. 8-55
 WEBSTER-MARTIN, INC. 10-55
 SCHILL
 ARCHITECTS
 1100 N. W. 10th St.
 MIAMI, FLA.

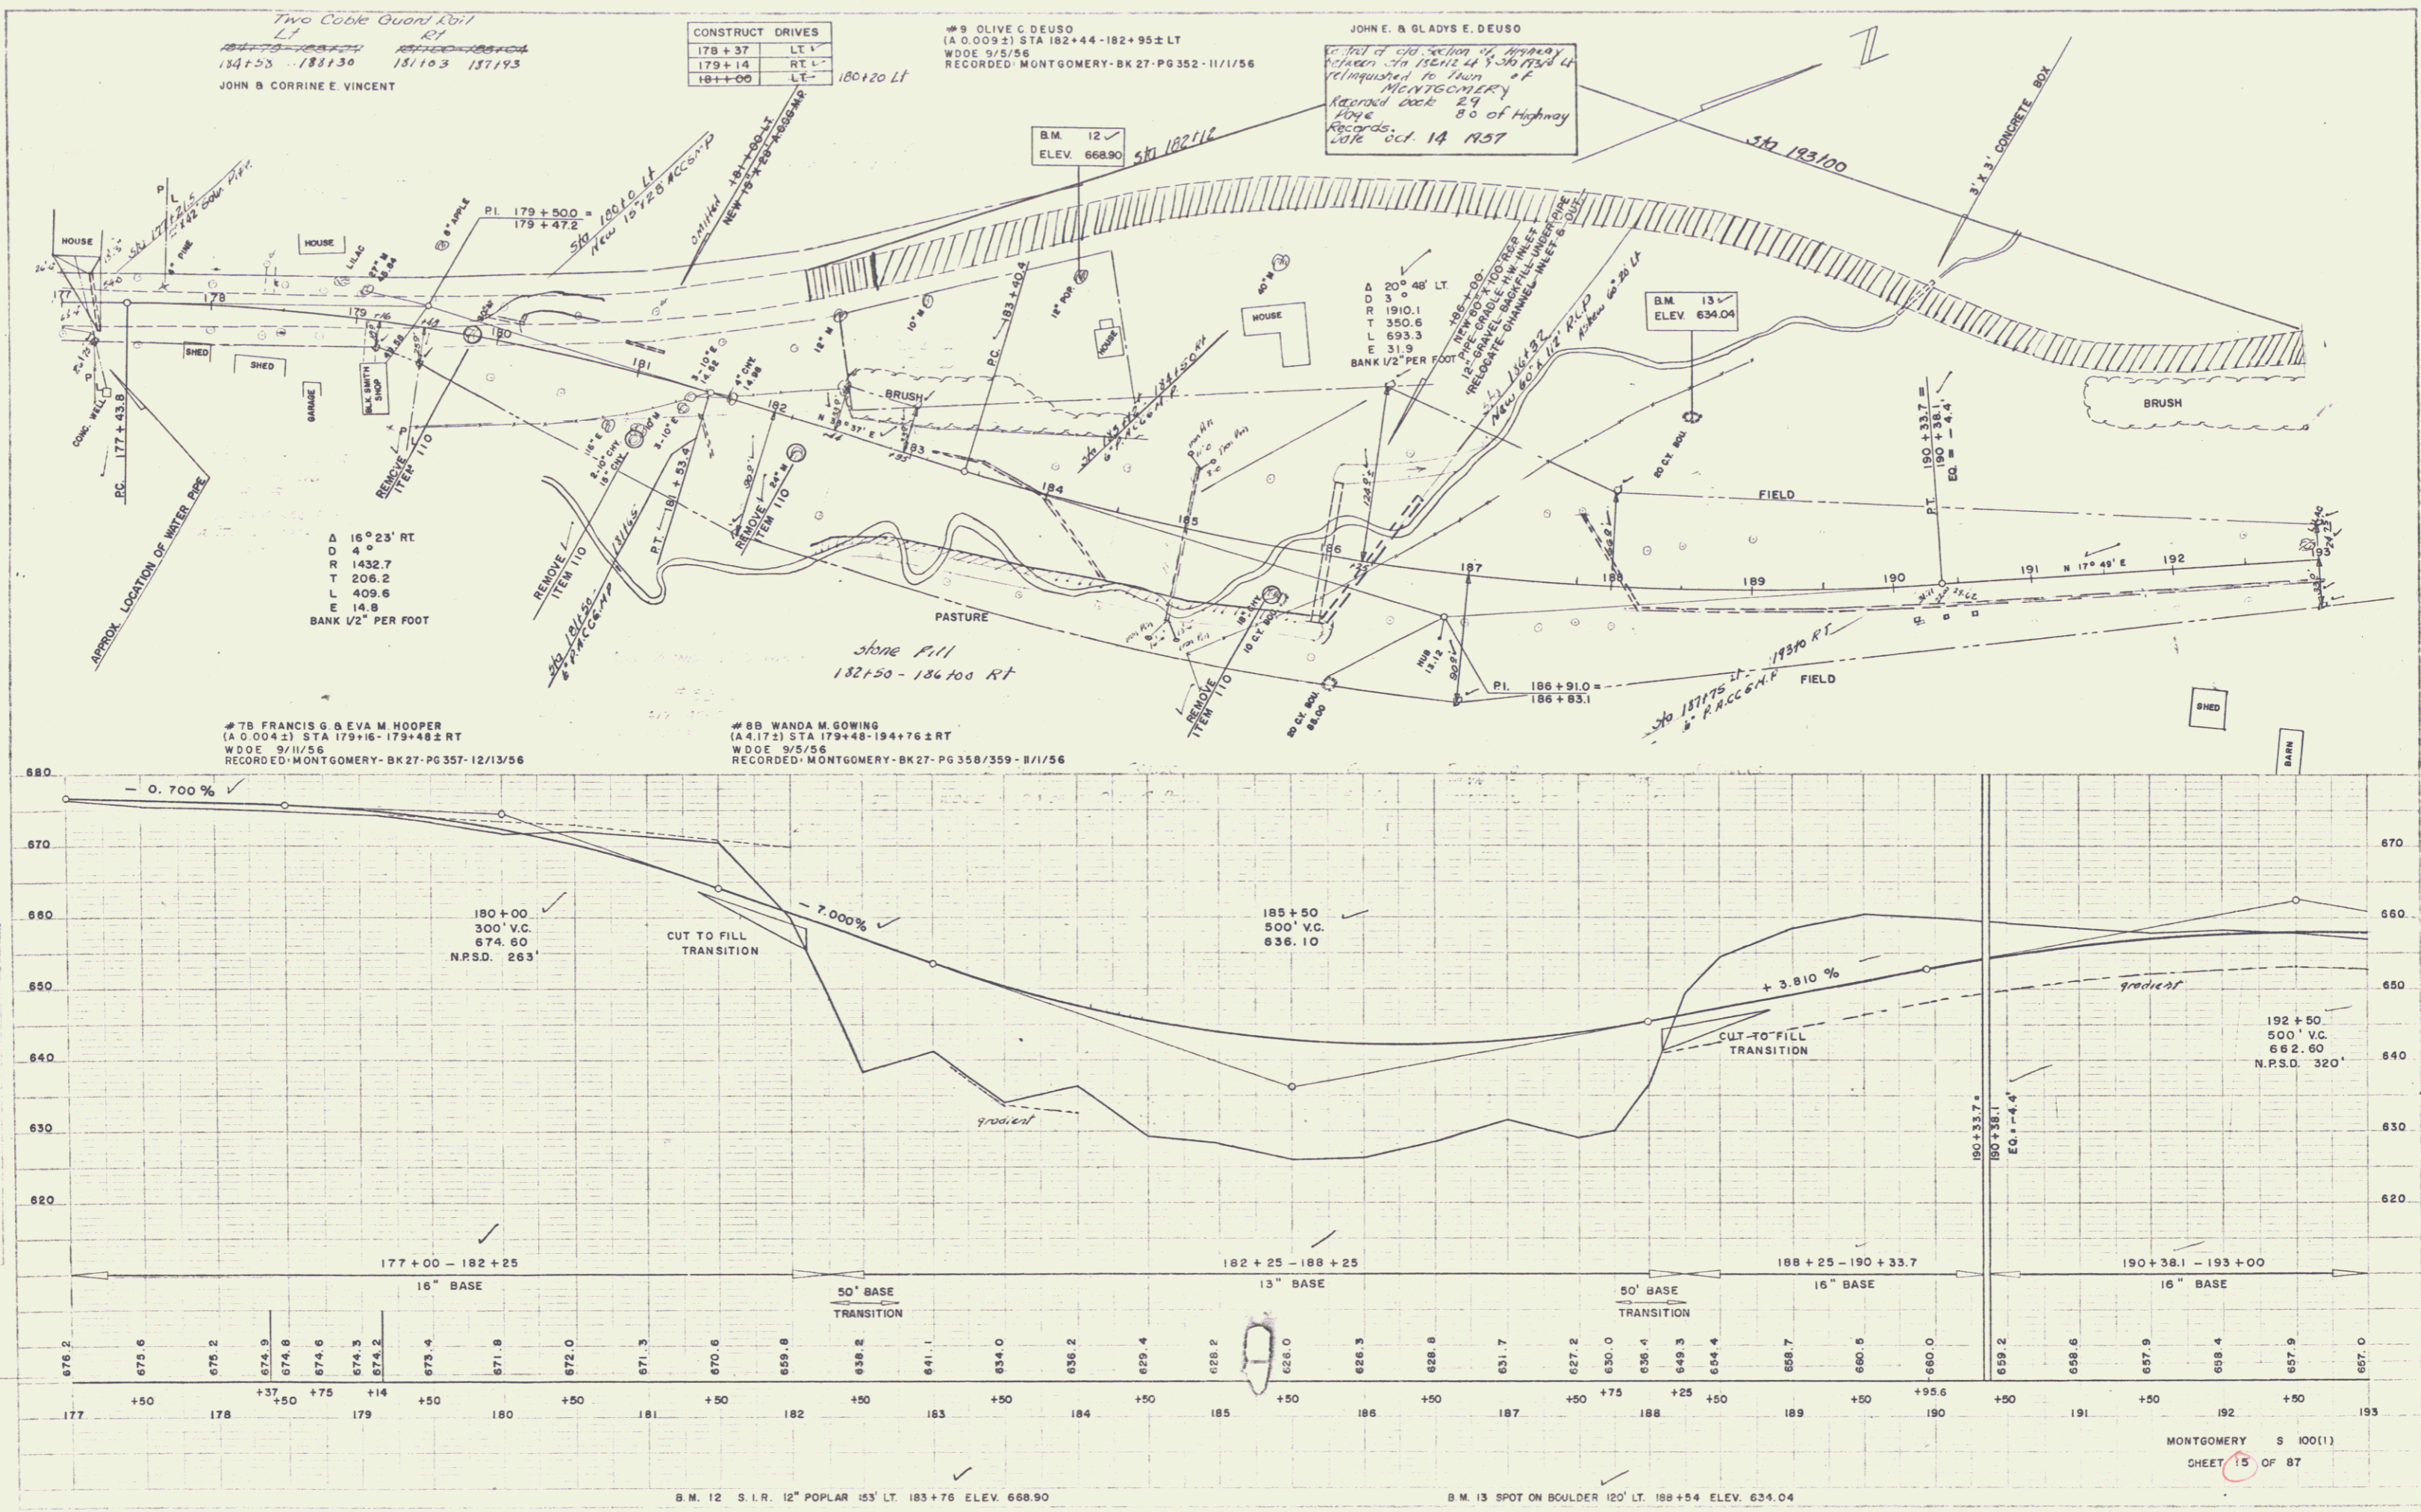

7