


#88 WANDA M. GOWING (A 1 472) STA 179+48 - 194+76± RT W.D.E. 3/5/56 RECORDED MONTGOMERY-BK27-PG 358/359-11/1/56

#10A DELBERT D. HOWARD & WINNIE V. HOWARD (A 1 454±) STA 194+66 - 203+98± RT #10S SLOPE RIGHTS - STA 204+50 - 205+32± LT W.D. 9/11/56 RECORDED MONTGOMERY-BK29-PG 73-5/14/57

#11 LOUIS D. & NAIDA M. BROUILLETTE SLOPE RIGHTS - STA 205+32 - 211+00± LT W.D.E. 9/17/56 RECORDED MONTGOMERY-BK27-PG 351-11/1/56 UNDERDRAIN RIGHTS - STA 206+50 & 217+50

HOWARD M. & SHIRLEY A. SYLVESTER

LLOYD E. & BEATRICE W. SYLVESTER

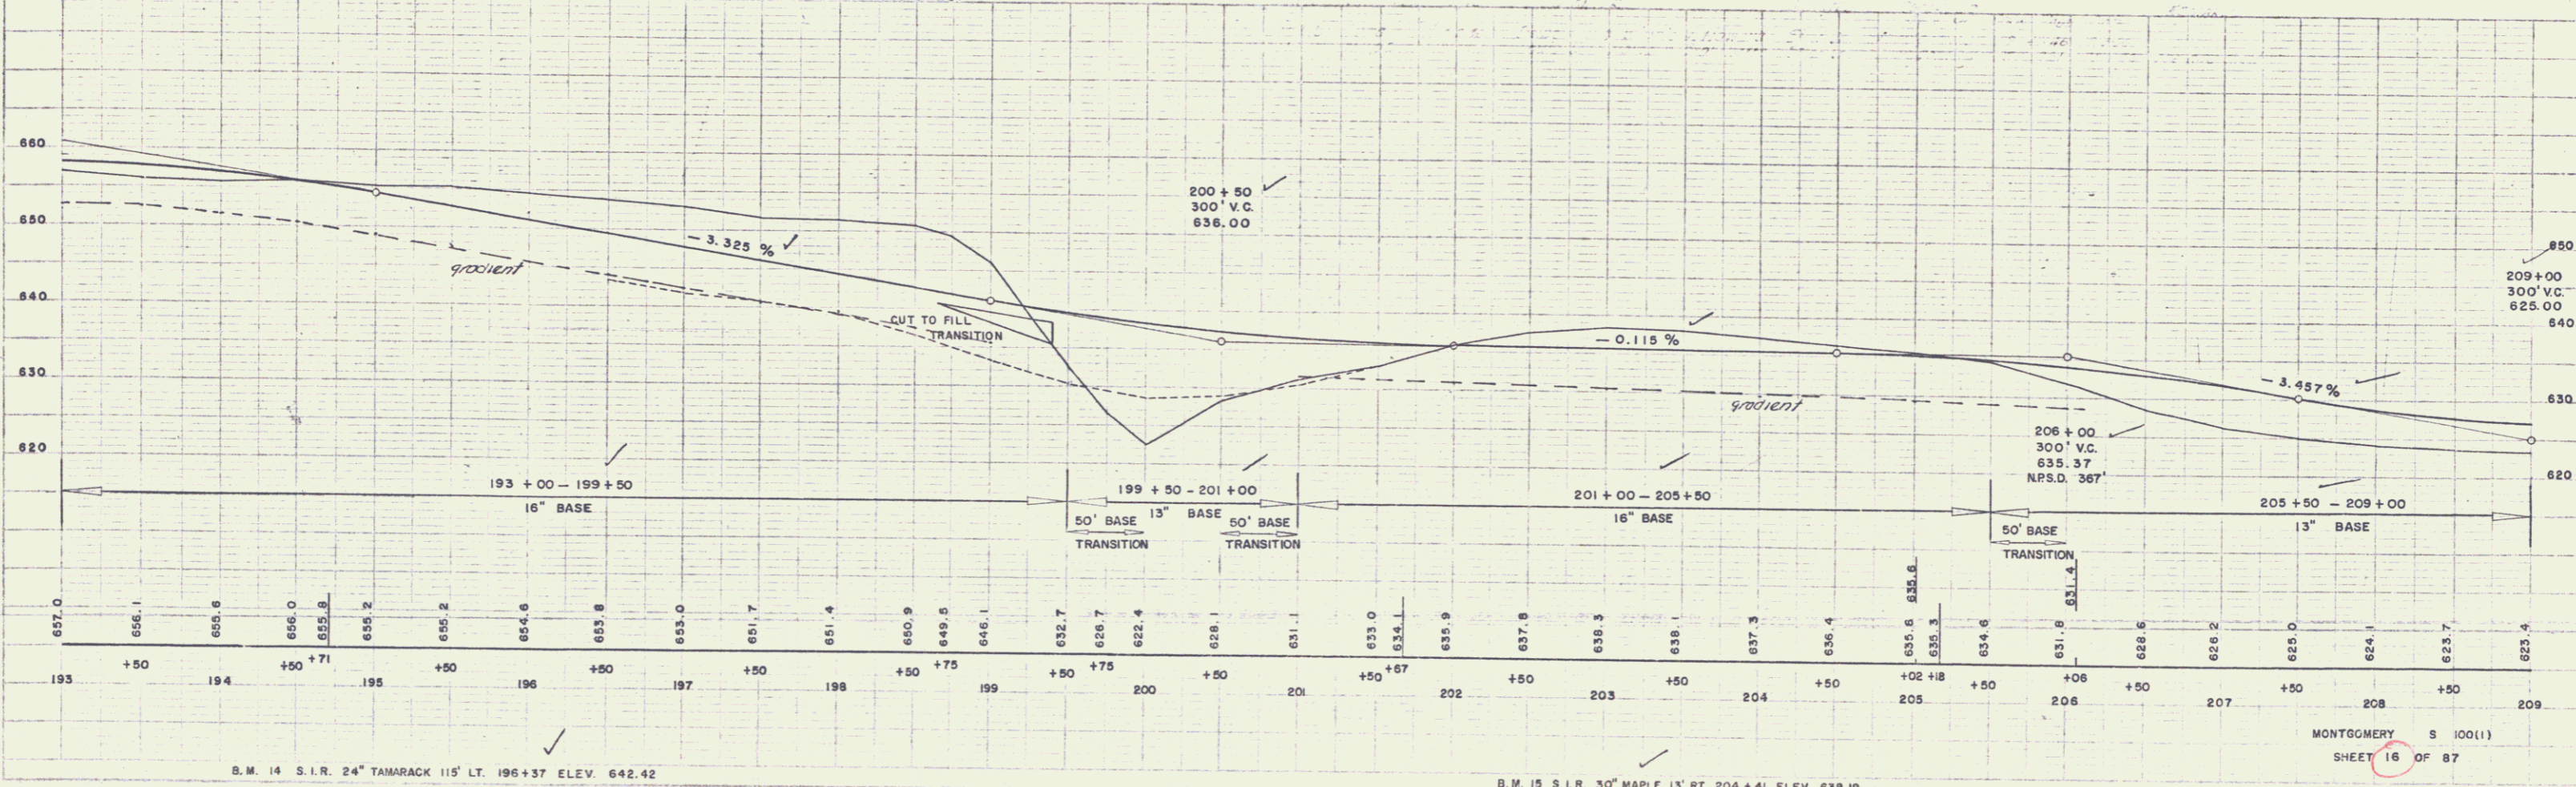

B.M. 14 S.I.R. 24" TAMARACK 115' LT. 196+37 ELEV. 642.42

B.M. 15 S.I.R. 30" MAPLE 13' RT. 204+41 ELEV. 638.19

MONTGOMERY S 100(1) SHEET 16 OF 87

PLAN
SCALE 1" = 40'

PROFILE
SCALE 1" = 40'

8