


PLAN  
 WESTER-MARTIN, INC. 9-55  
 WESTER-MARTIN, INC. 10-55

PROFILE  
 WESTER-MARTIN, INC. 9-55  
 WESTER-MARTIN, INC. 10-55

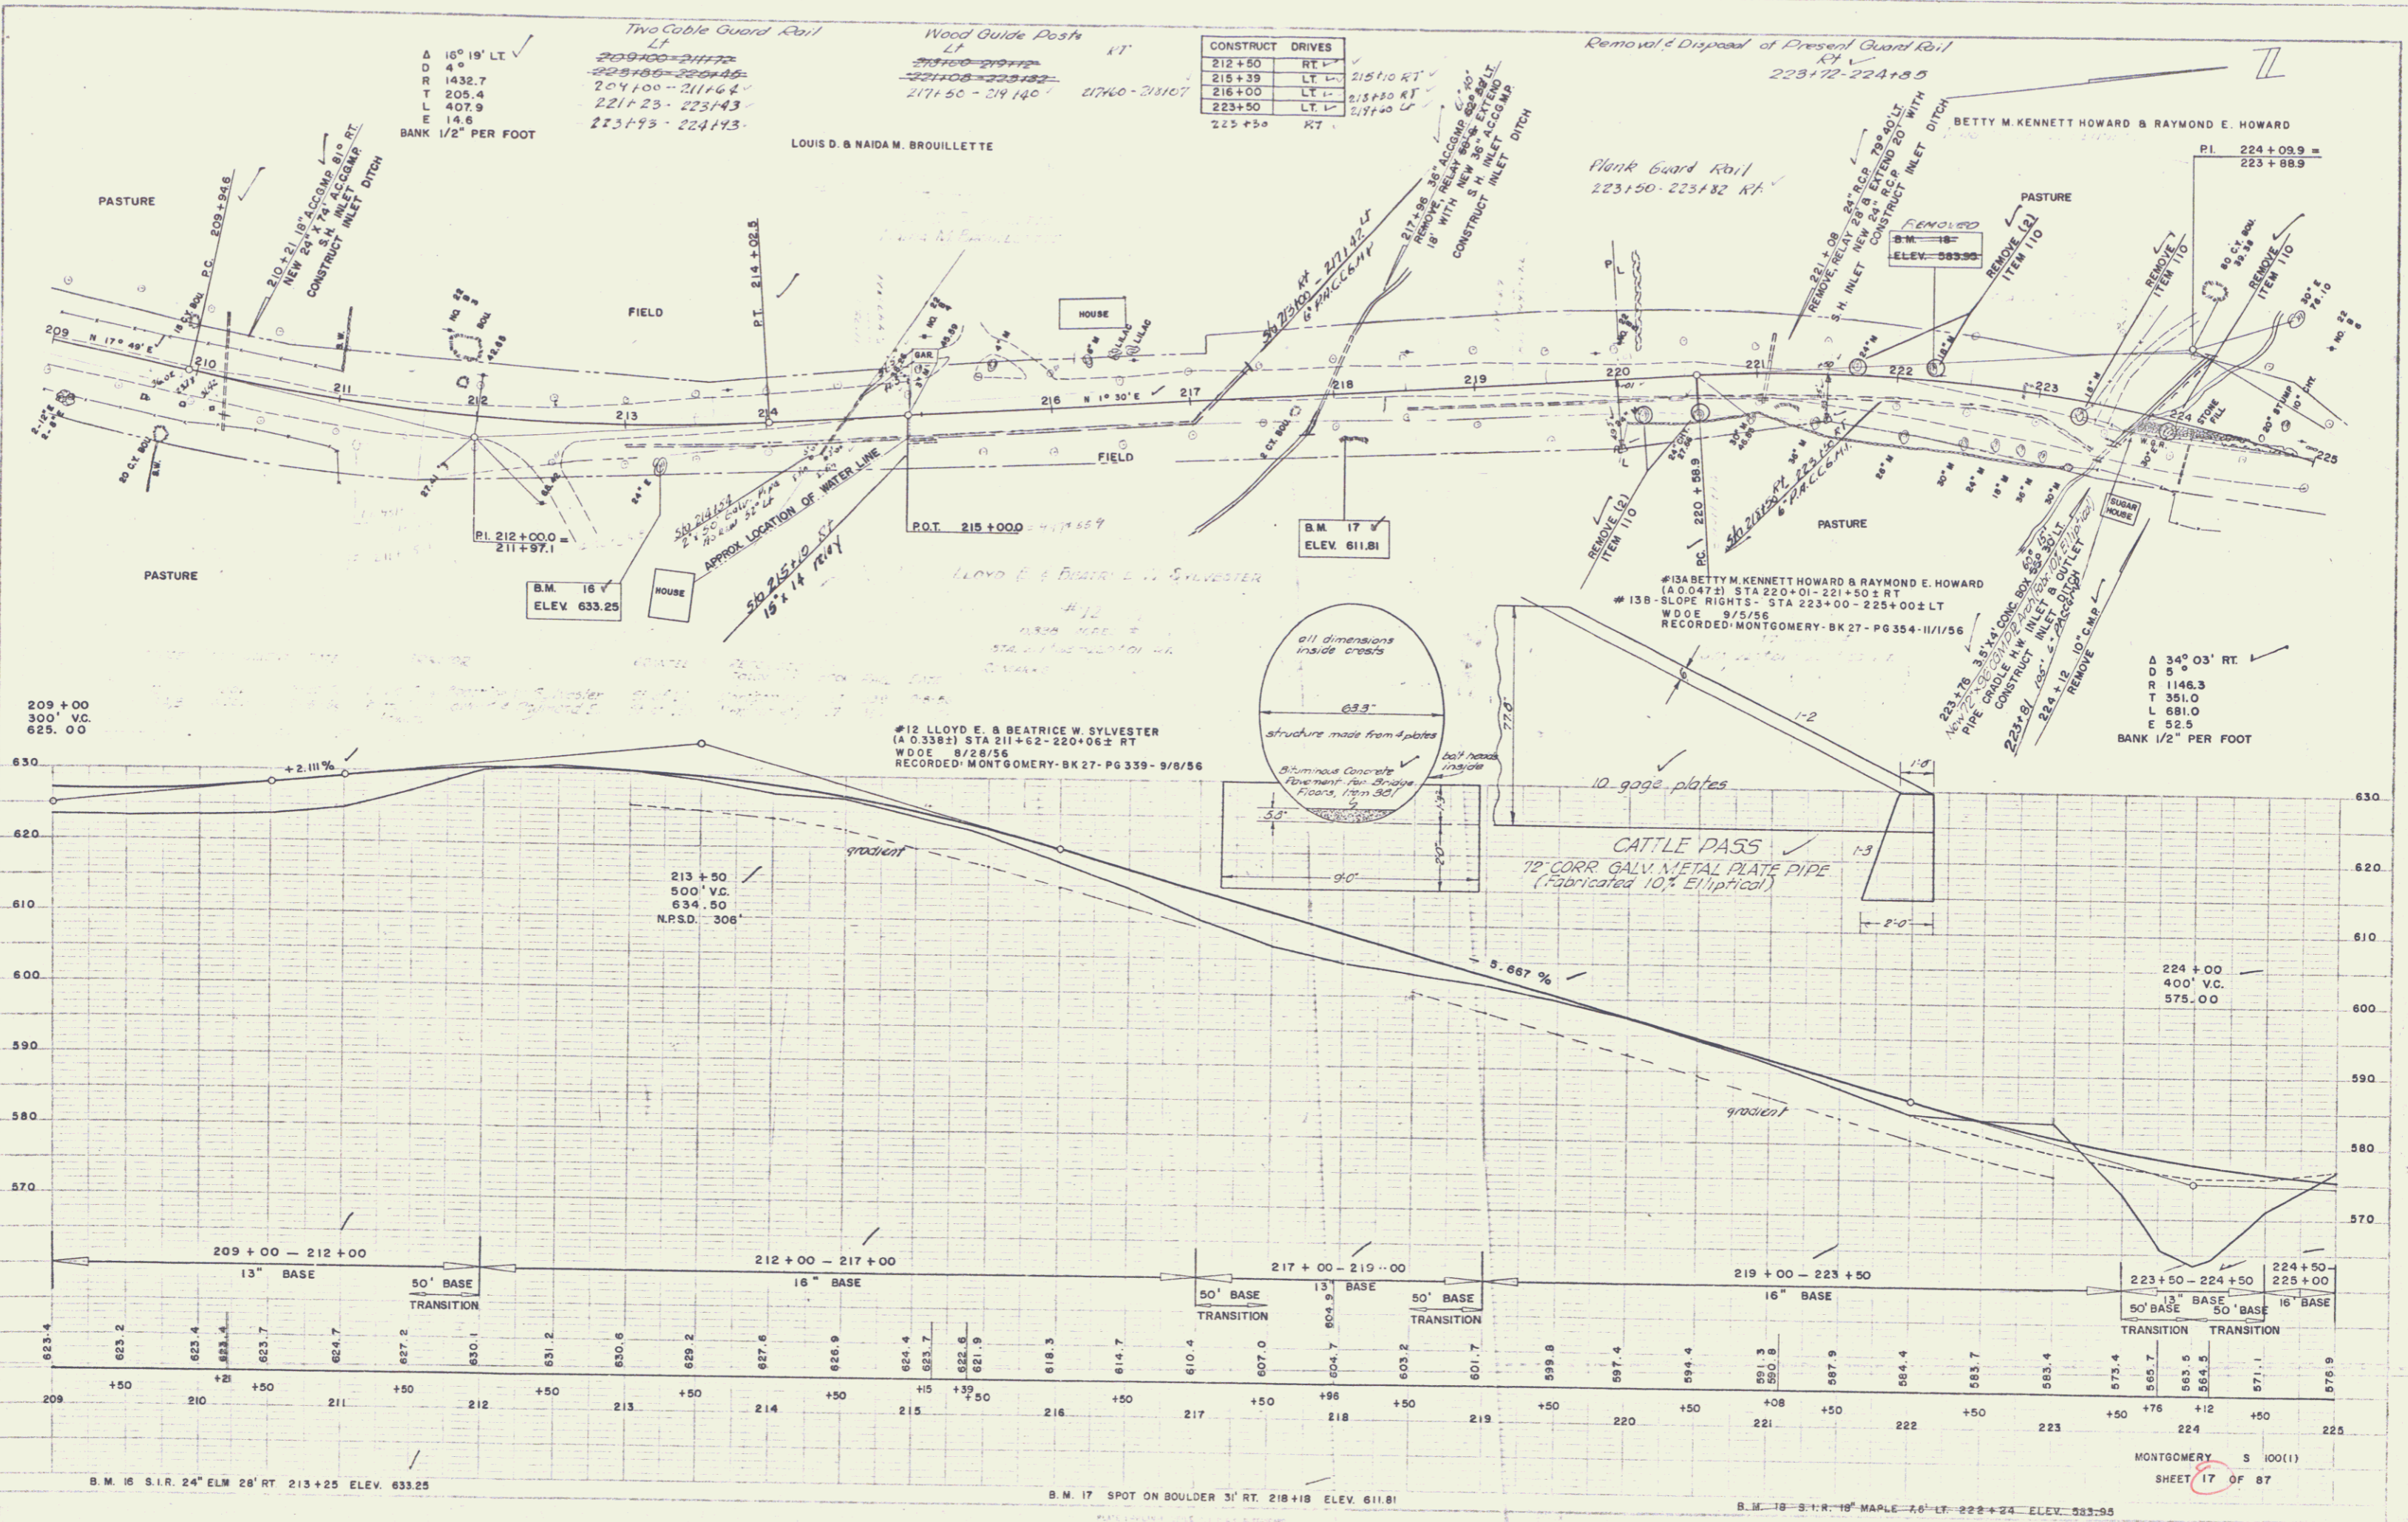

9