
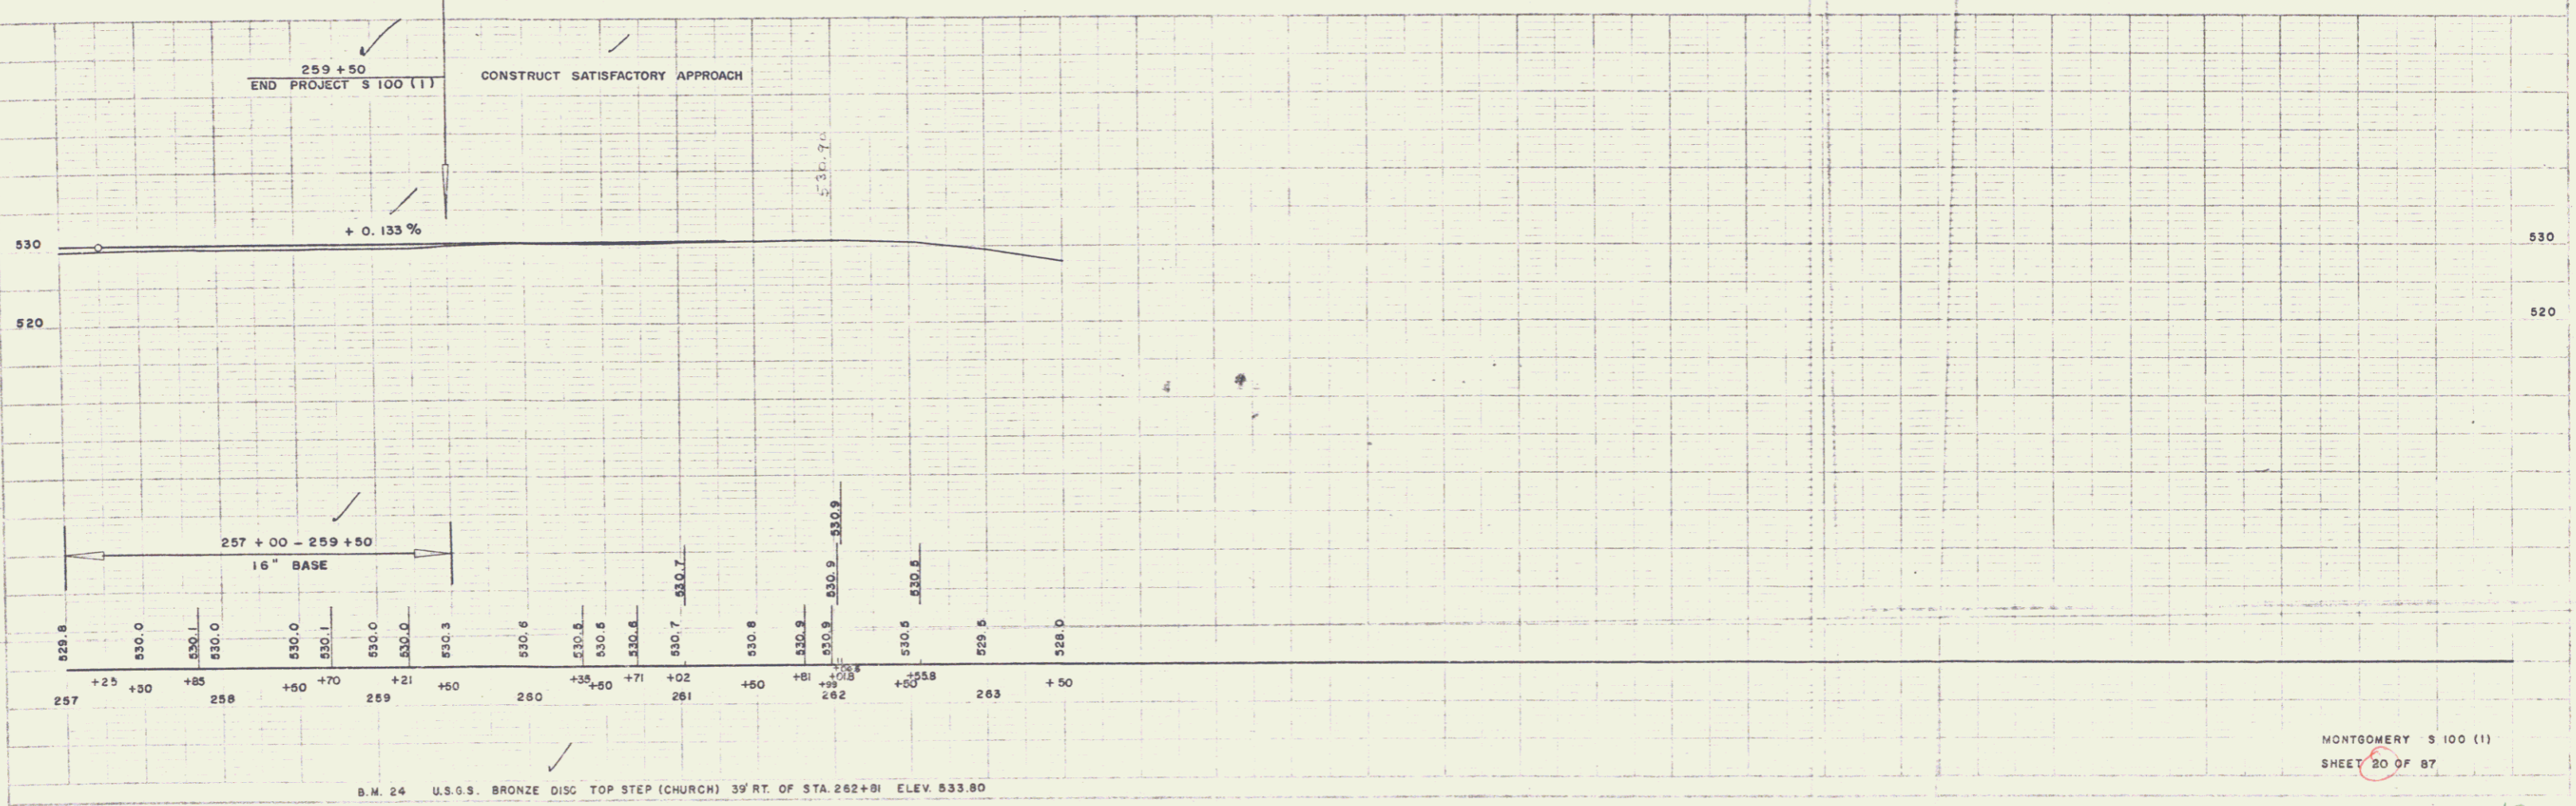


CHARLES W. & WANETA P. GATES

CONSTRUCT DRIVES	
257+85	RT
258+20 - 259+50	LT
259+50	RT

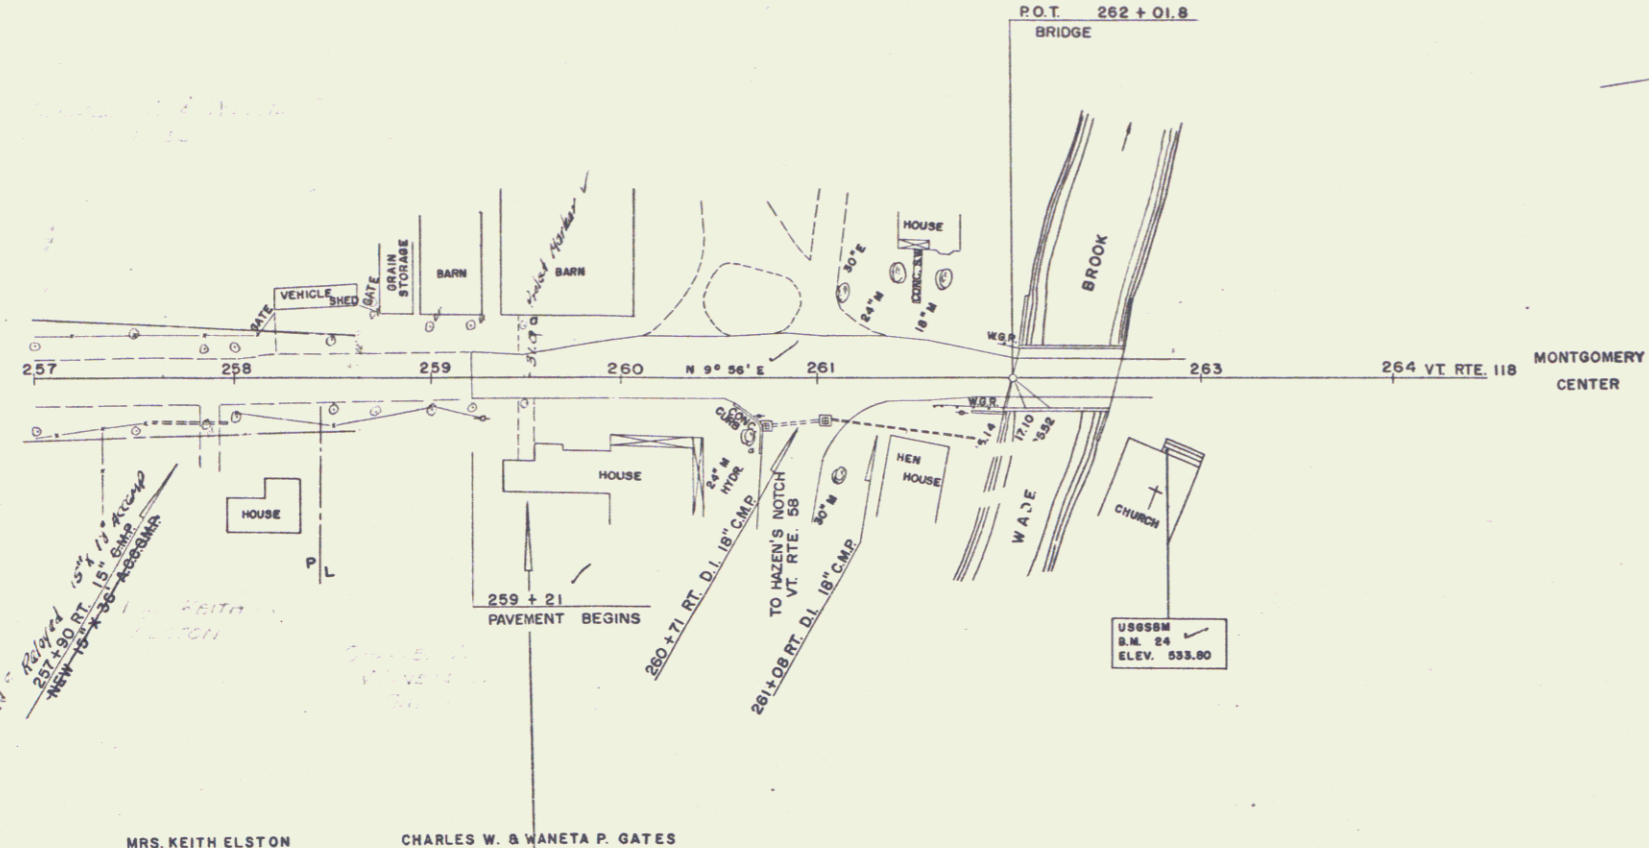

WEBSTER-MARTIN INC. 9-85
 WEBSTER-MARTIN INC. 10-85
 PLAN

WEBSTER-MARTIN INC. 9-85
 WEBSTER-MARTIN INC. 10-85