
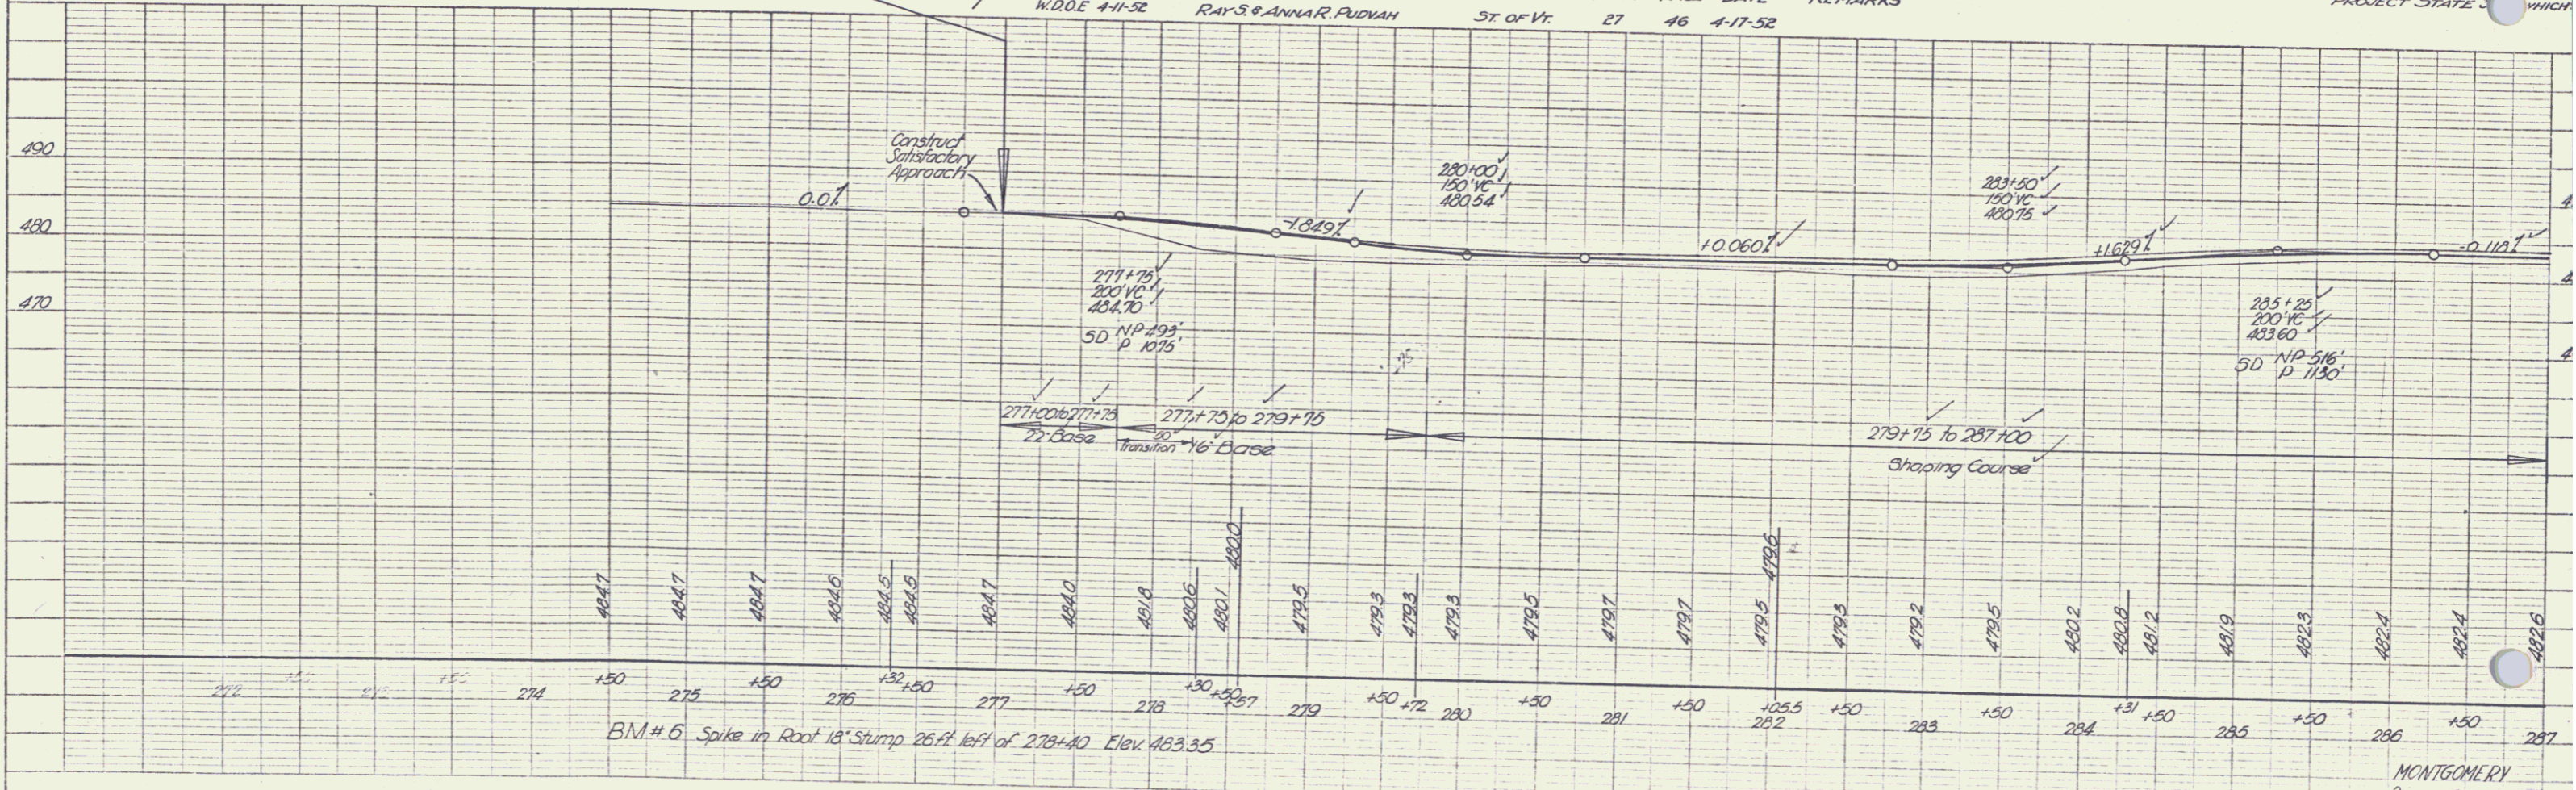


PLAN  
 DATE: 3/78  
 BY: J. J. [unclear]  
 CHECKED: [unclear]  
 TITLE: [unclear]  
 PROJECT: [unclear]

PROFILE  
 DATE: 3/78  
 BY: [unclear]  
 CHECKED: [unclear]  
 TITLE: [unclear]  
 PROJECT: [unclear]

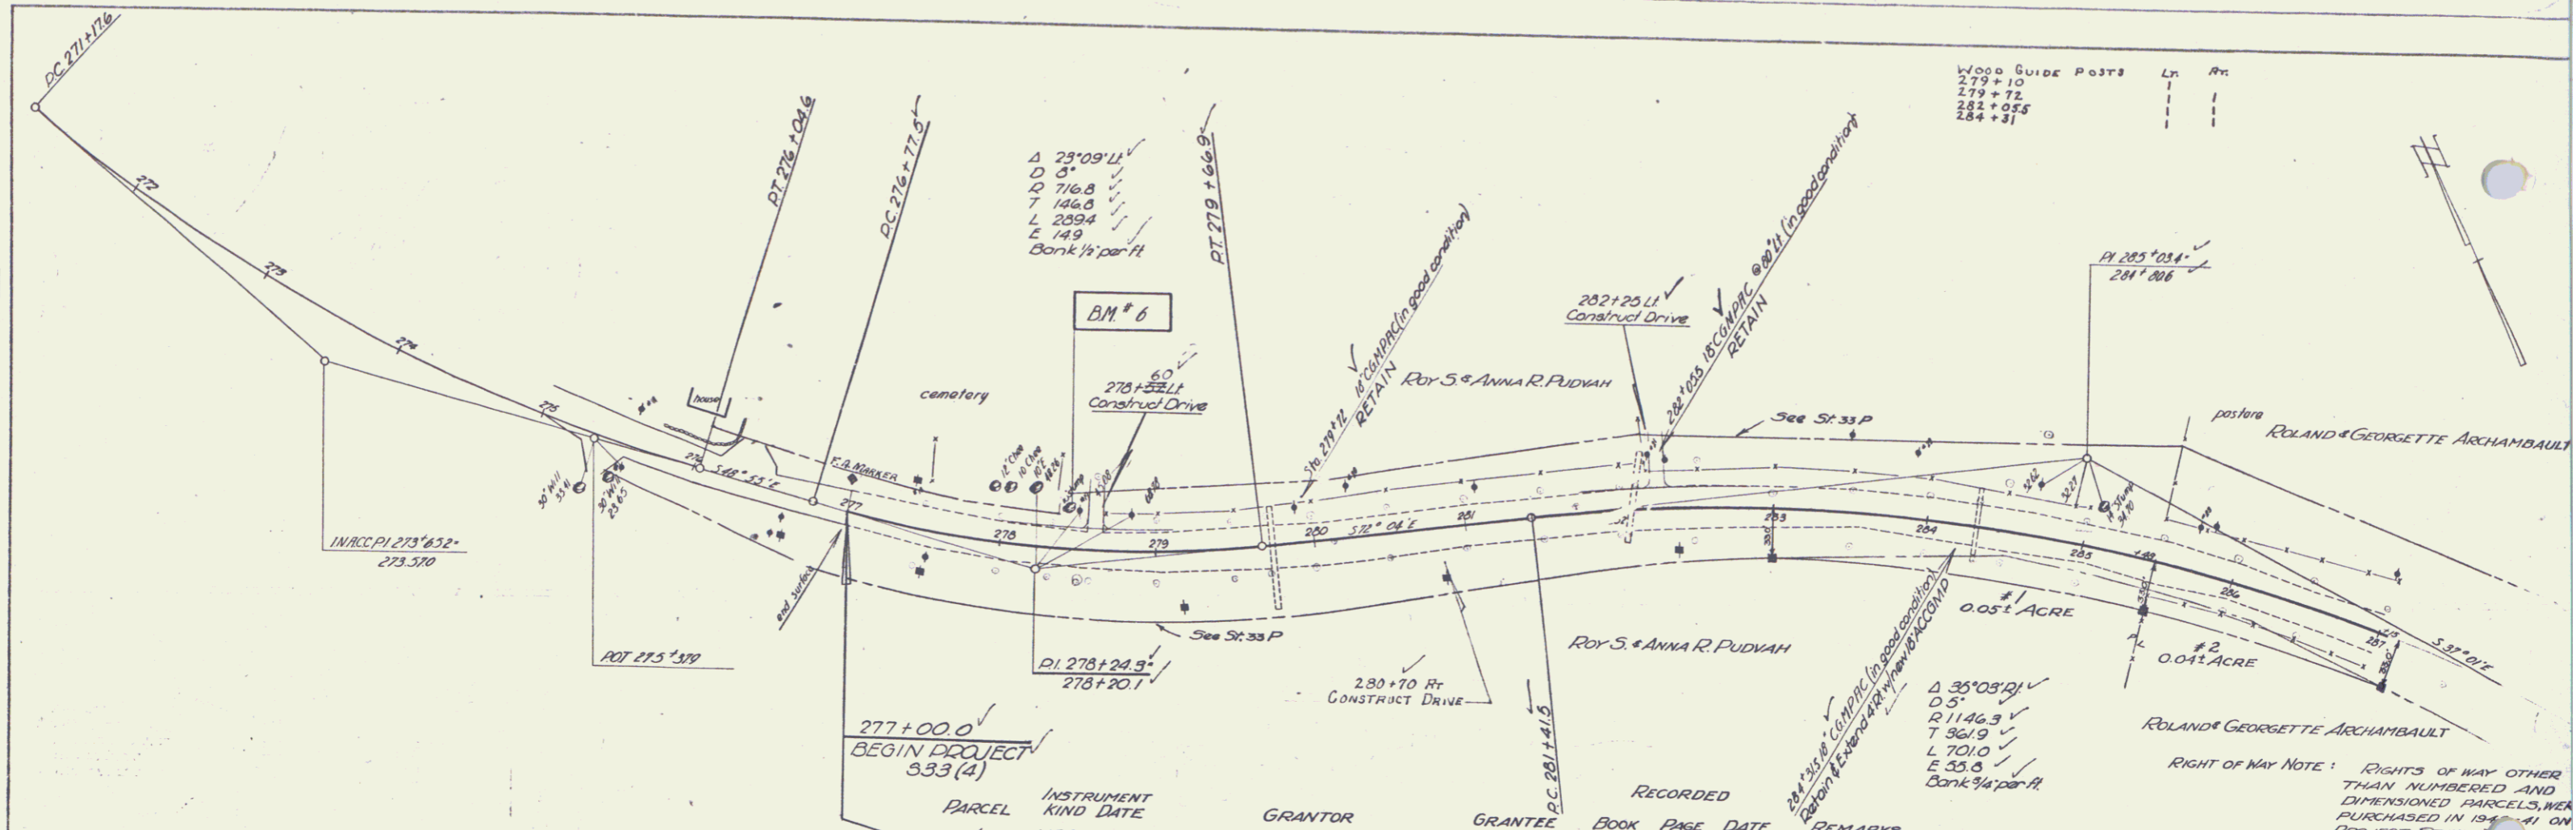

MONTGOMERY  
 PROJECTS no. 33 (4)  
 Sheet 9 of 44