

PLAN	DESIGNED BY	Spanning
	DRAWN BY	W.H.
	CHECKED BY	
	APPROVED BY	
	DATE	

PROFILE	DESIGNED BY	Spanning
	DRAWN BY	W.H.
	CHECKED BY	
	APPROVED BY	
	DATE	

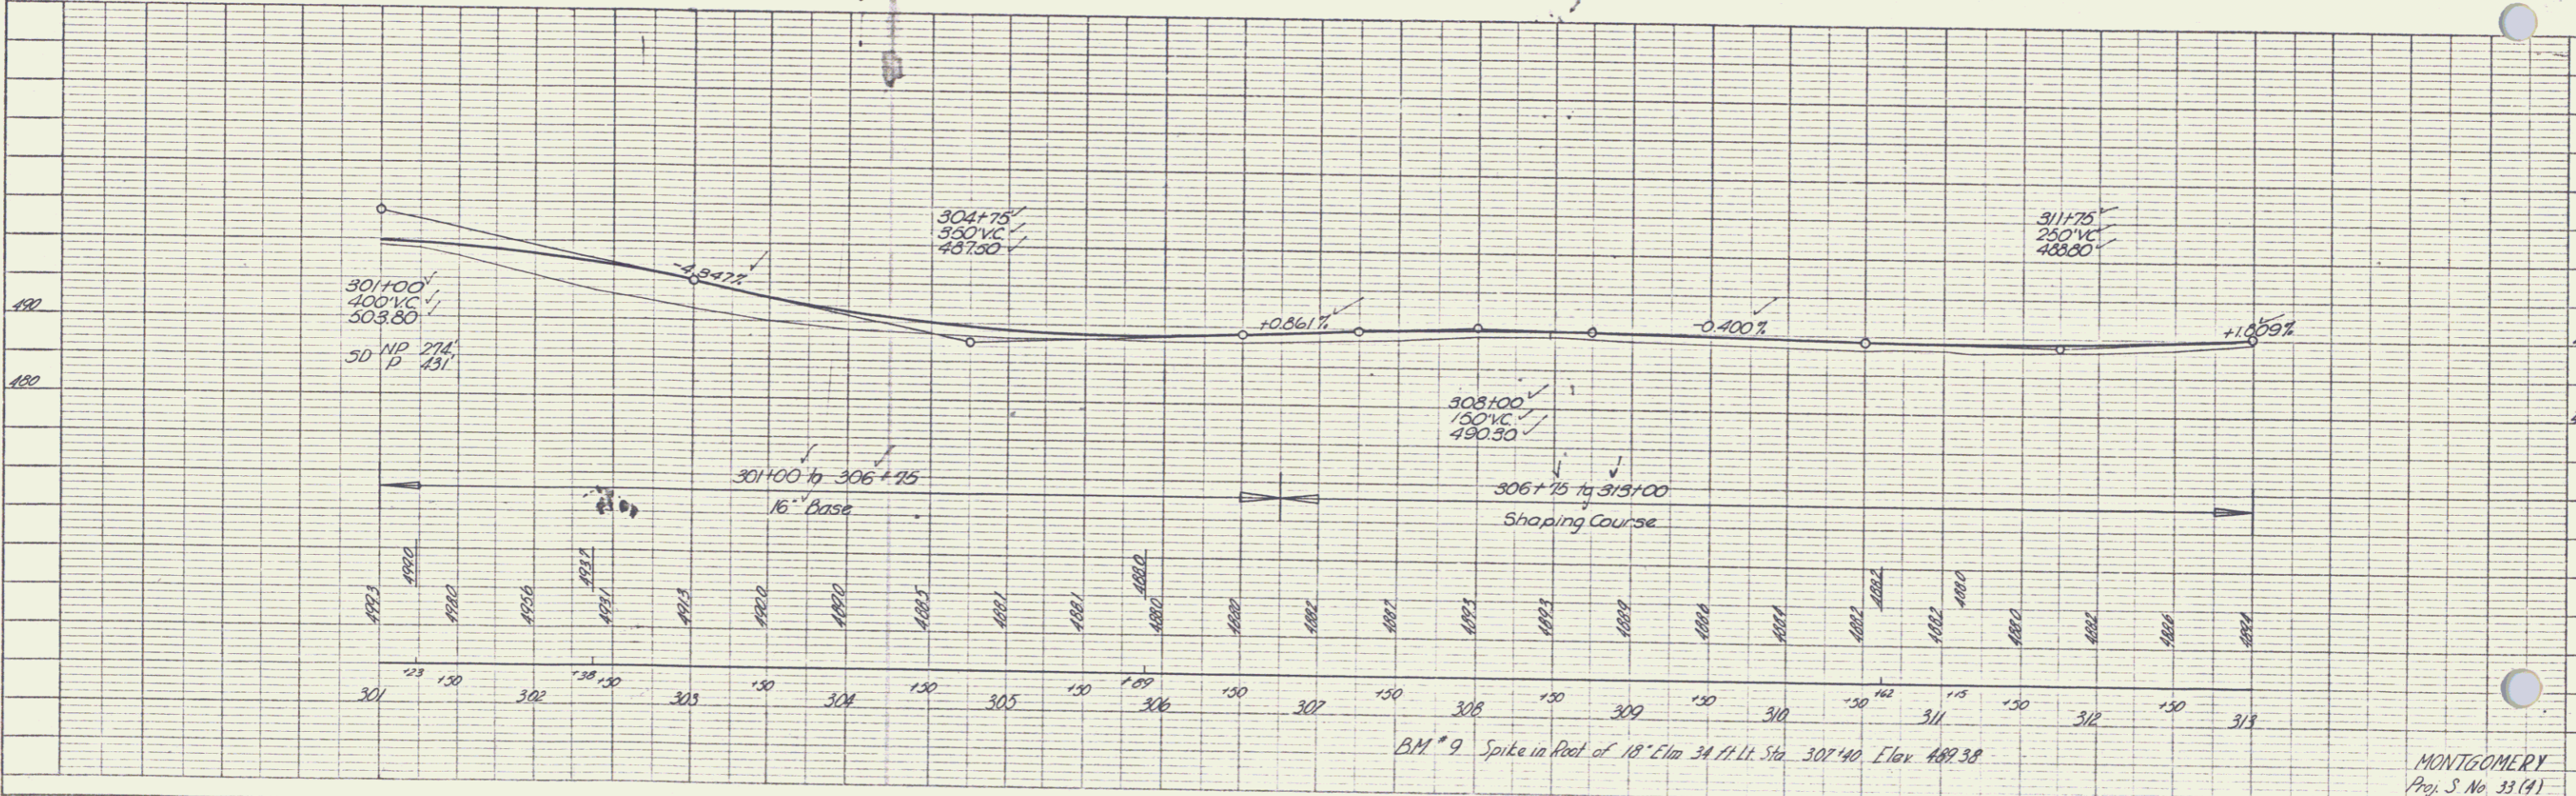
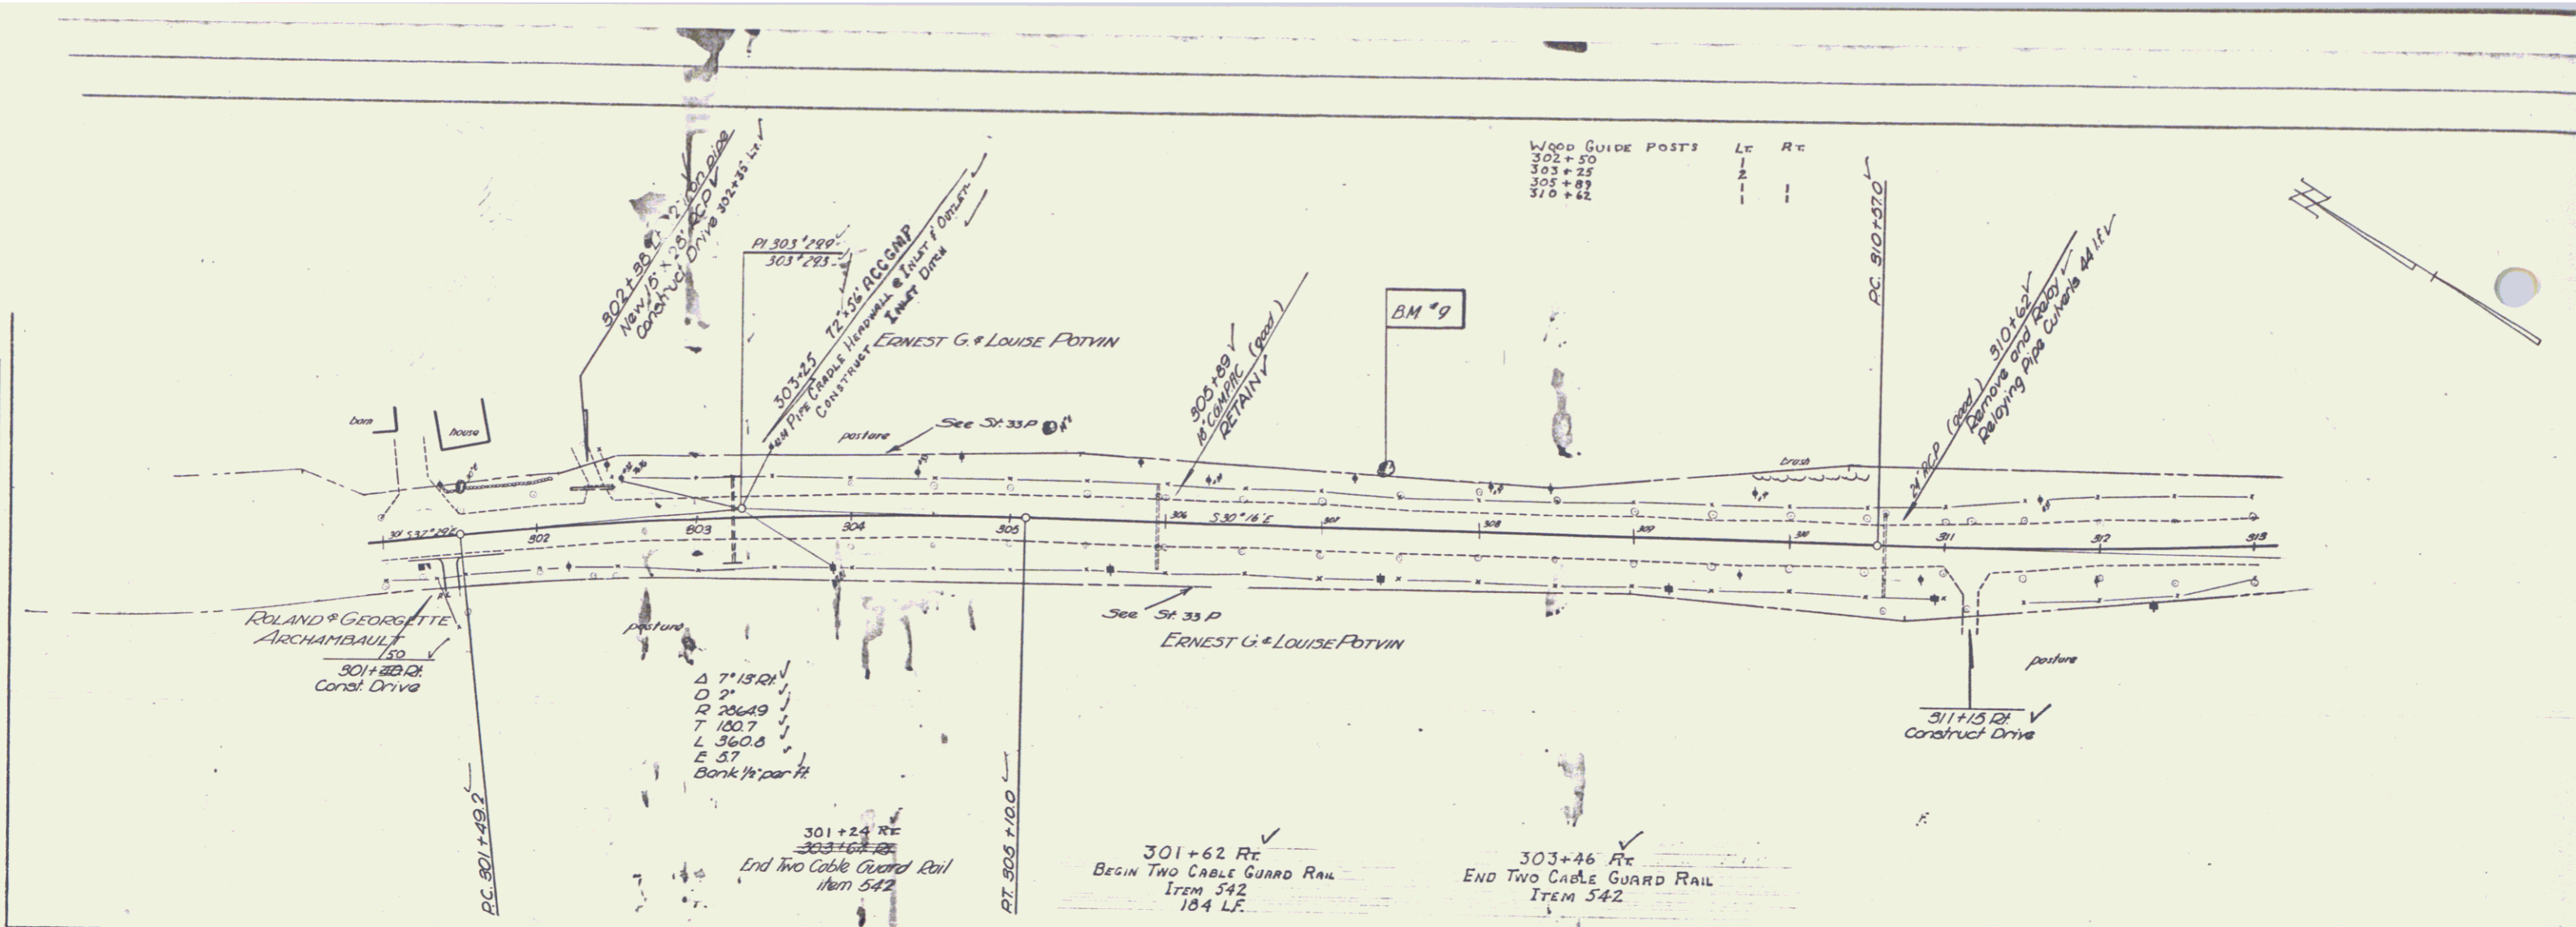


PLATE 1 - PLAN PROFILE OF R & E STATIONS
 REPTER & EIDER CO. NEW YORK
 N.Y.C. CO. IN. 24" 1" = 100'

MONTGOMERY
 Proj. S. No. 33(1)
 Sheet 11 of 44