
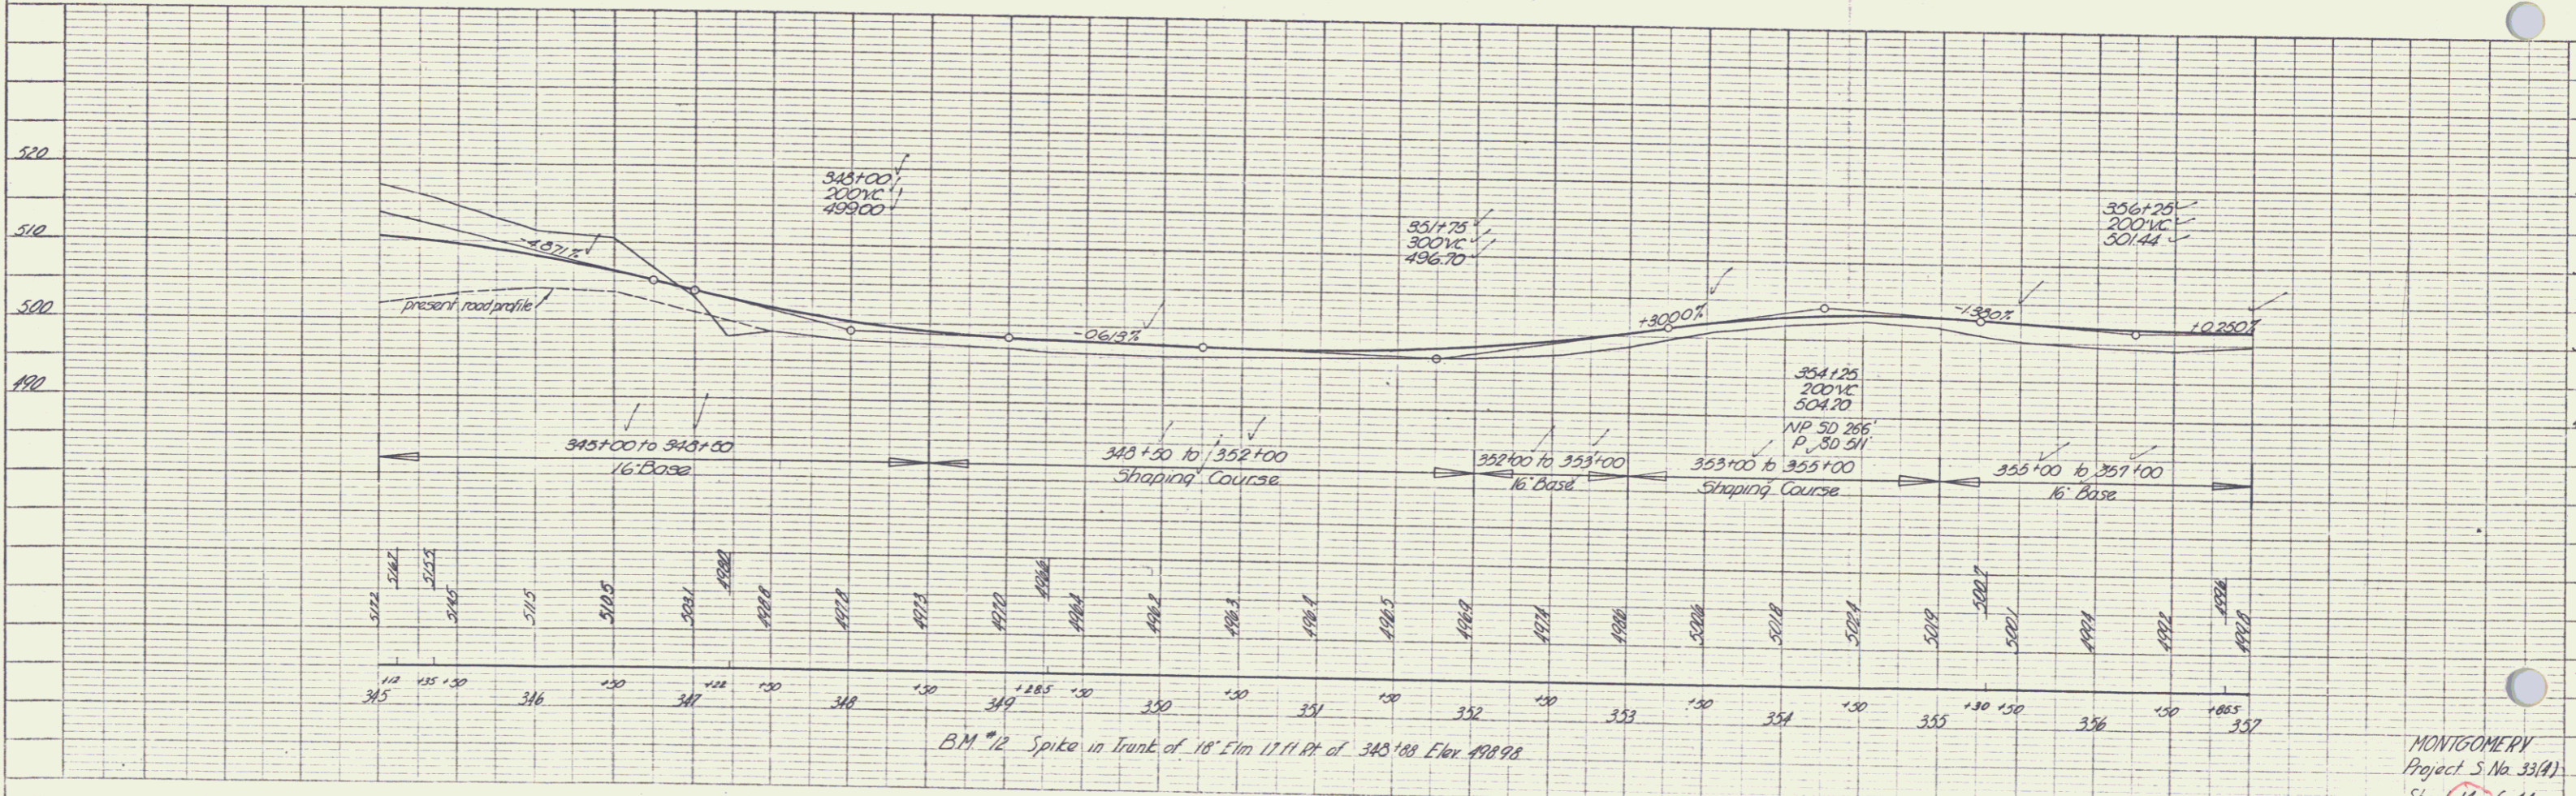


PLAN	DATE	BY
REVISED	4-18	Druiding
NOTE BOOK	4-18	Druiding
ALIGNED CHECKED		
BY		
DATE		
BY		
DATE		

PROFILE	DATE	BY
REVISED	4-18	Druiding
NOTE BOOK	4-18	Druiding
ALIGNED CHECKED		
BY		
DATE		
BY		
DATE		

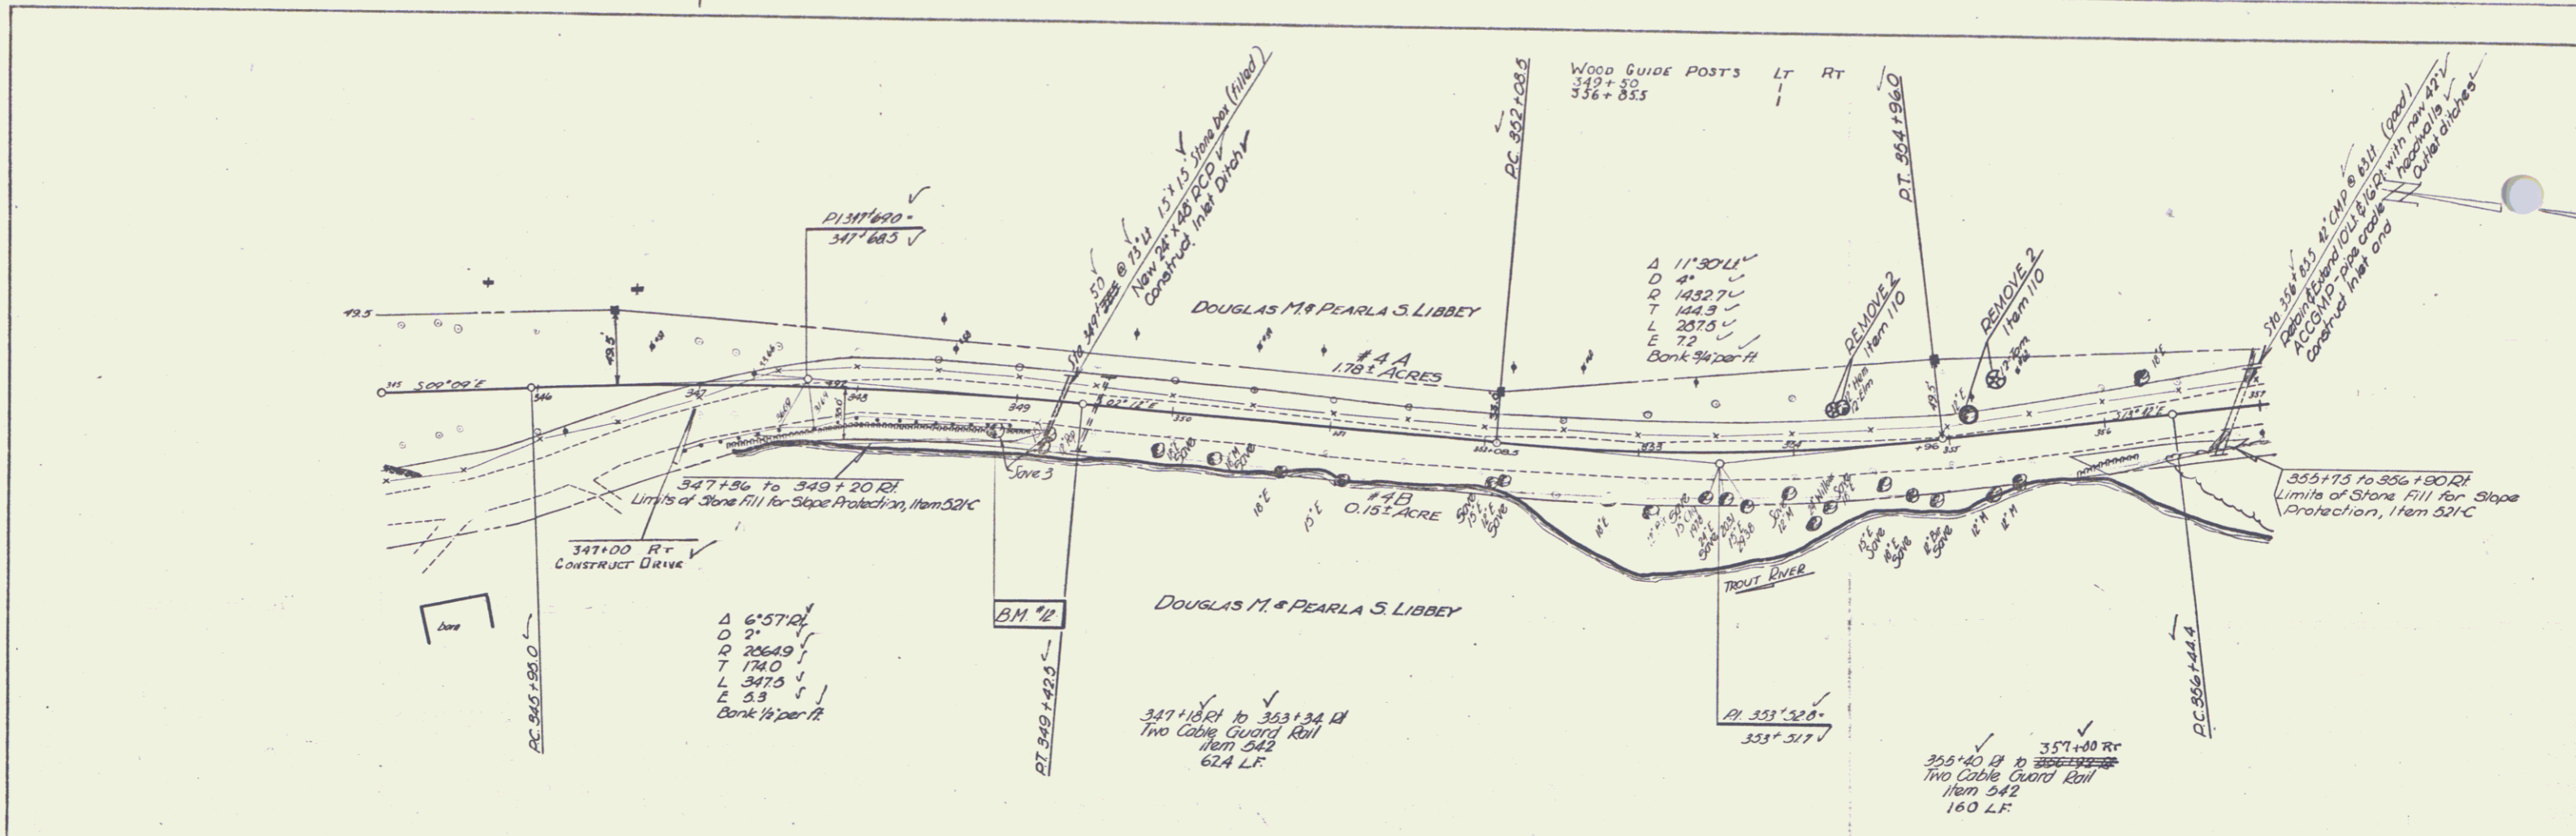

MONTGOMERY  
Project 5, No. 33(A)  
Sheet 14 of 24

PLATE 1 - PLAN & PROFILE  
MONTGOMERY PROJECT 5, NO. 33(A)  
SHEET 14 OF 24