
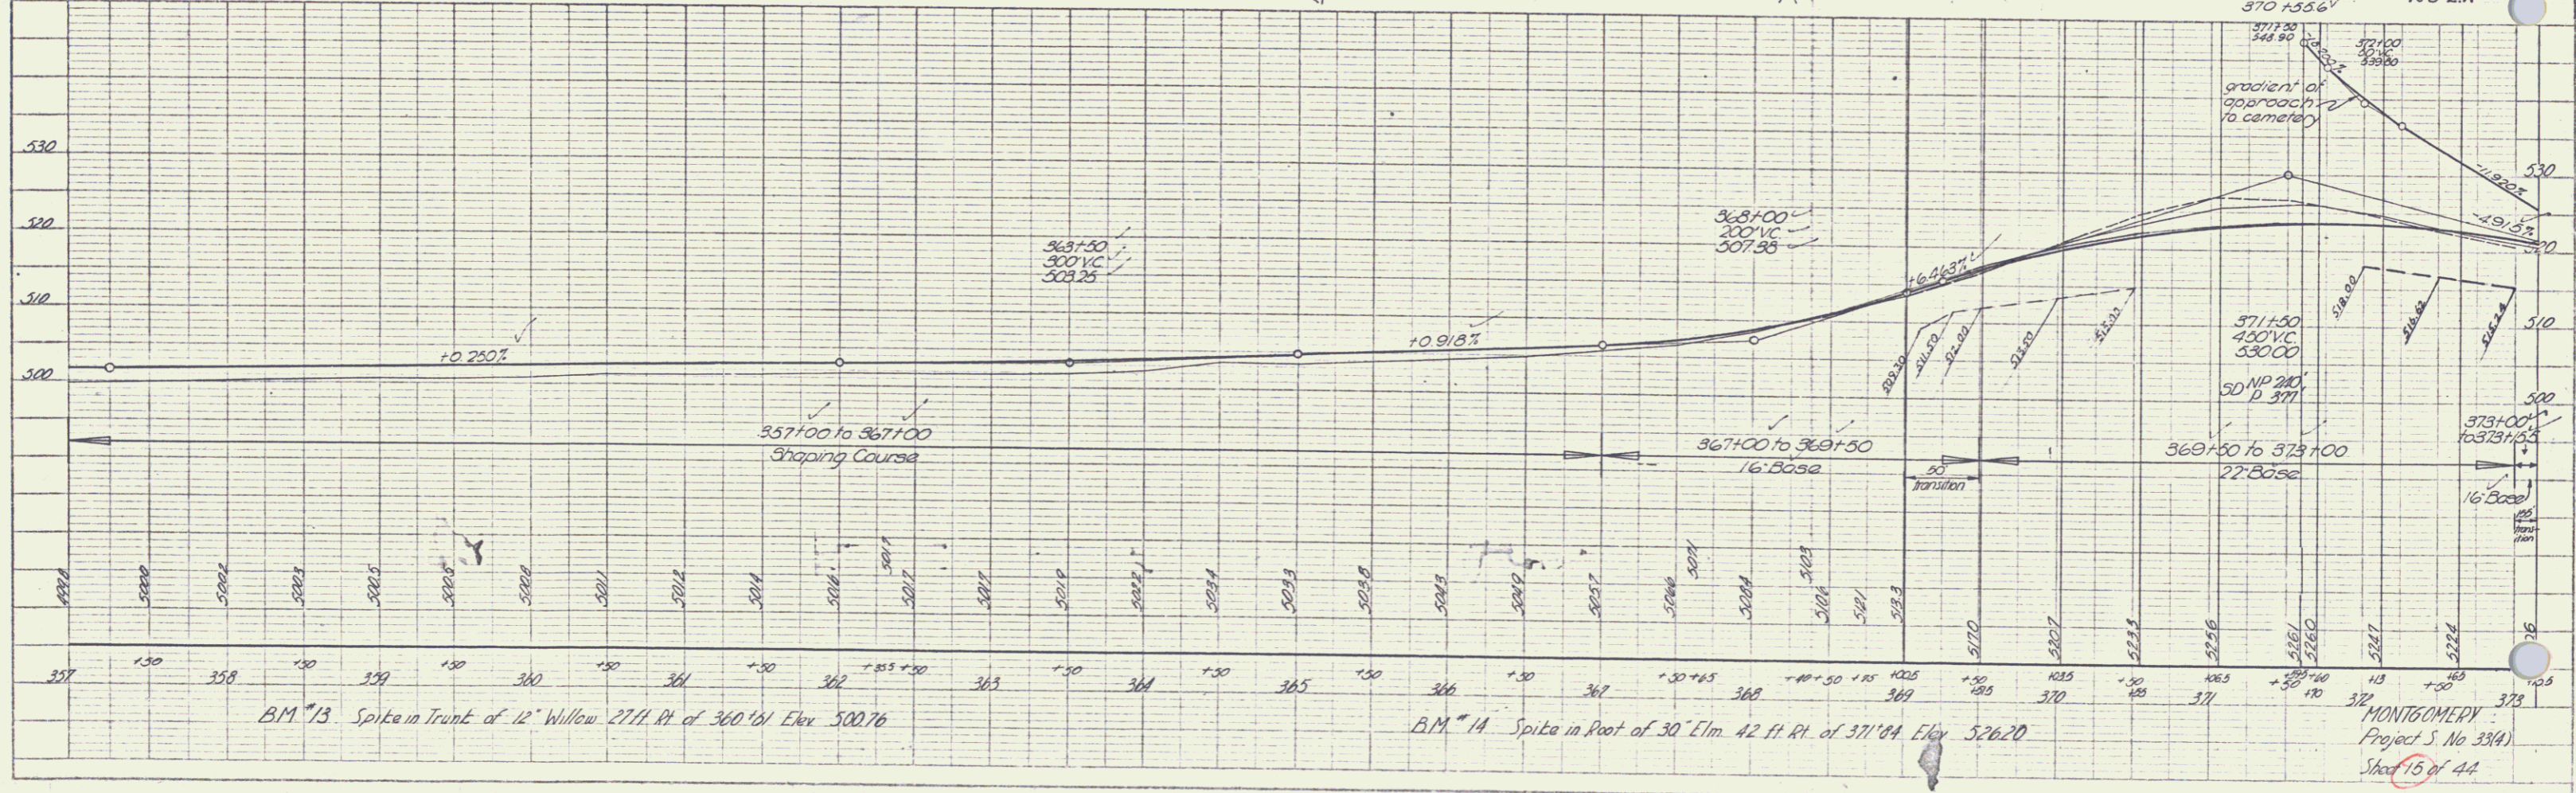


PLAN	DATE	BY
REVISIONS		
1	1/1/11	SP
2	1/1/11	SP
3	1/1/11	SP
4	1/1/11	SP
5	1/1/11	SP
6	1/1/11	SP
7	1/1/11	SP
8	1/1/11	SP
9	1/1/11	SP
10	1/1/11	SP

PROFILE	DATE	BY
REVISIONS		
1	1/1/11	SP
2	1/1/11	SP
3	1/1/11	SP
4	1/1/11	SP
5	1/1/11	SP
6	1/1/11	SP
7	1/1/11	SP
8	1/1/11	SP
9	1/1/11	SP
10	1/1/11	SP

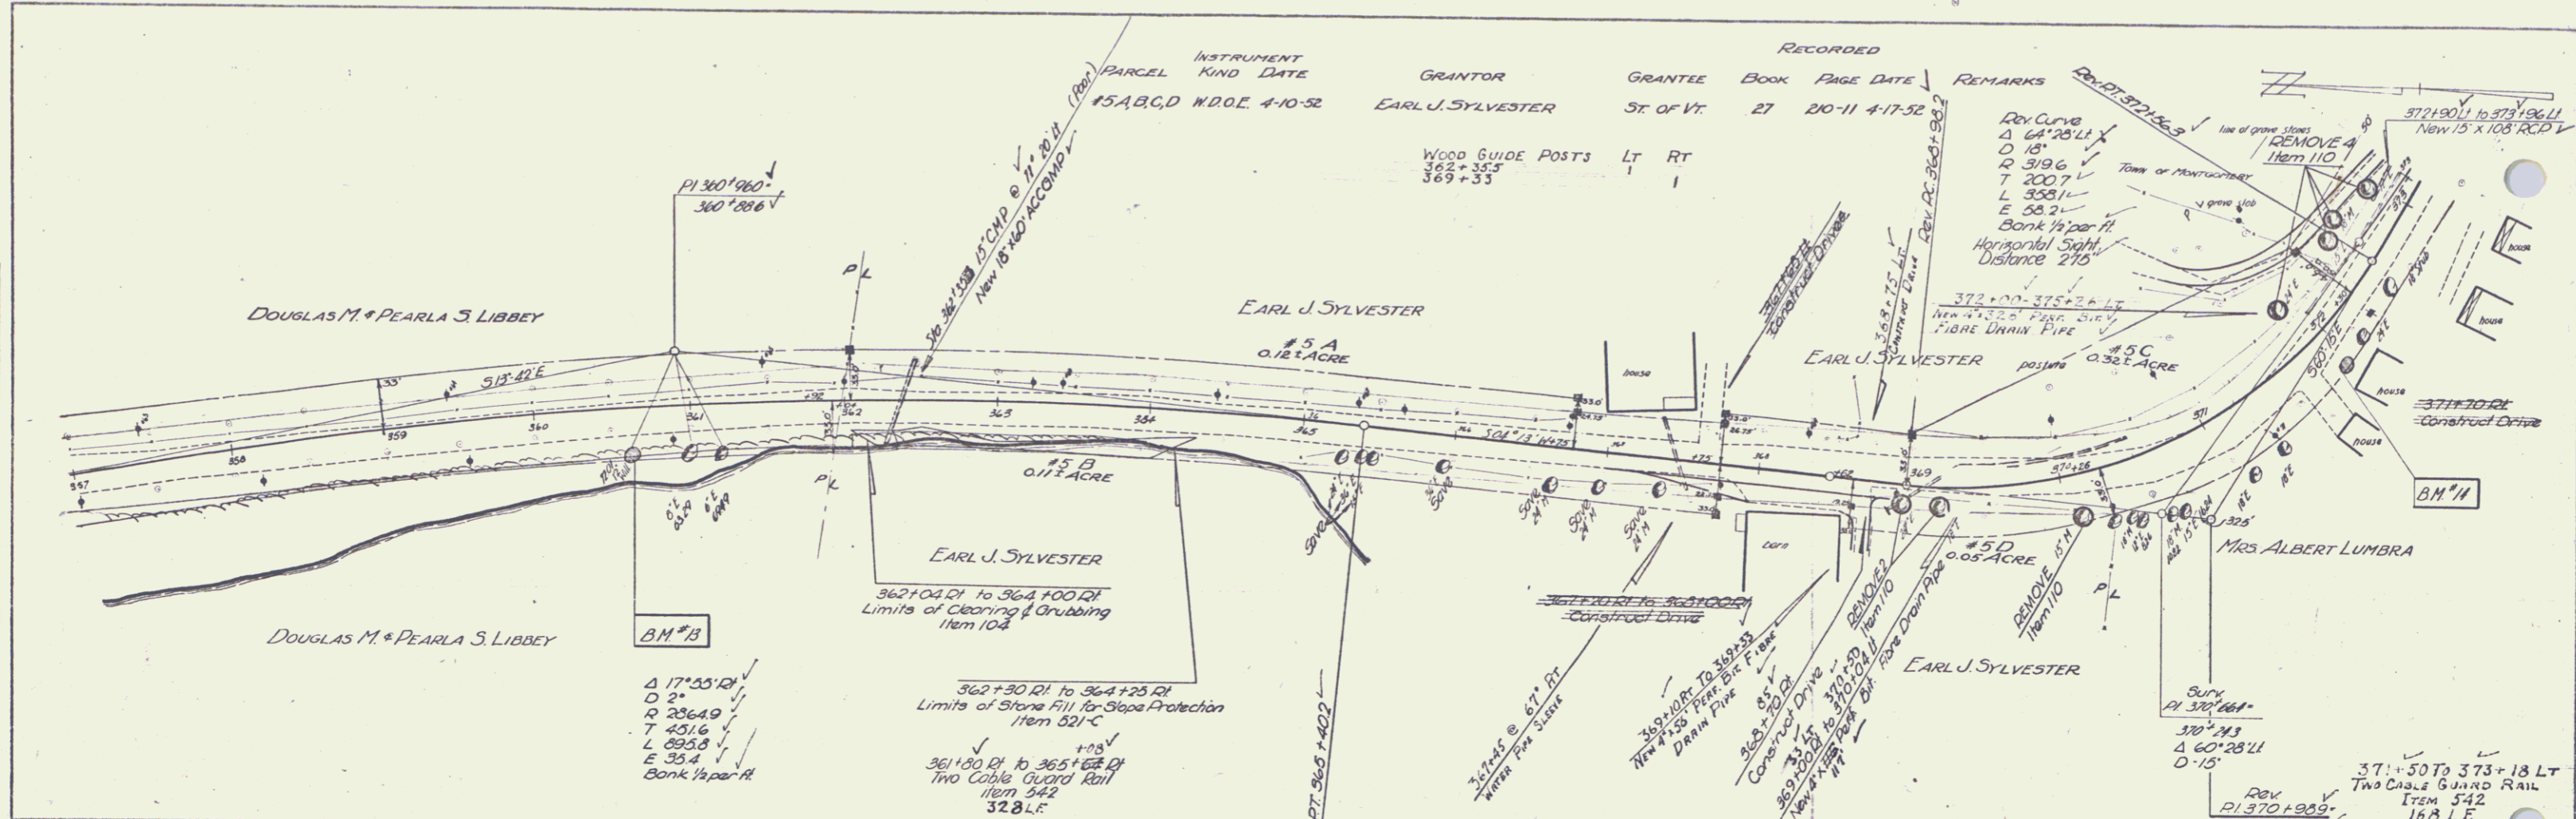

PLAN & PROFILE OF ROAD
 HORIZONTAL & VERTICAL CURVES
 J. B. CO. INC. ENGINEERS
 MONTGOMERY, ALA.

MONTGOMERY
 Project No. 3394
 Sheet 15 of 44