
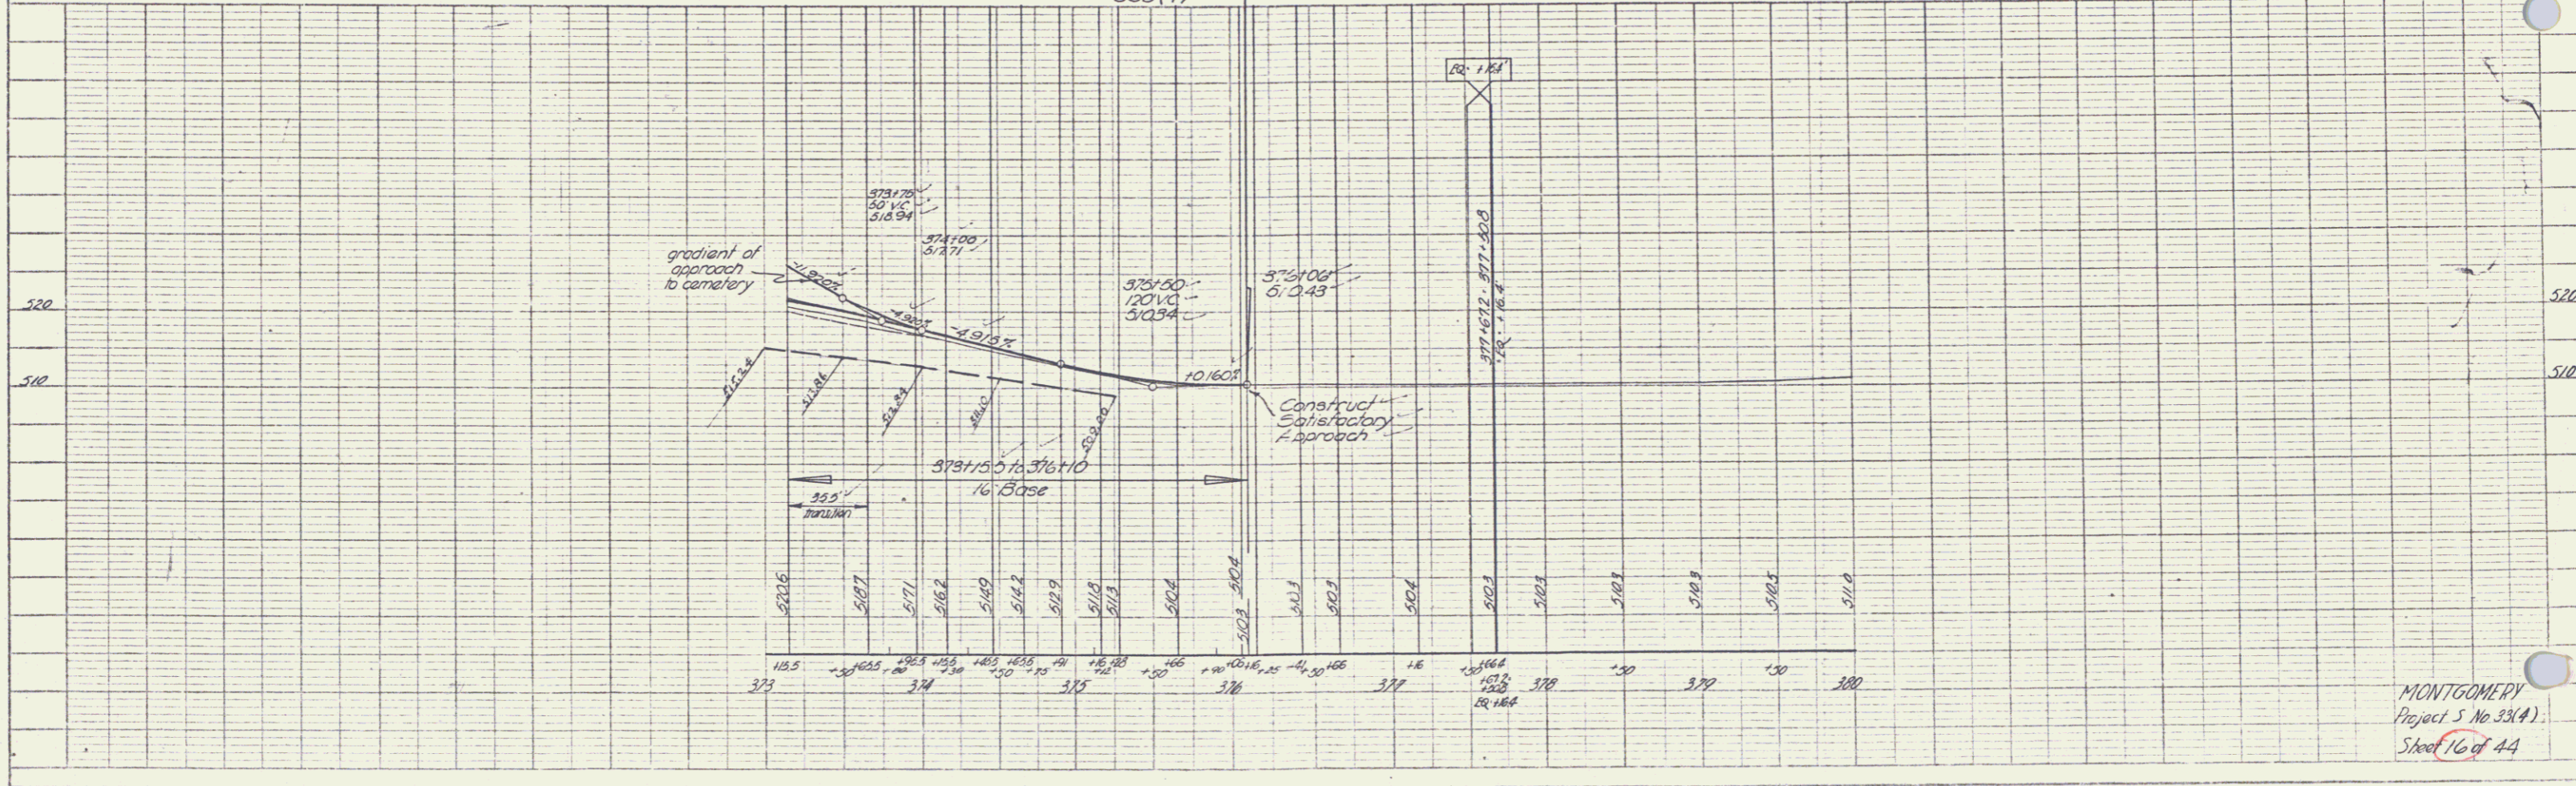


PLAN  
 DATE: 1/10/52  
 DRAWN BY: [Signature]  
 CHECKED BY: [Signature]  
 TITLE: [Project Name]  
 SHEET NO.: 16 of 44

PROFILE  
 DATE: 1/10/52  
 DRAWN BY: [Signature]  
 CHECKED BY: [Signature]  
 TITLE: [Project Name]  
 SHEET NO.: 16 of 44

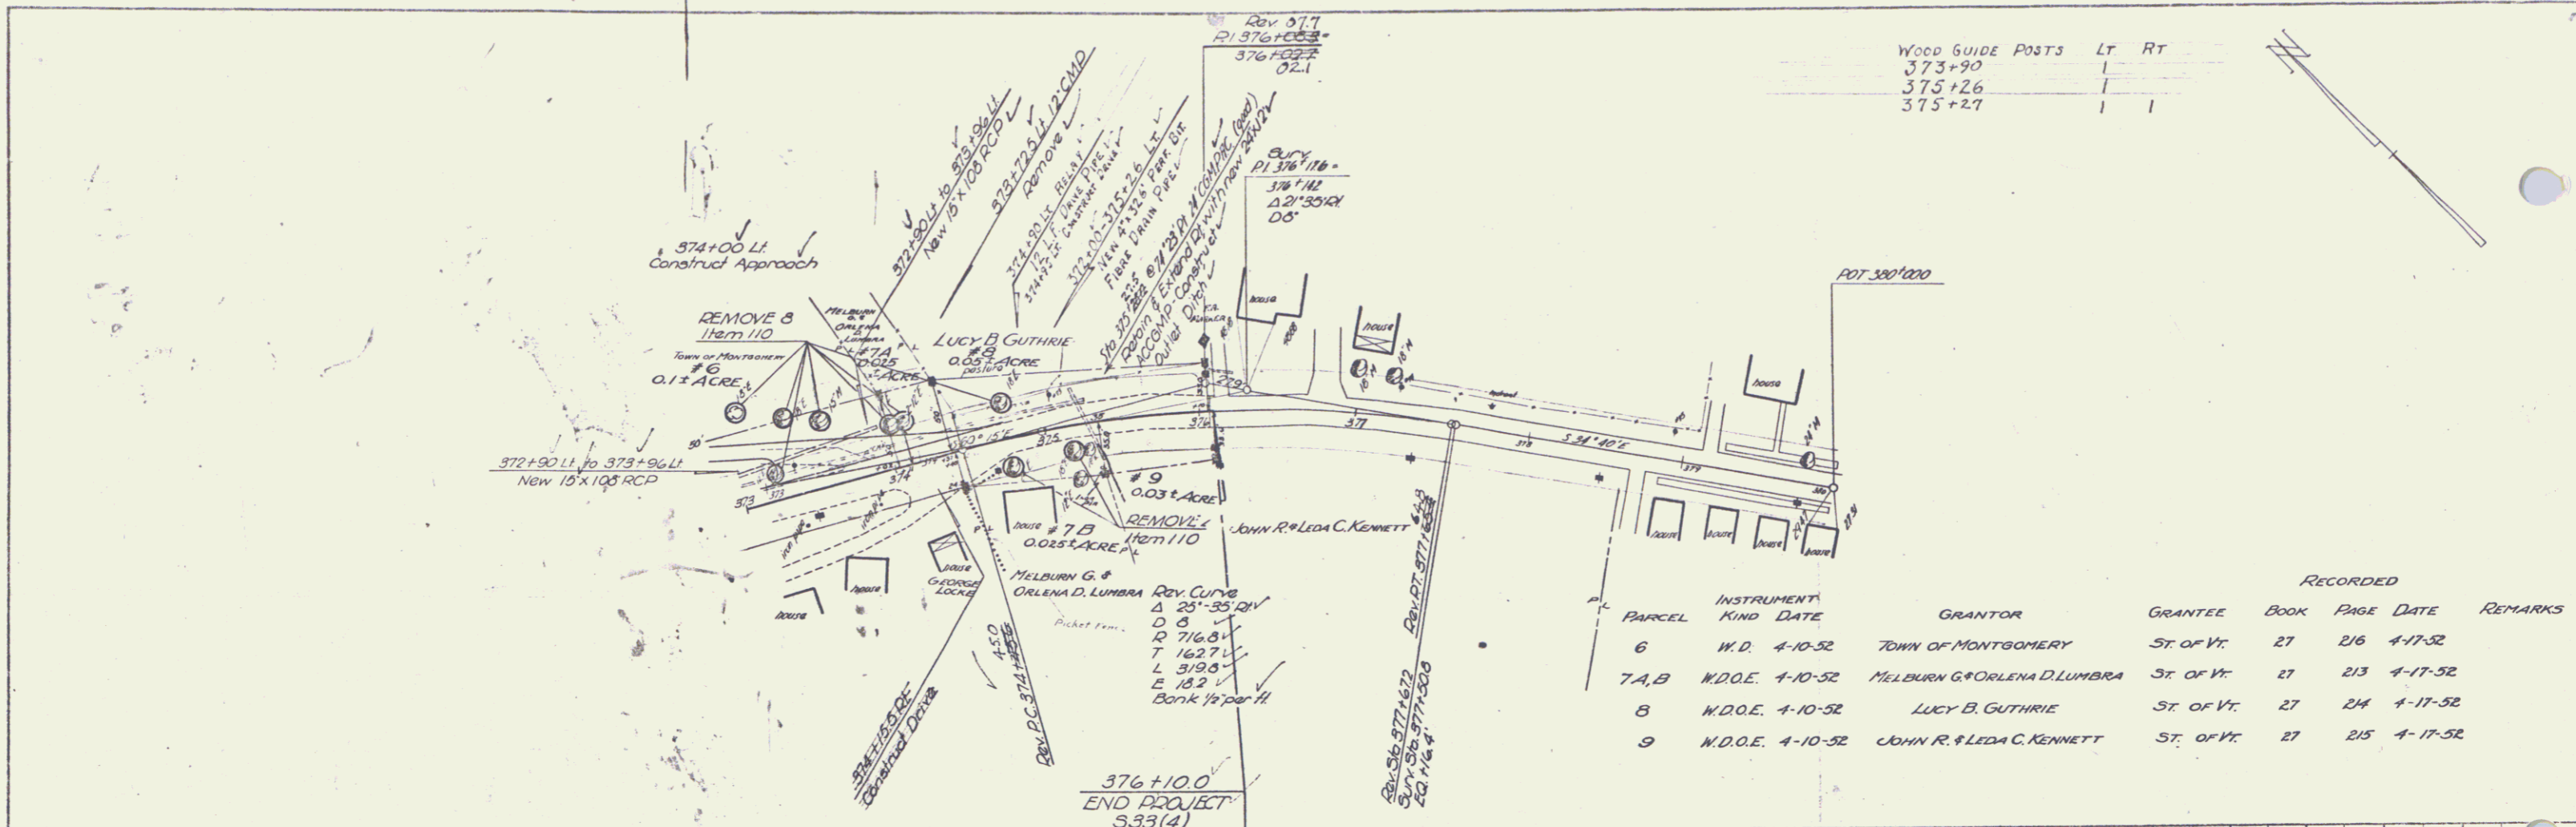

MONTGOMERY  
 Project 5 No. 33(4)  
 Sheet 16 of 44