



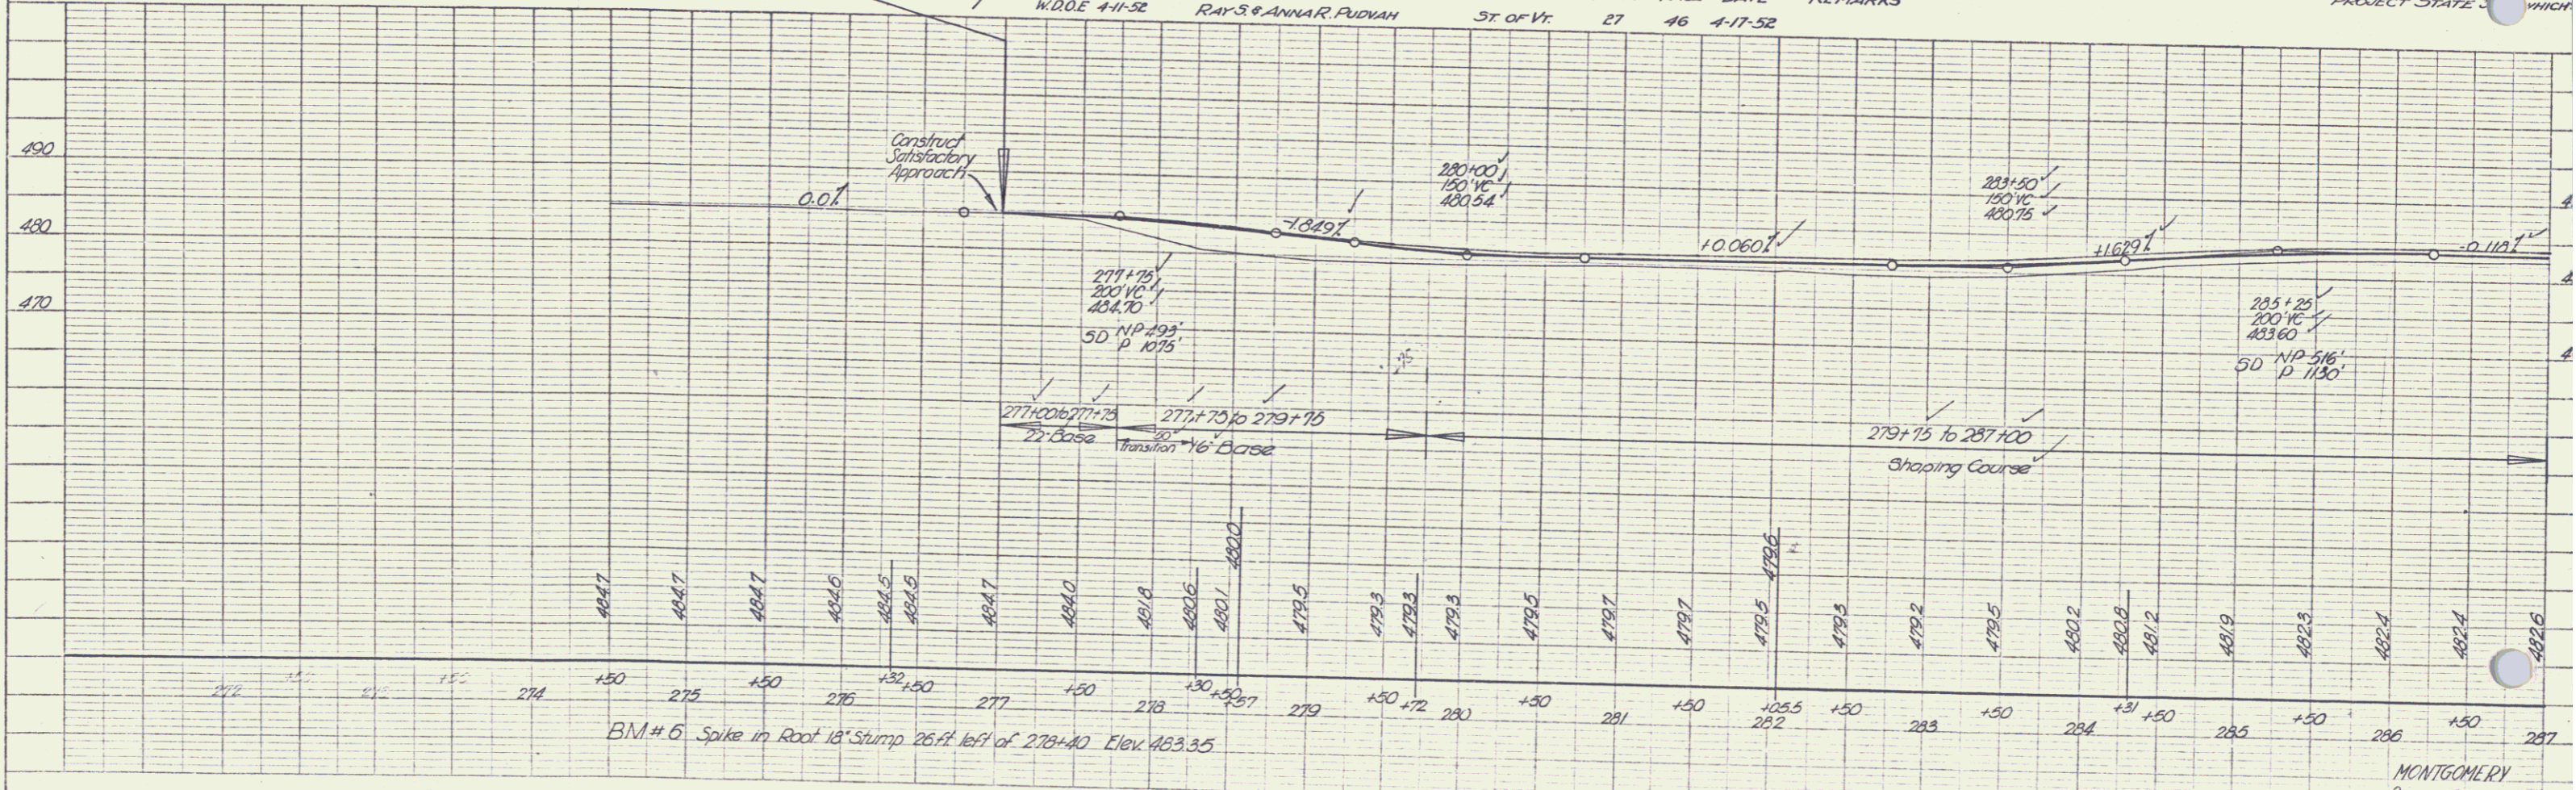

PLAN  
 DATE: 3/78  
 BY: J. J. [unclear]  
 CHECKED: [unclear]  
 TITLE: [unclear]  
 PROJECT: [unclear]

PROFILE  
 DATE: 3/78  
 BY: [unclear]  
 CHECKED: [unclear]  
 TITLE: [unclear]  
 PROJECT: [unclear]

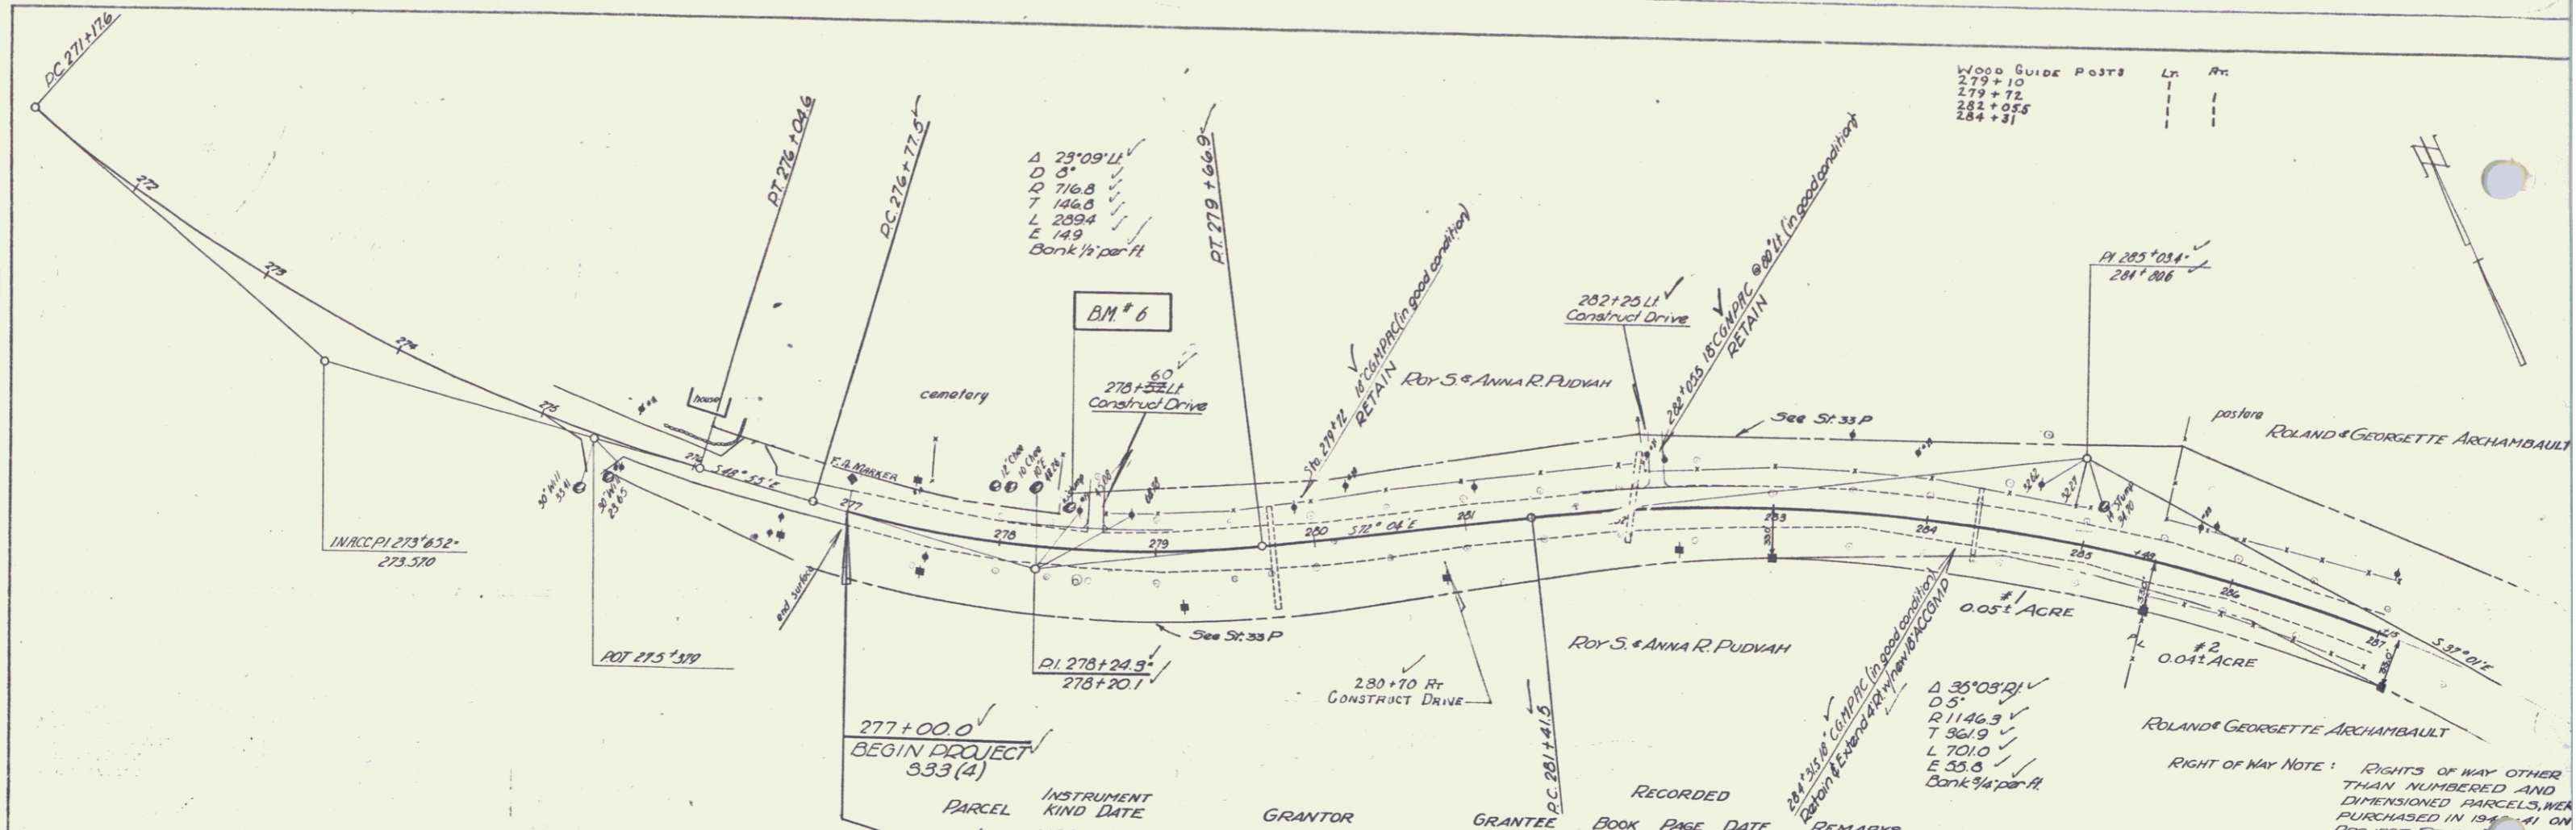

PARCEL	INSTRUMENT KIND DATE	GRANTOR	GRANTEE	BOOK PAGE DATE	REMARKS
1	W.D.O.E. 4-11-52	RAY S. & ANNA R. PUDVAH	ST. OF VT.	27 46 4-17-52	

RIGHT OF WAY NOTE: RIGHTS OF WAY OTHER THAN NUMBERED AND DIMENSIONED PARCELS, WERE PURCHASED IN 1940-41 ON PROJECT STATE OF VT. WHICH

PLAN  
 DATE: 4-17-52  
 BY: J.P.P.  
 CHECKED: J.P.P.  
 INSTRUMENT: 2  
 W.D.O.E. 4-10-52  
 GRANTEE: ROLAND & GEORGETTE ARCHAMBAULT  
 BOOK: 27  
 PAGE: 205  
 DATE: 4-17-52

PROFILE  
 DATE: 4-17-52  
 BY: J.P.P.  
 CHECKED: J.P.P.  
 INSTRUMENT: 2  
 W.D.O.E. 4-10-52  
 GRANTEE: ROLAND & GEORGETTE ARCHAMBAULT  
 BOOK: 27  
 PAGE: 205  
 DATE: 4-17-52

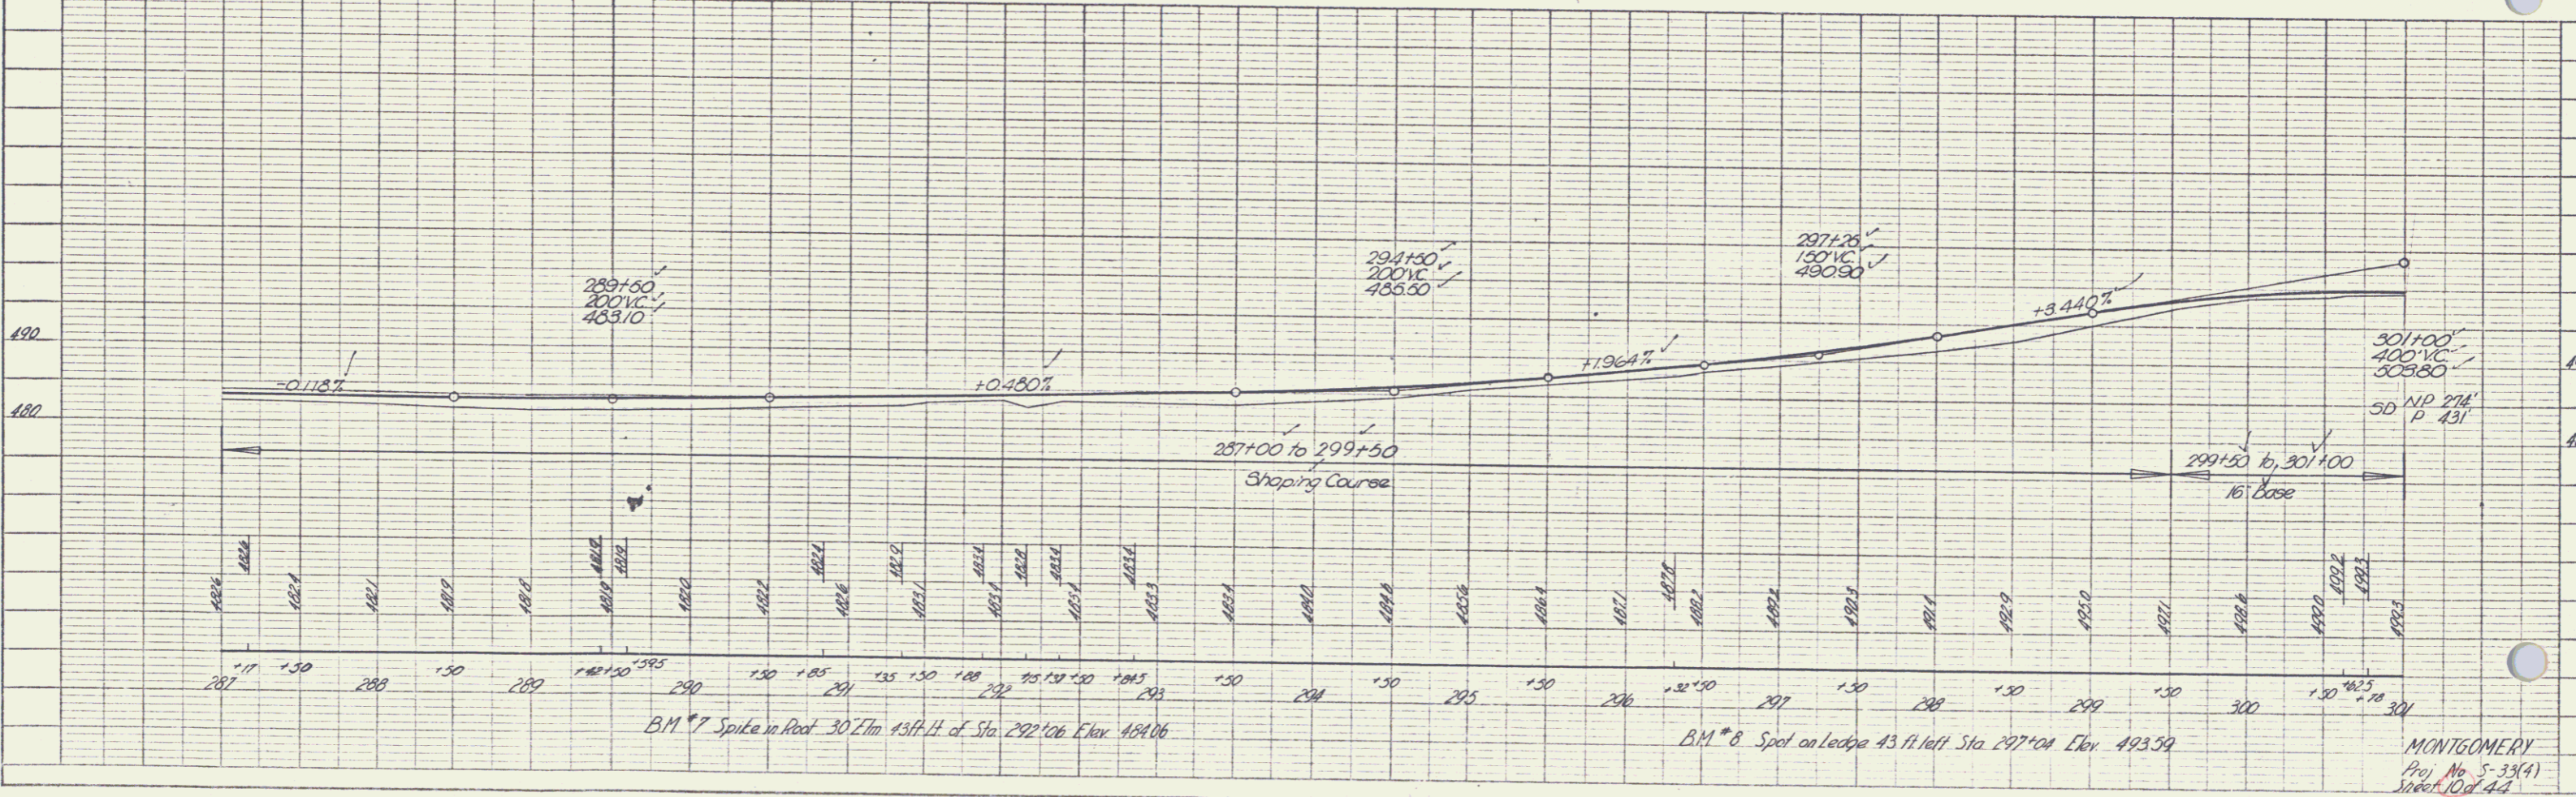
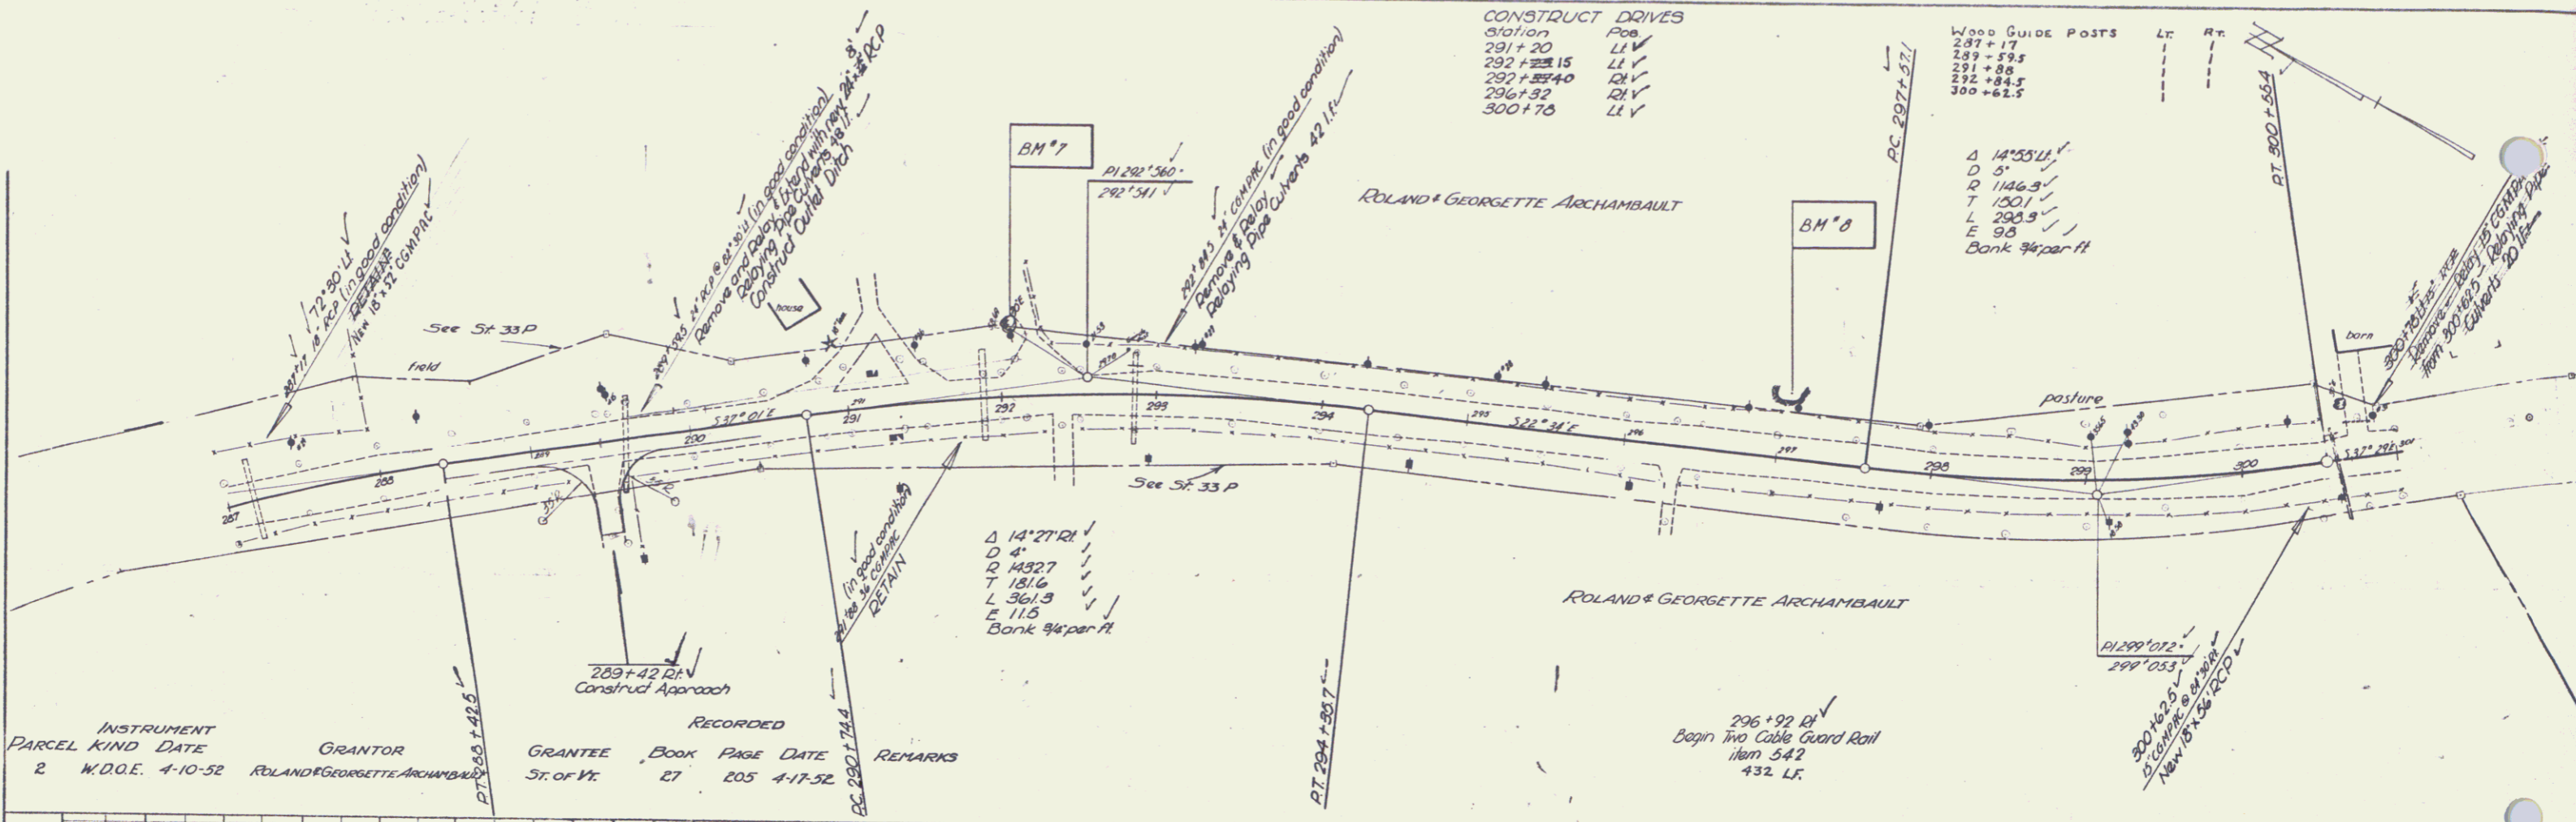


PLATE 1 - PLAN - PROFILE - P. & S. E. OF ROAD  
 MONTGOMERY  
 Proj. No. S-33(4)  
 Date: 10-1-52

PLAN	DESIGNED BY	Spanning
	DRAWN BY	W.H.
	CHECKED BY	
	APPROVED BY	
	DATE	

PROFILE	DESIGNED BY	Spanning
	DRAWN BY	W.H.
	CHECKED BY	
	APPROVED BY	
	DATE	


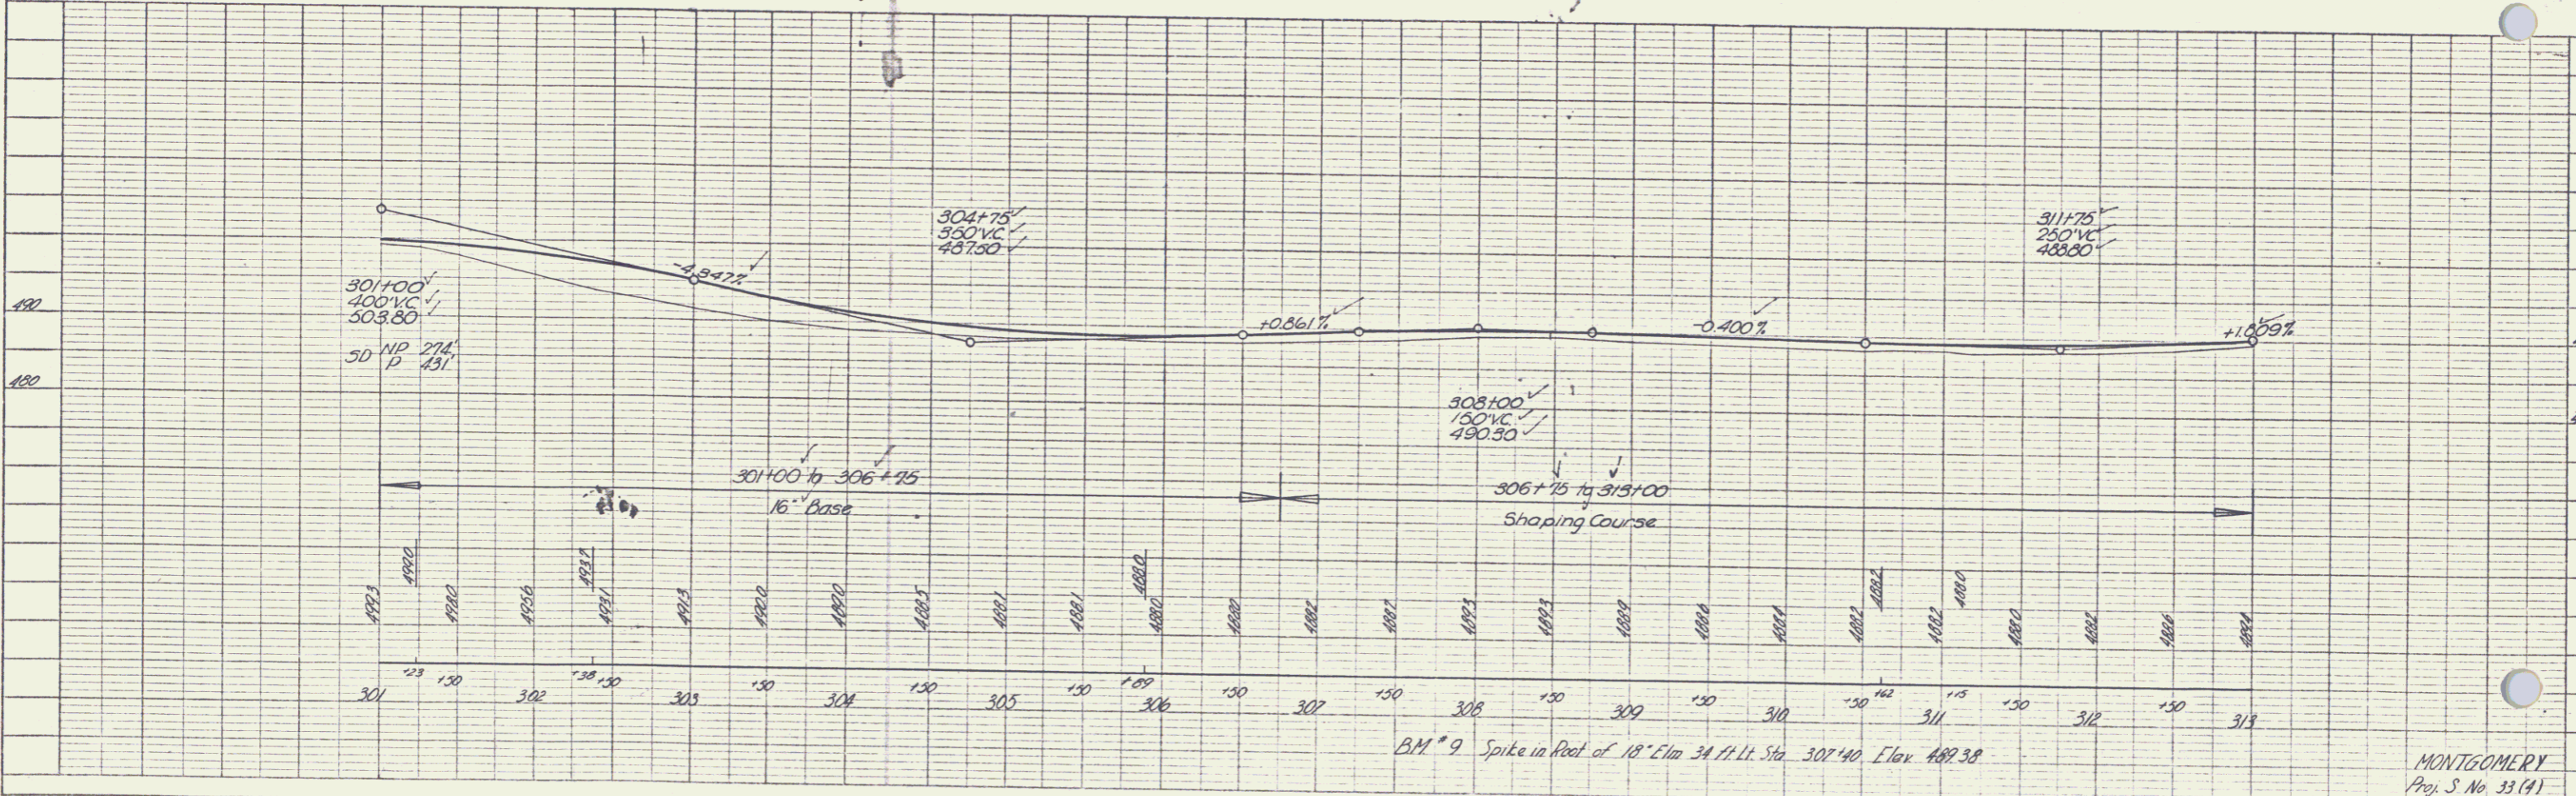


PLATE 1-PLAN PROFILE C.P.R. & E. STATIONING  
 KEPPNER & EIDER CO. NEW YORK  
 N.Y.C. CO. INC. 345 1/2 ST. 1908



MONTGOMERY  
 Proj. S. No. 33(1)  
 Sheet 11 of 44



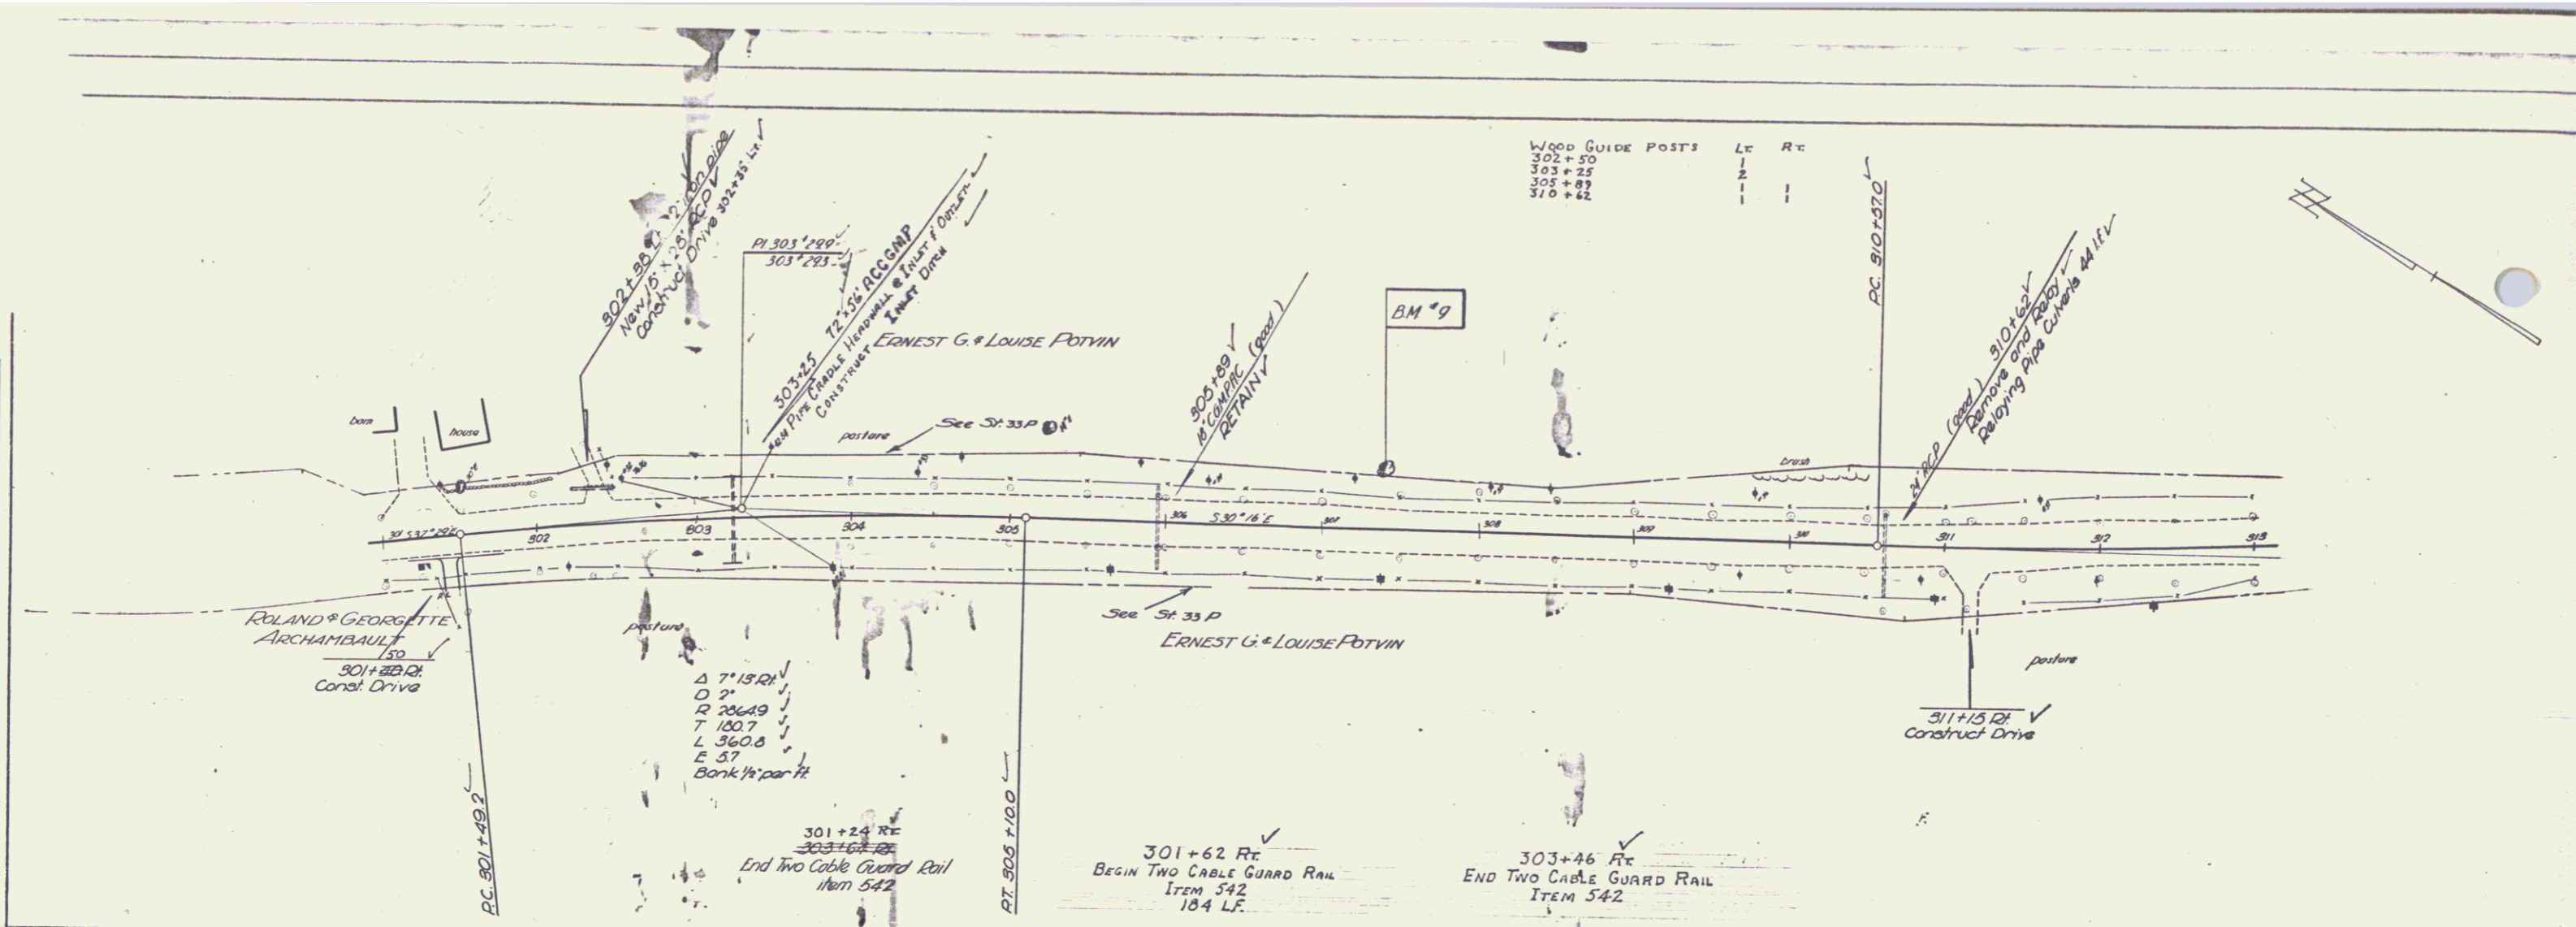

PLAN	DATE	BY
NOTE BOOK	4-18	D. J. ...
ALIGNED CHECKED	4-18	D. J. ...
BY		

PROFILE	DATE	BY
NOTE BOOK	4-18	D. J. ...
ALIGNED CHECKED	4-18	D. J. ...
BY		

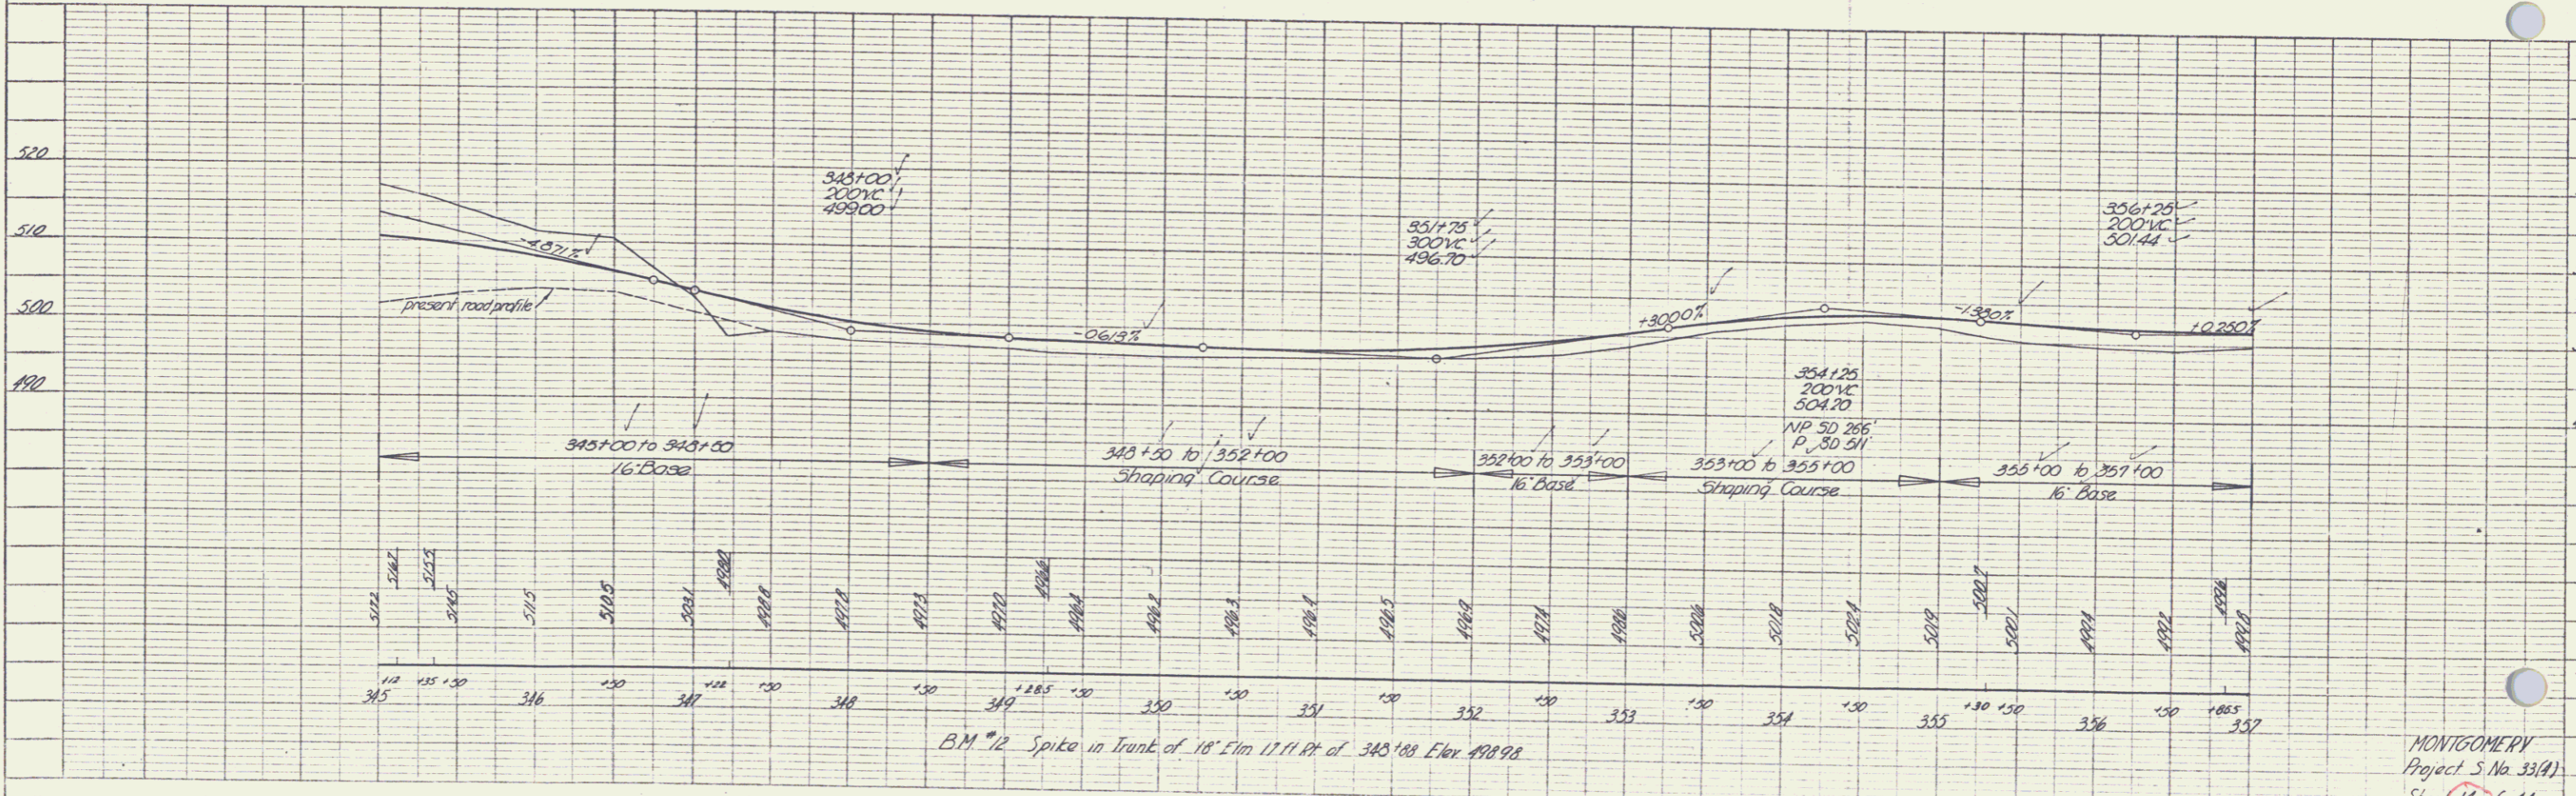
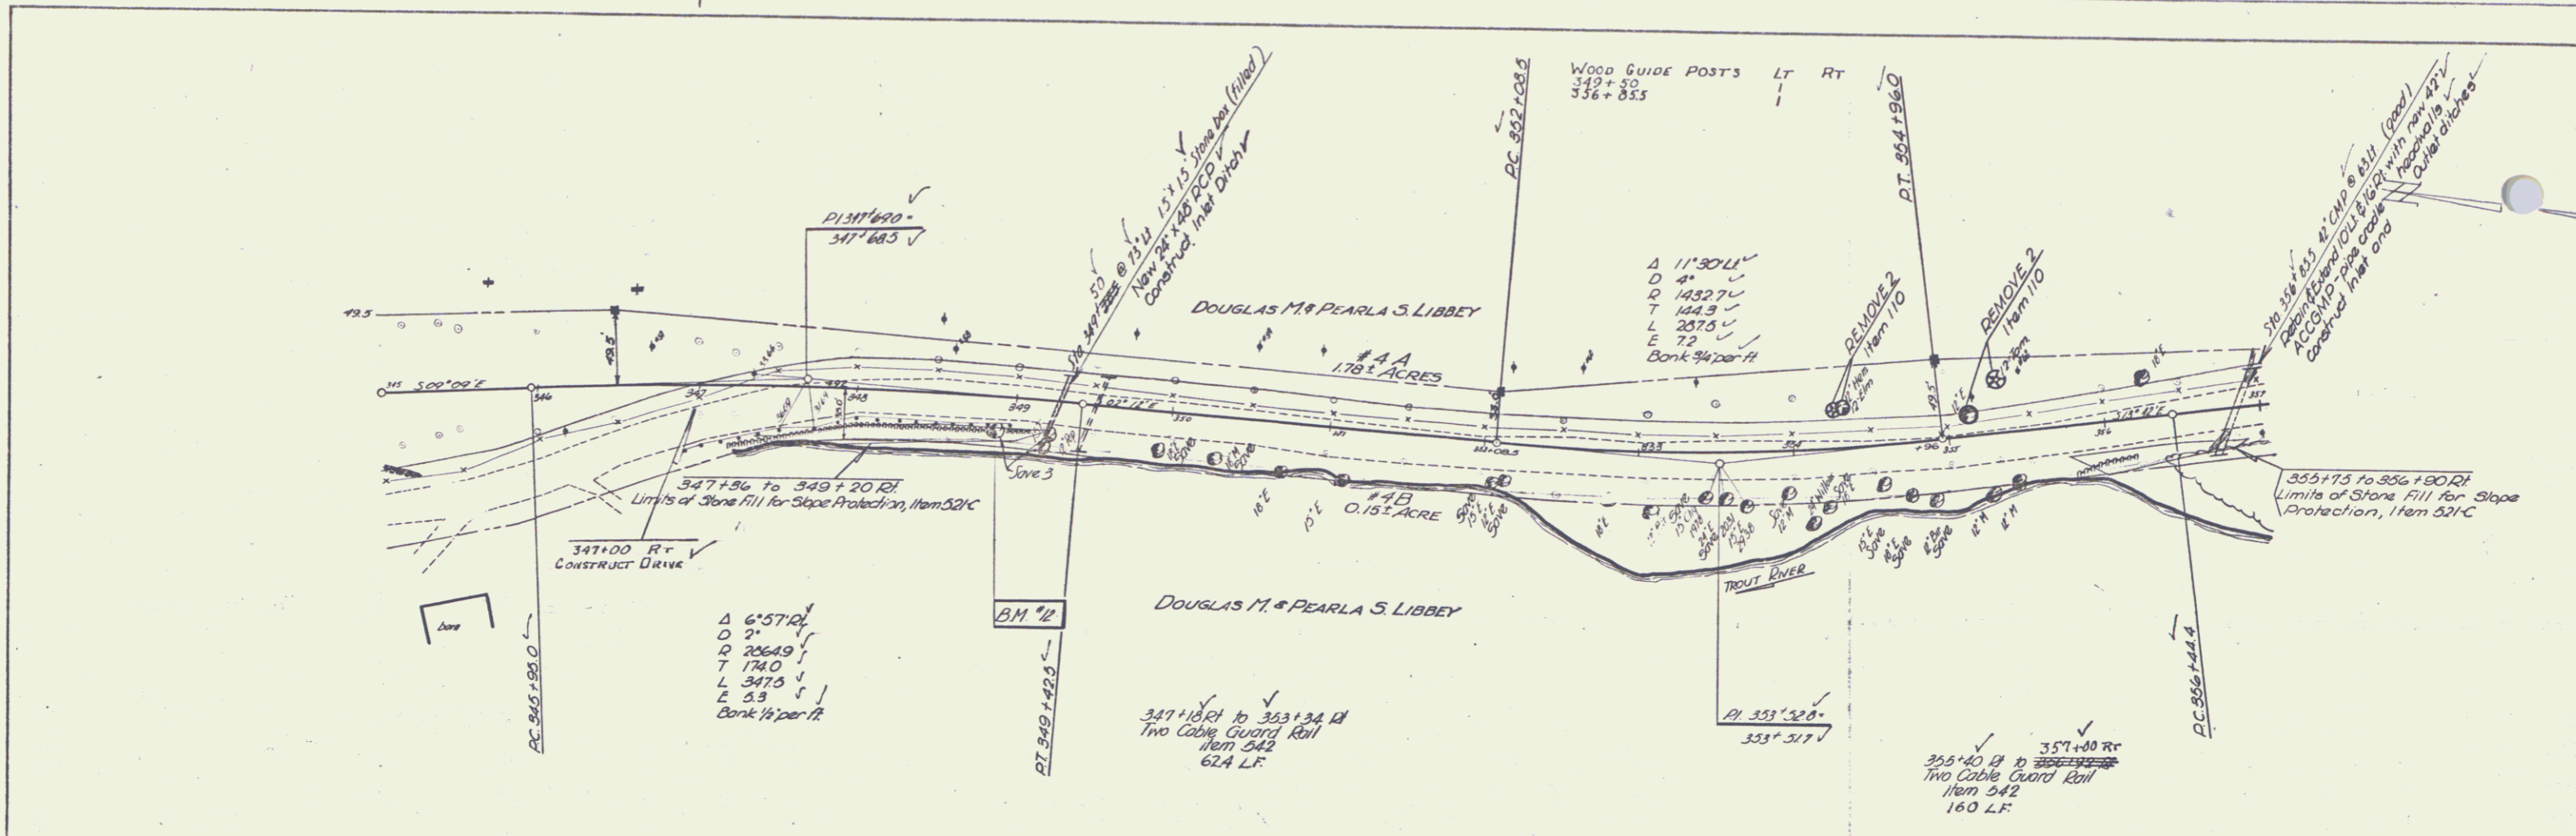


MONTGOMERY  
Project 5, No. 33(A)  
Sheet 14 of 24

PLATE 1 - PLAN & PROFILE  
MONTGOMERY PROJECT 5, NO. 33(A)  
SHEET 14 OF 24

PLAN	DATE	BY
REVISIONS		
1	1/11/11	SP
2	1/11/11	SP
3	1/11/11	SP
4	1/11/11	SP
5	1/11/11	SP
6	1/11/11	SP
7	1/11/11	SP
8	1/11/11	SP
9	1/11/11	SP
10	1/11/11	SP



PROFILE	DATE	BY
REVISIONS		
1	1/11/11	SP
2	1/11/11	SP
3	1/11/11	SP
4	1/11/11	SP
5	1/11/11	SP
6	1/11/11	SP
7	1/11/11	SP
8	1/11/11	SP
9	1/11/11	SP
10	1/11/11	SP

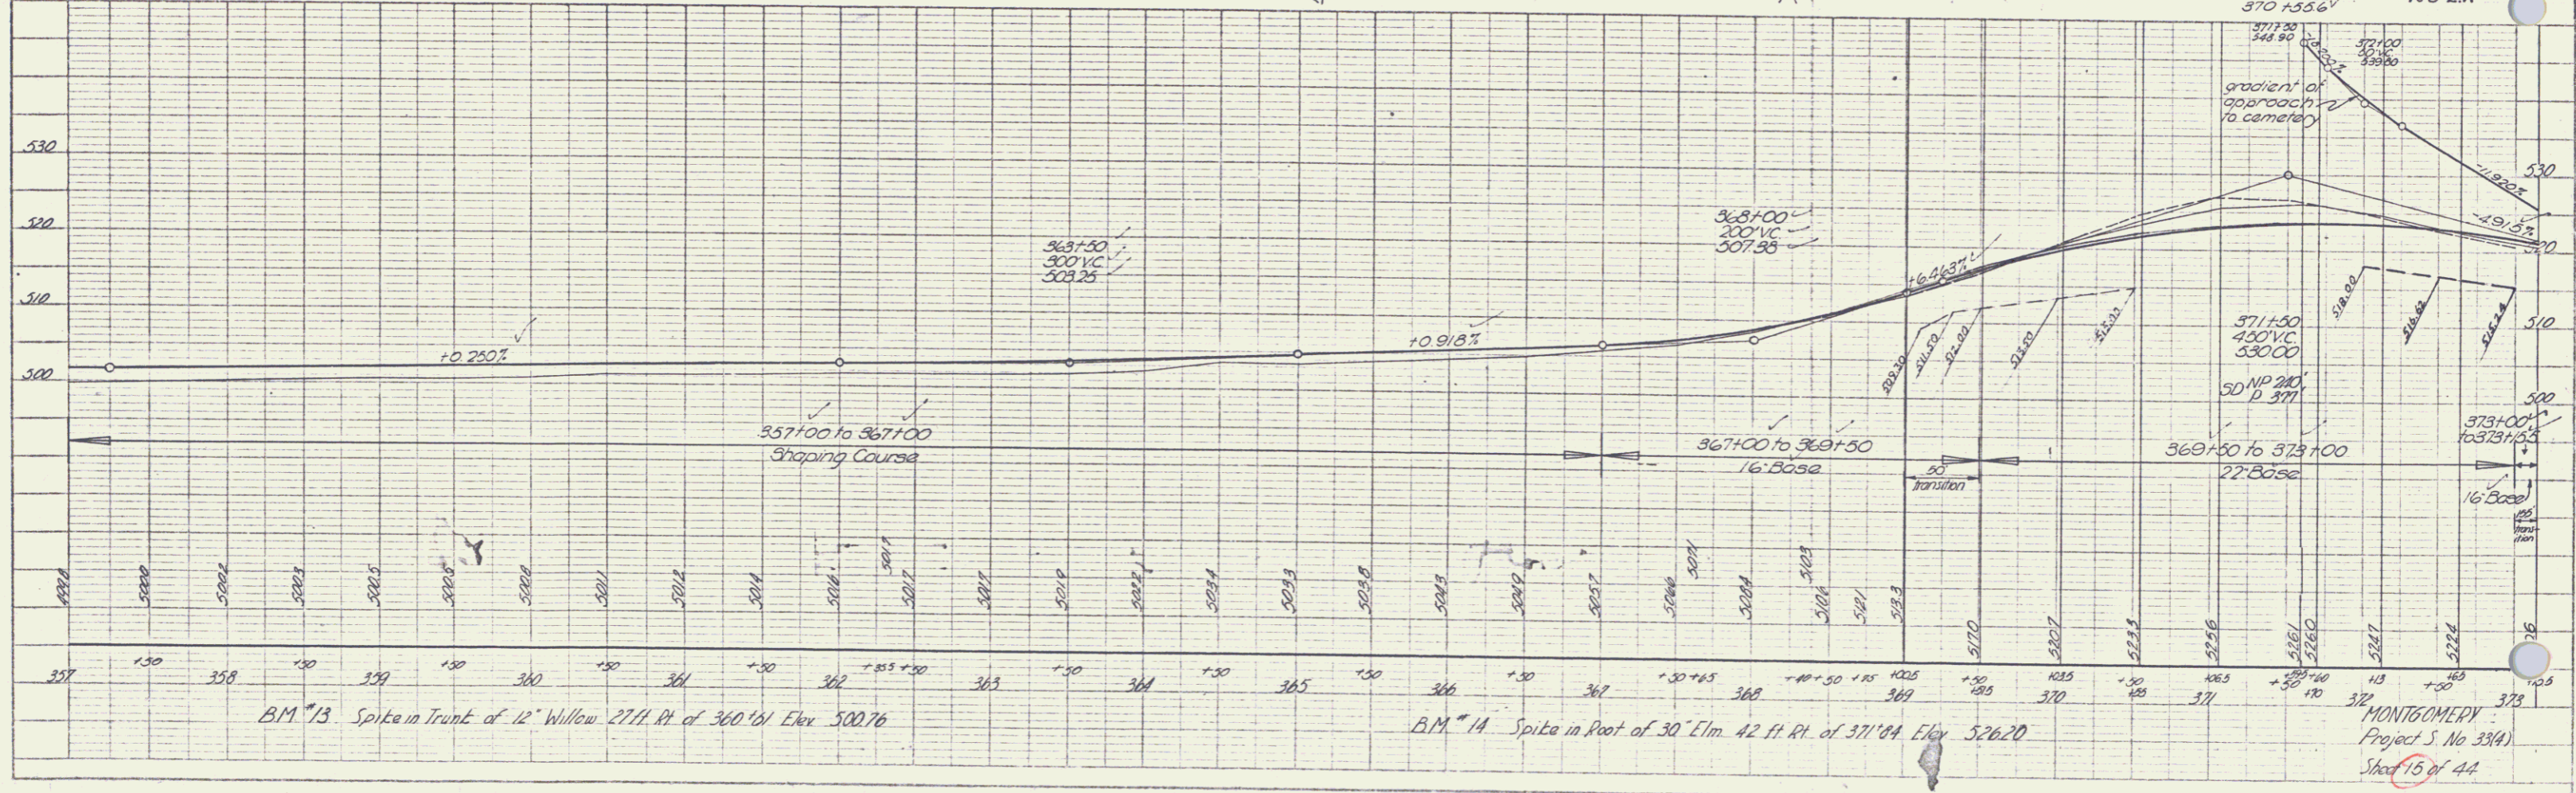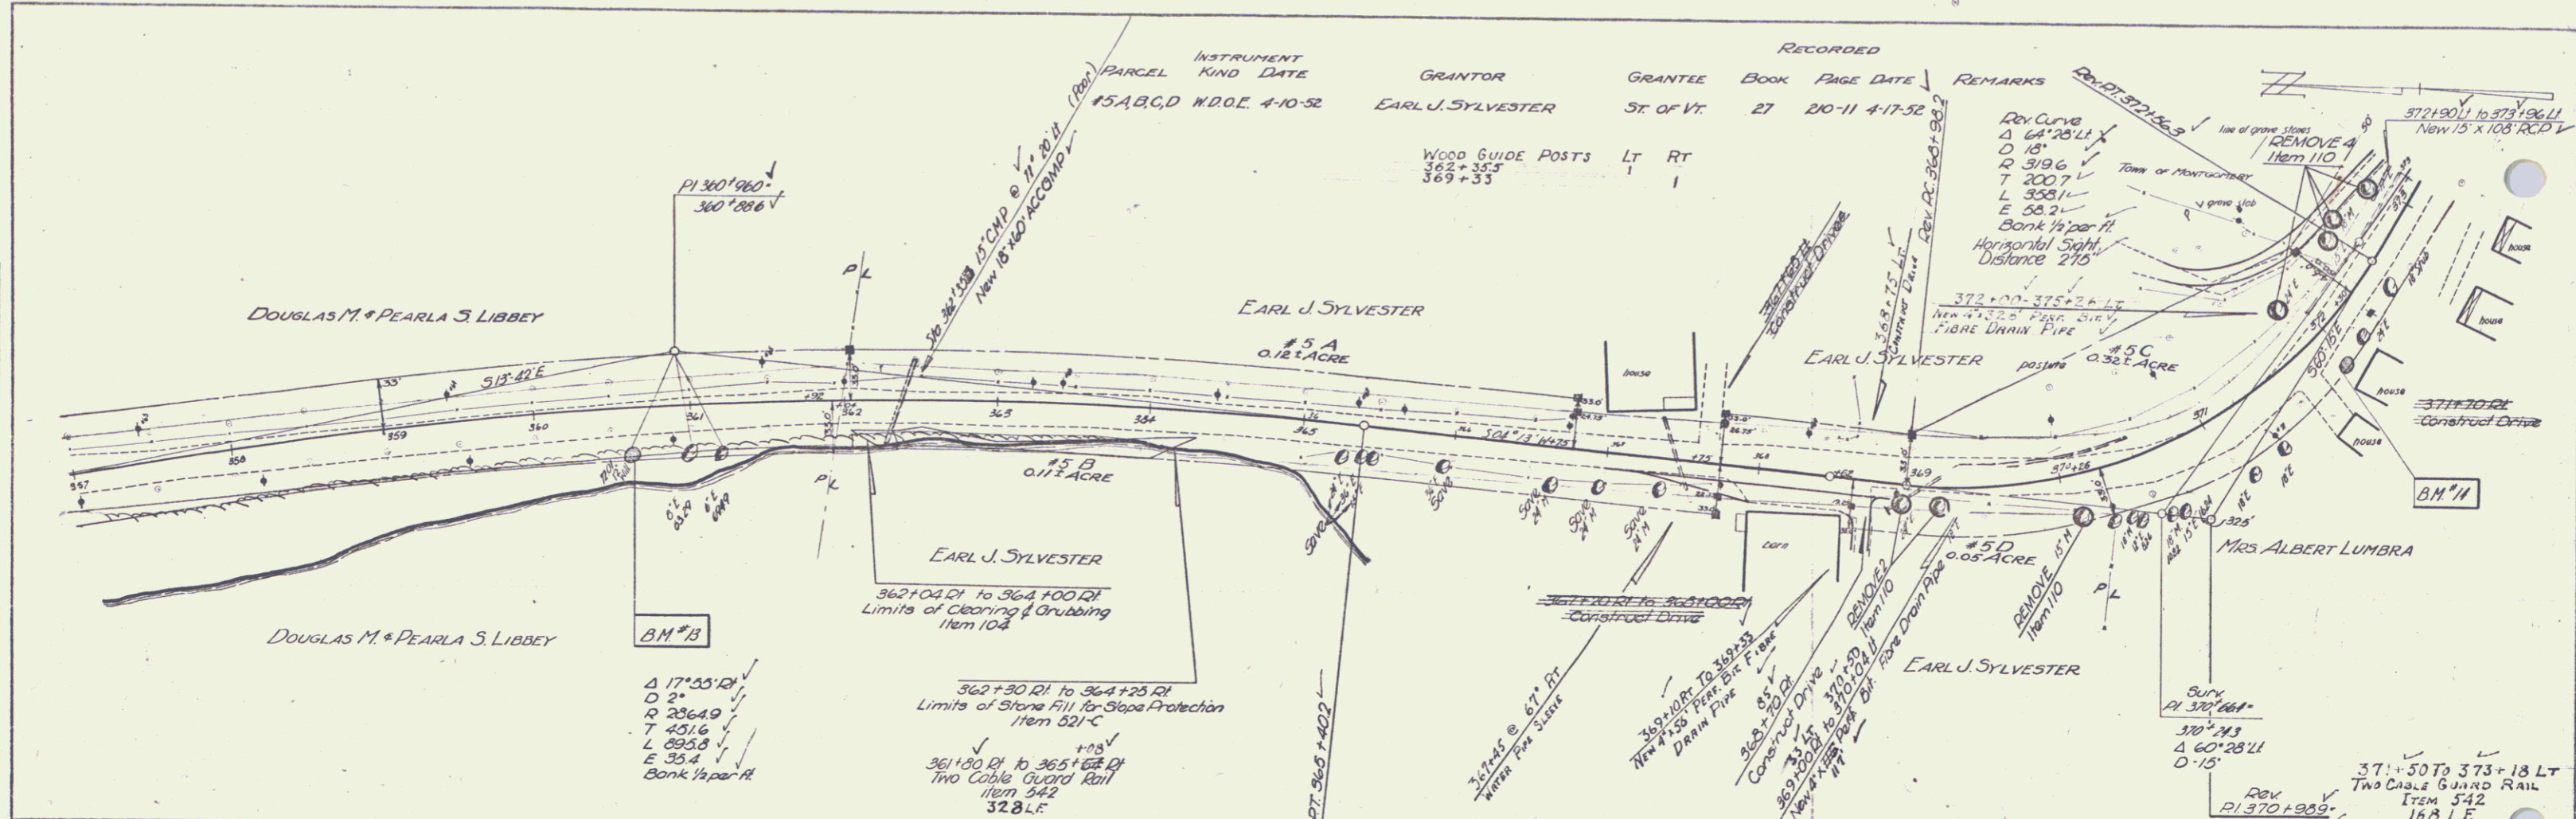

PLAN - PROFILE  
 1/11/11  
 SP

PLAN  
 DATE 1/10/52  
 DRAWN BY [Signature]  
 CHECKED BY [Signature]  
 TITLE [Signature]  
 NO. 11/17

PROFILE  
 DATE 1/10/52  
 DRAWN BY [Signature]  
 CHECKED BY [Signature]  
 TITLE [Signature]  
 NO. 11/17

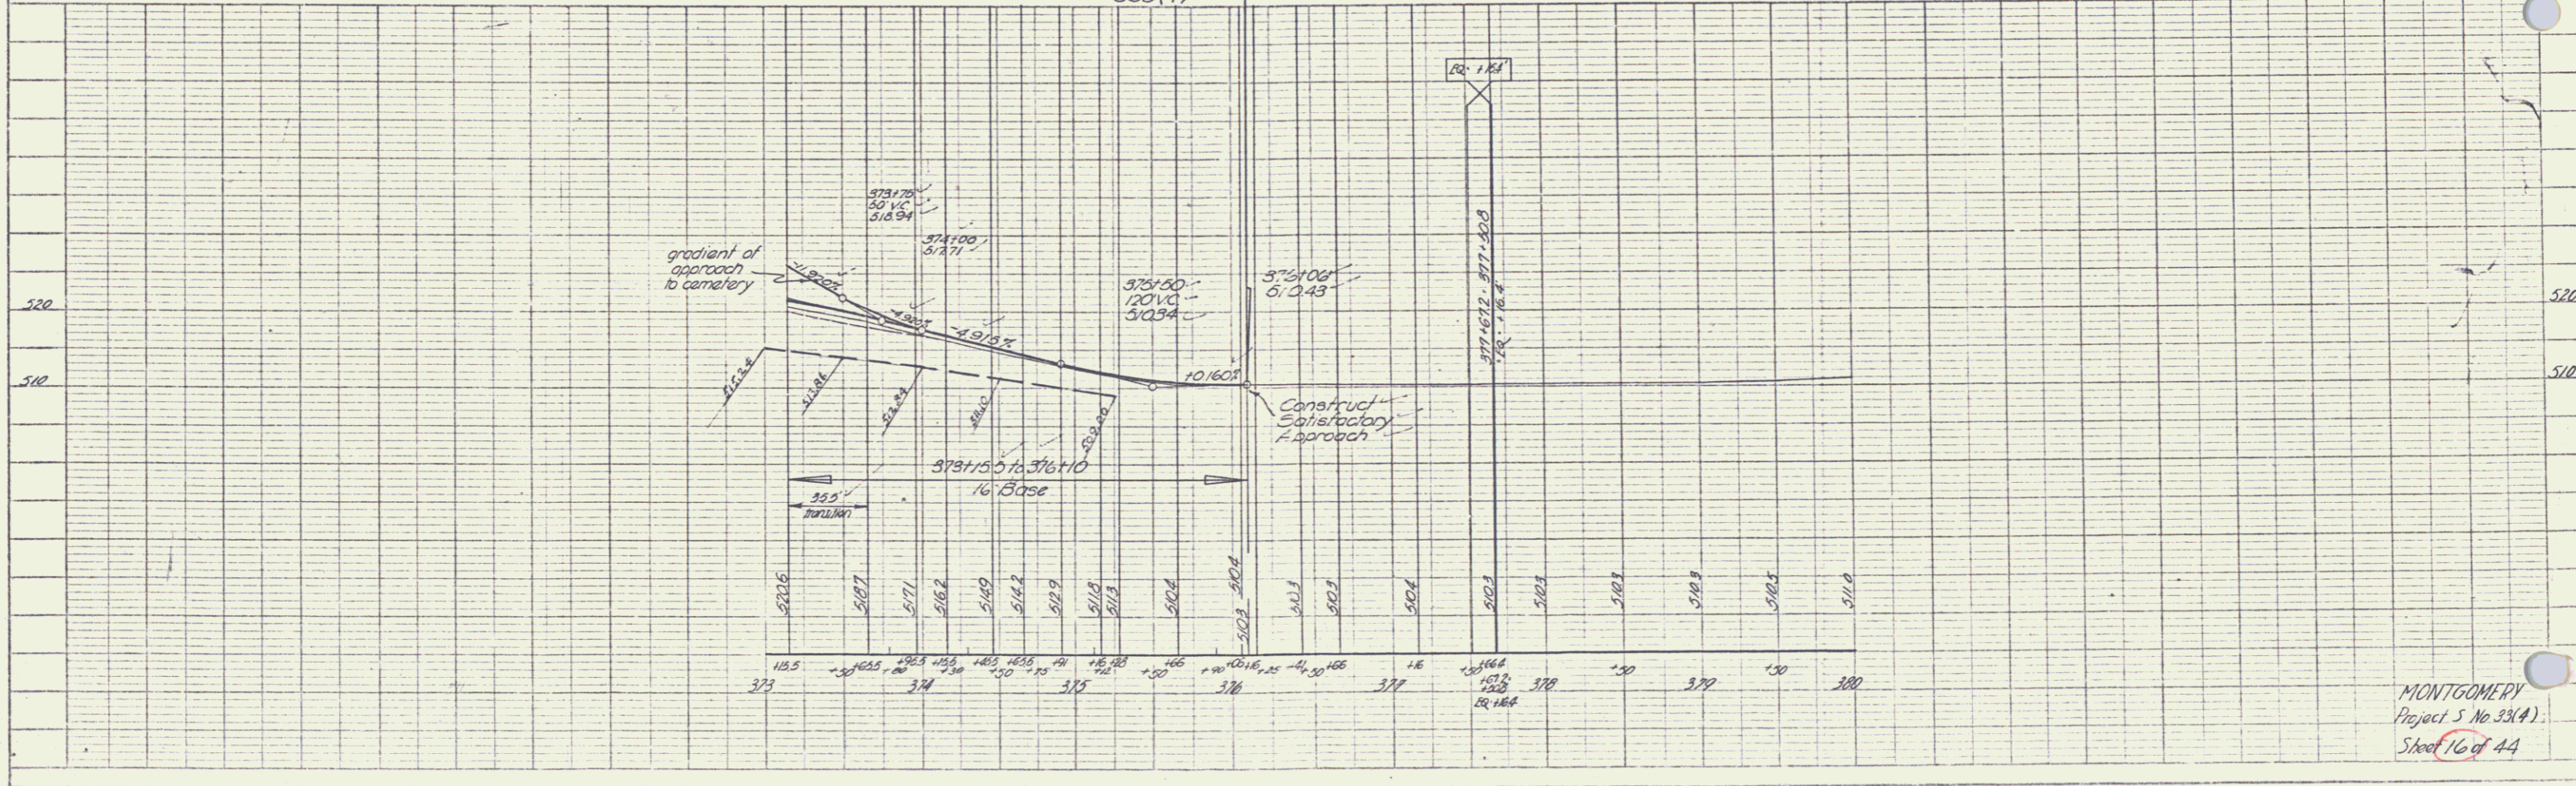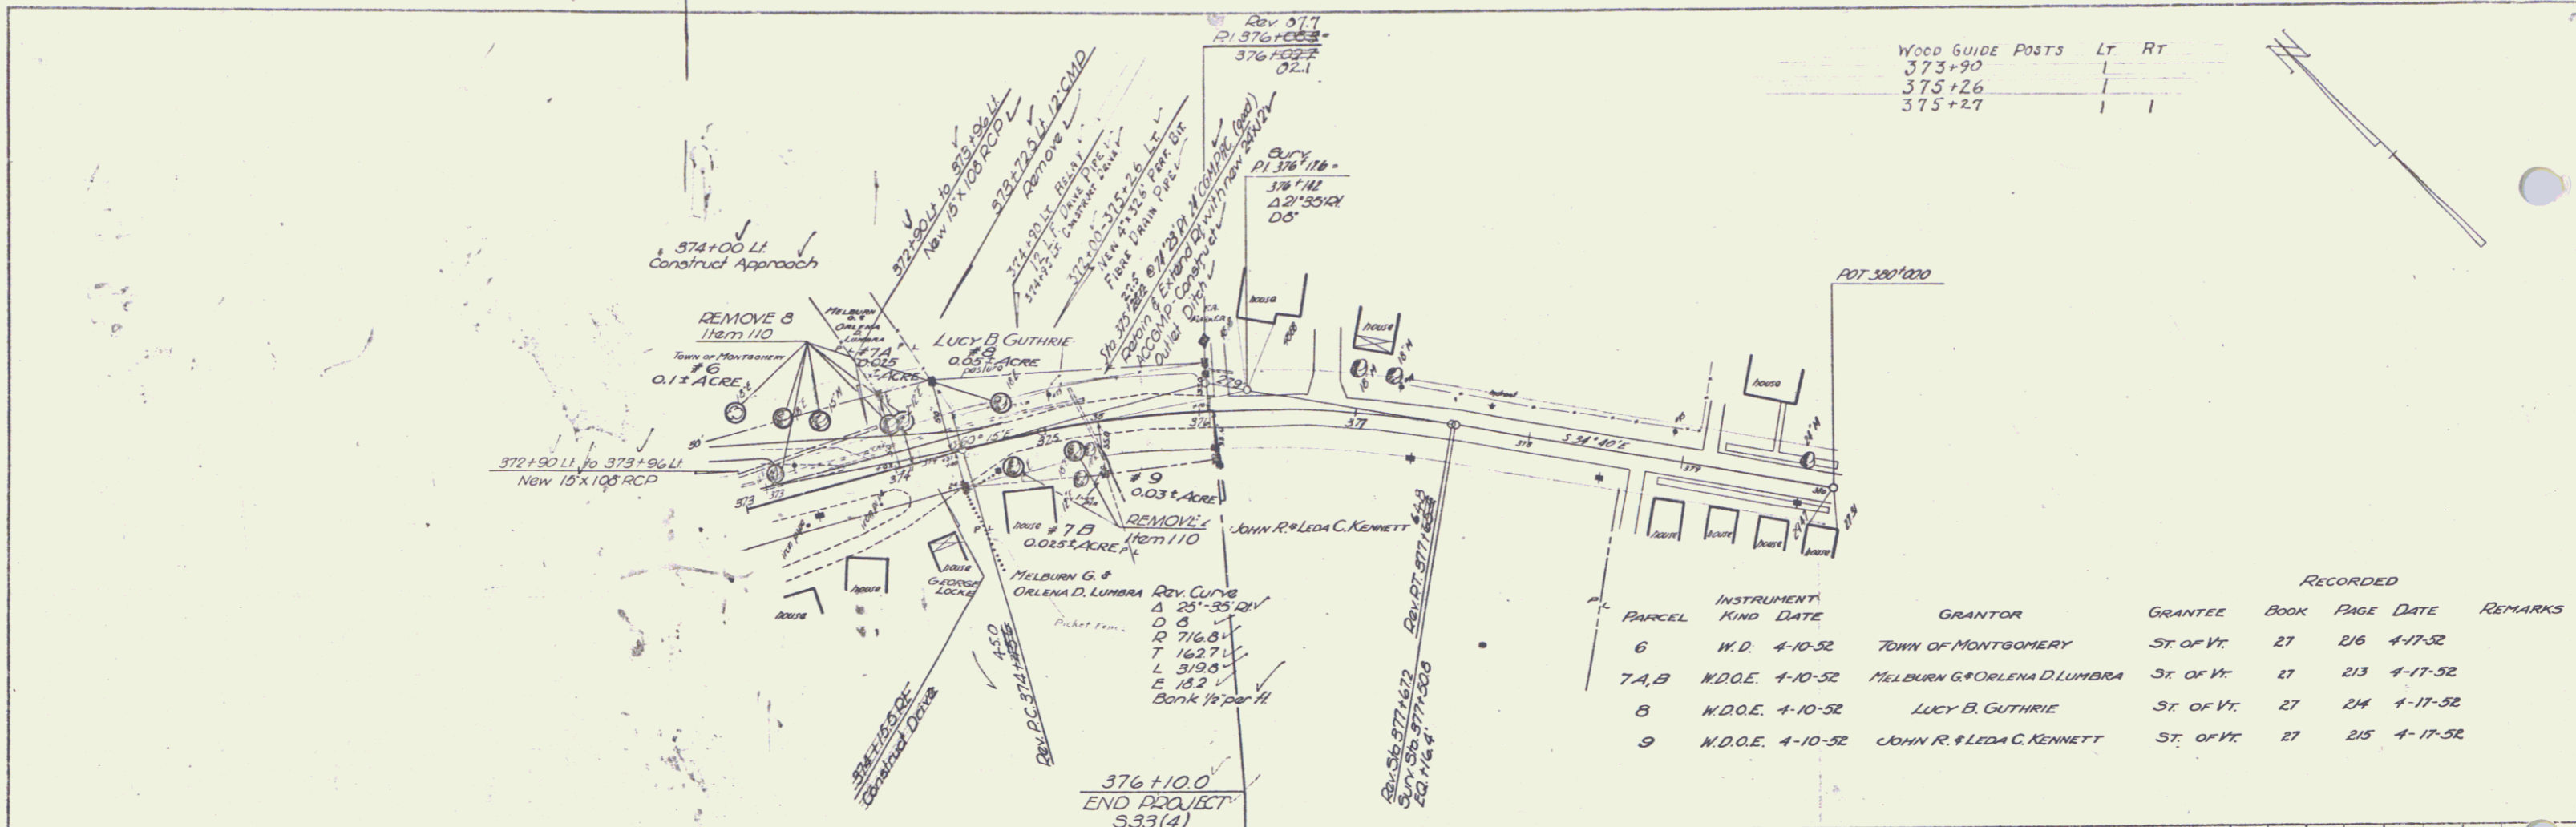

MONTGOMERY  
 Project 5 No. 33(4)  
 Sheet 16 of 44