
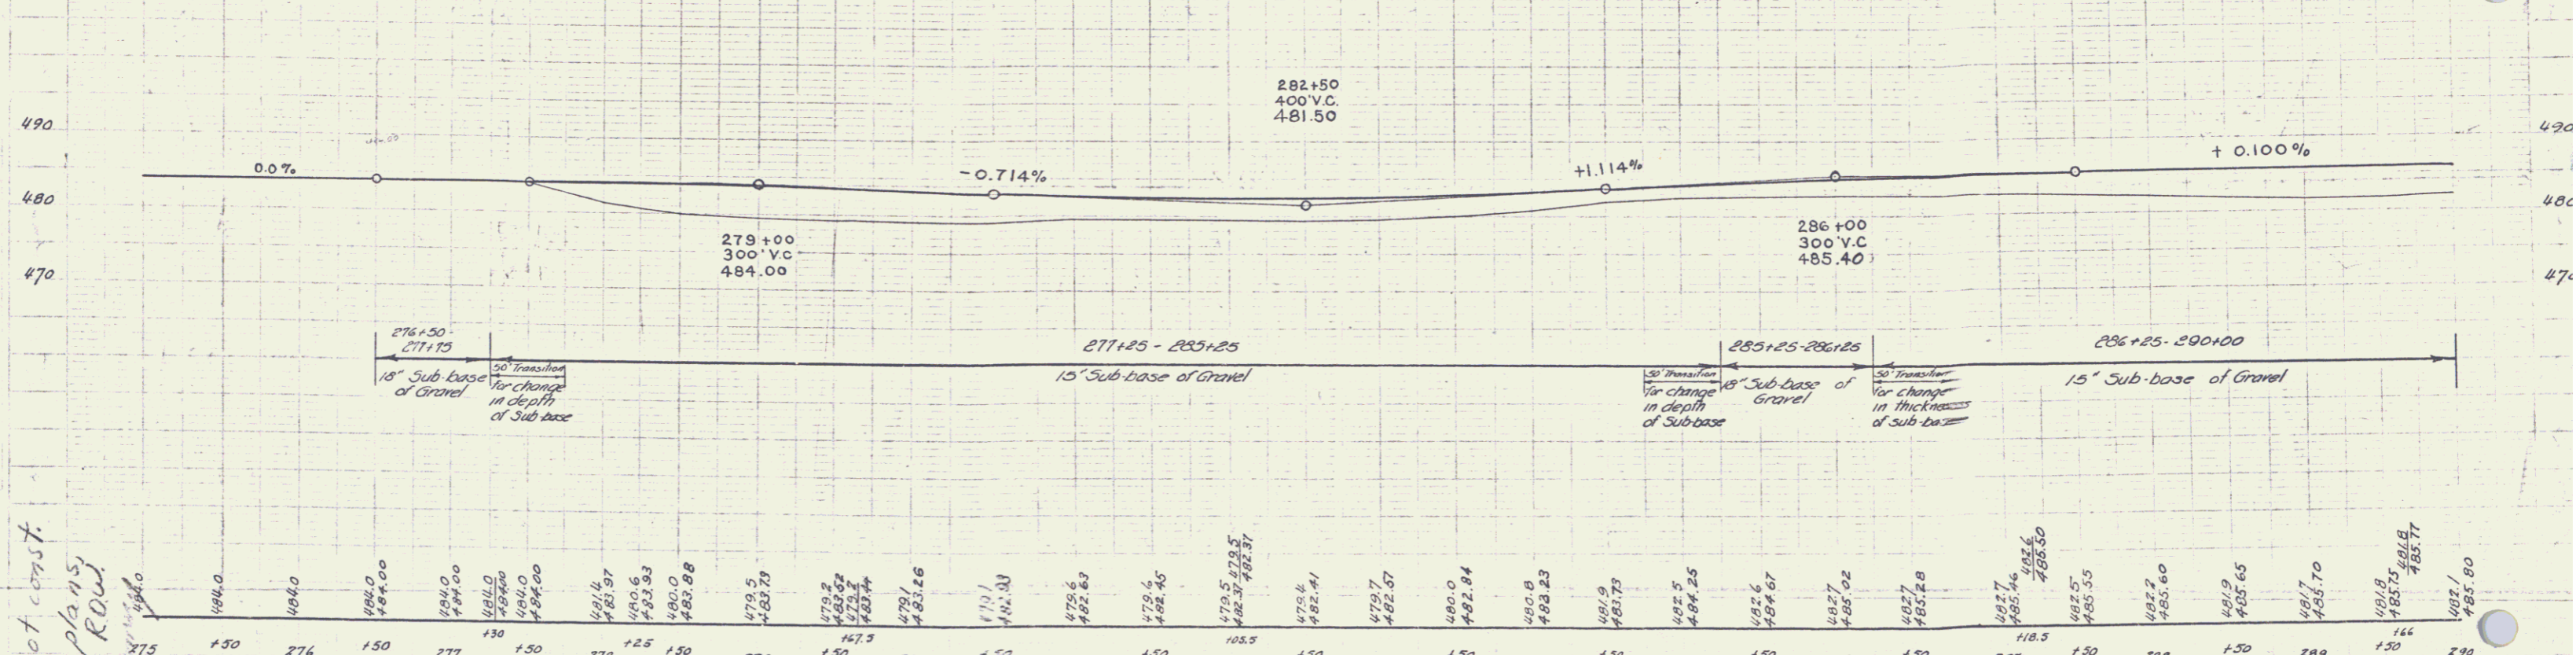


Index
 Sheets 1-5 Layouts & Profiles
 Sheets 6-23 Cross Sections

PARCEL INSTRUMENT	DATE	GRANTOR	GRANTEES	RECORDED	REMARK
A C	W D O E	10-26-40	GEORGE & LINDIE RICHARDSON	ST OF VT	25 38-38 11-9-40
A	Y D O E	12-11-40	HOMER A FRAZIER	ST OF VT	25 67 2-21-42

33 P-1 1940 1 2.3
 Ext

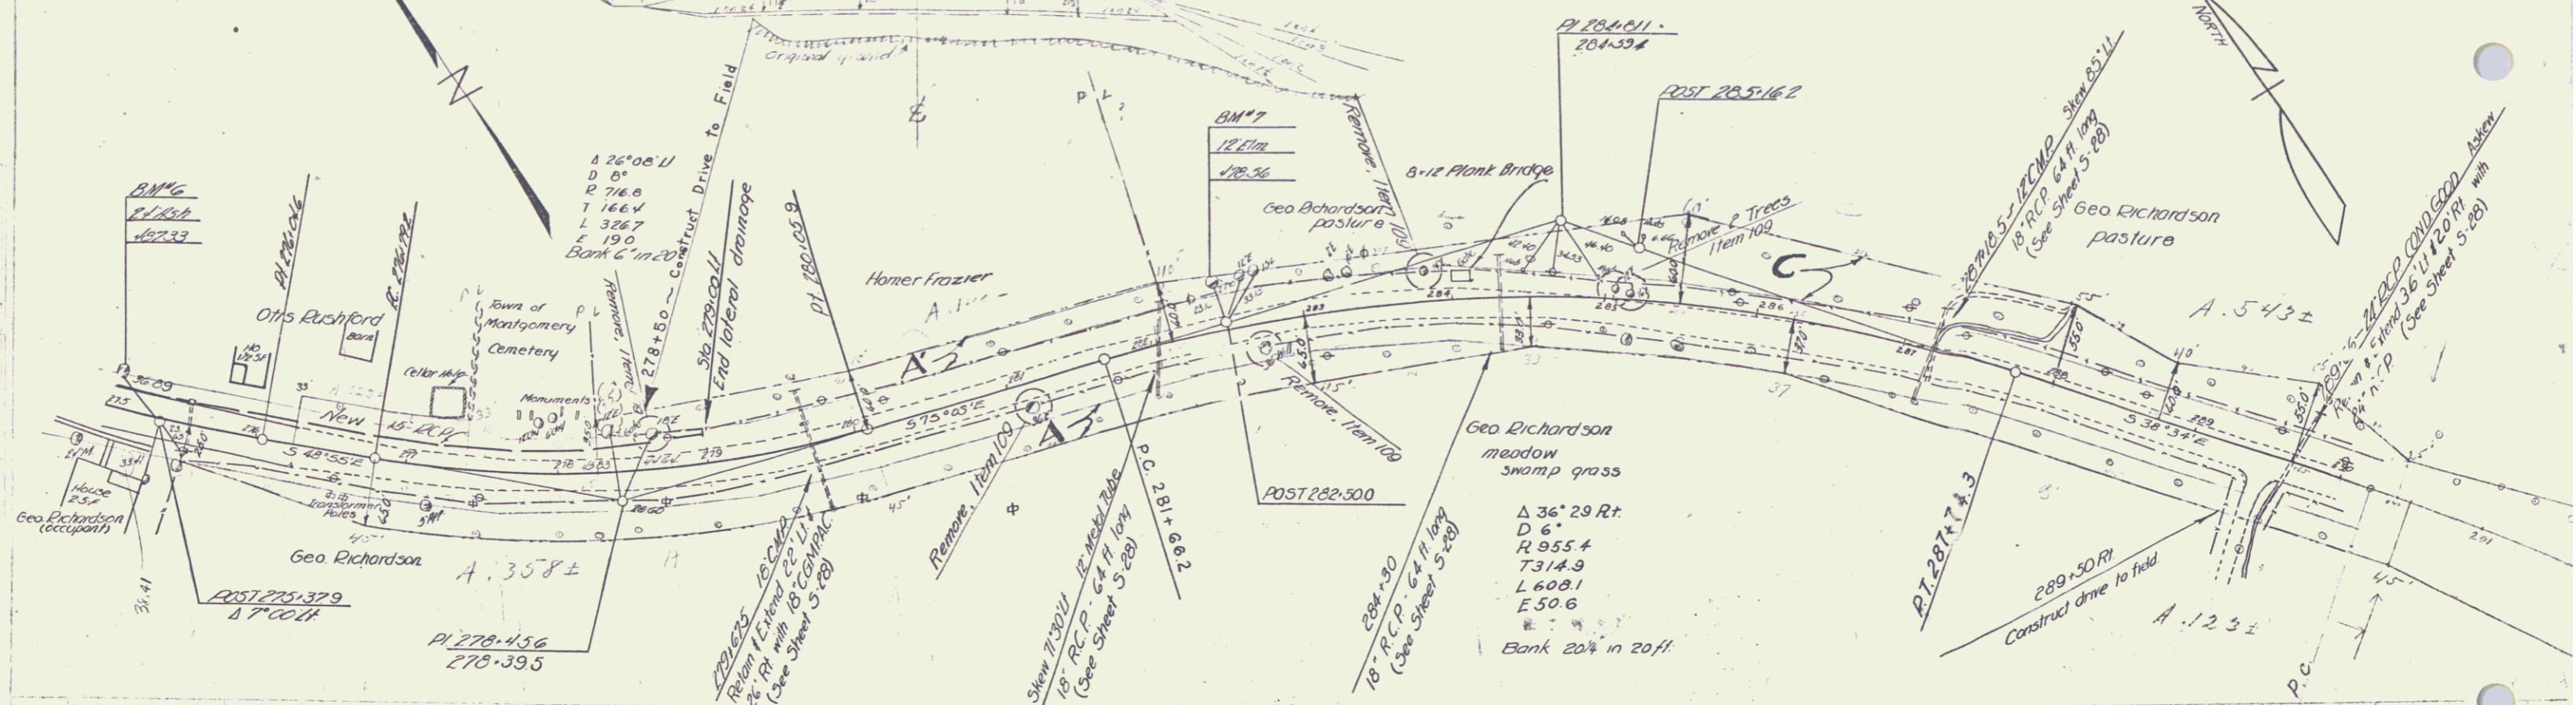

This proj not const.
 from these plans
 but shows ROW
 for Montgomery
 S 33(4)
 (1953)

B.M. #6 24" Ash Lt. 20' @ Sta. 275+06.5 Elev. 487.33
 B.M. #7 Spike in root of 12' Elm Lt. 26.5 ft @ Sta. 282+46 Elev. 478.56

Montgomery 33-P-1 Ext
 Sheet of 23 Sheets
 DIST # 8 PLAN
 7