


PARCEL	INSTRUMENT	DATE	GRANTOR	GRANTEE	RECORDED MONTGOMERY	REMARKS
A	W.D.O.E	11-6-40	ERNEST J MARTIN	ST OF H	BOOK PAGE DATE 25 35-36 11-9-40	

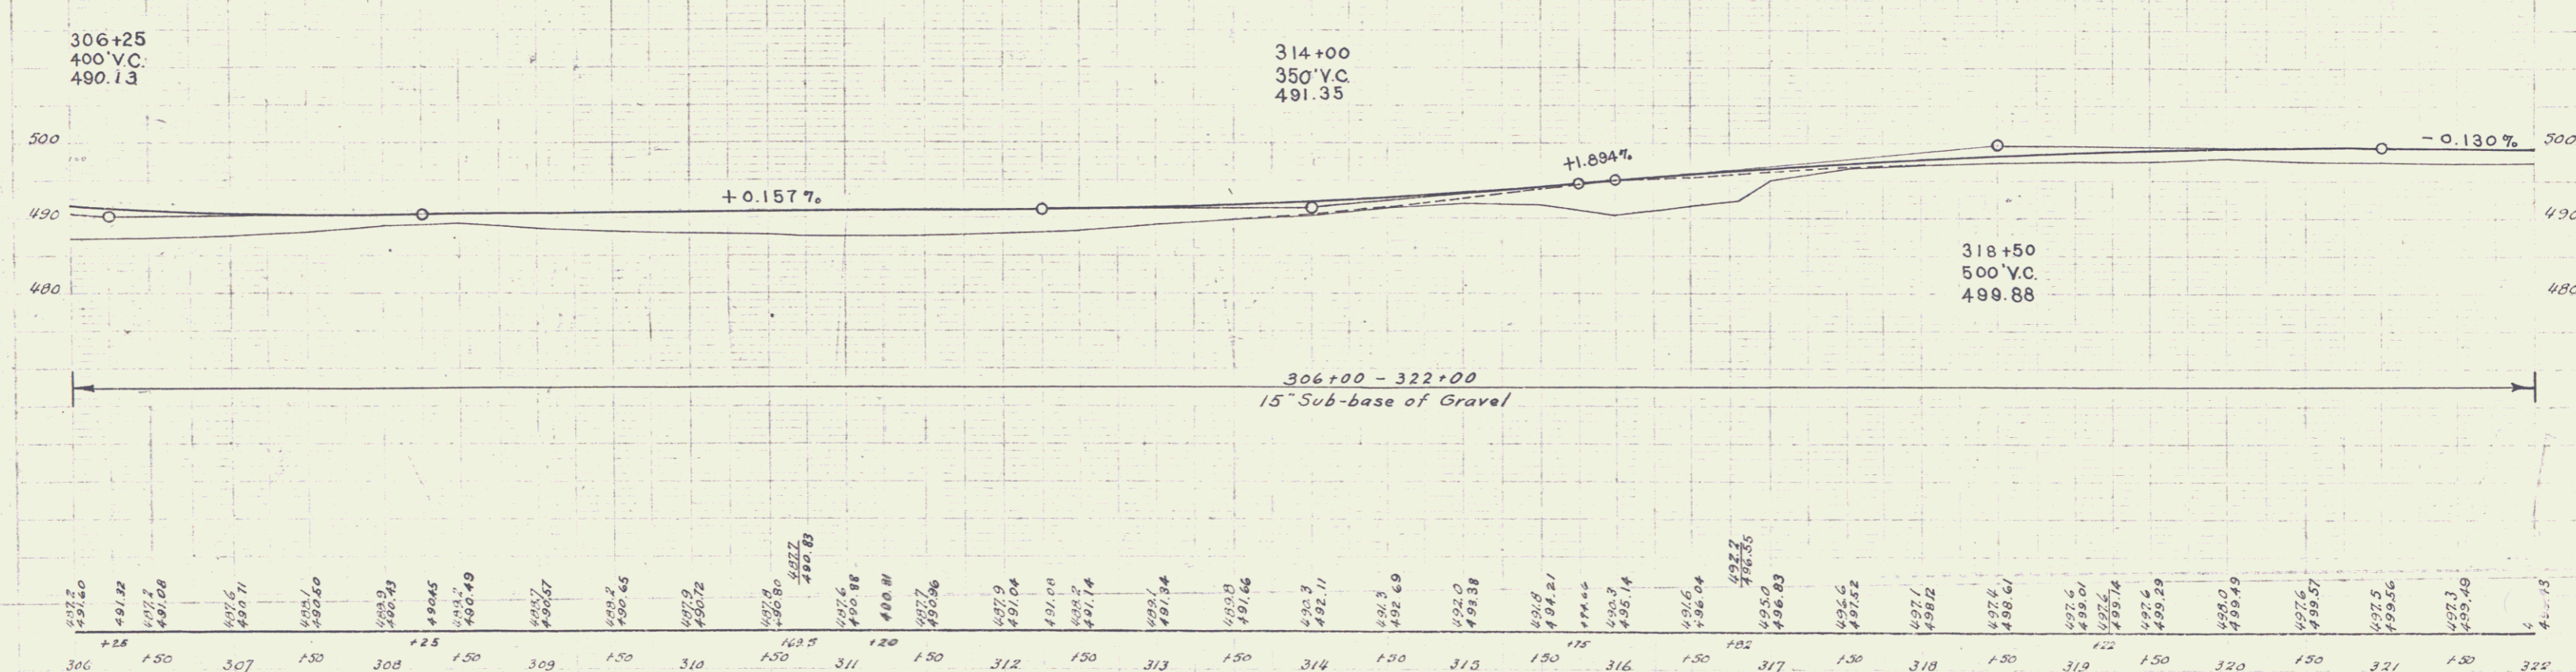

B.M. #9 14' Elm. Lt. 33.5ft. at Sta. 307+47 Elev. 491.00

Montgomery 33-P-1  
Sheet 3 of 23 Sheets.