

WOOD GUIDE POSTS

STA	LT	RT	STA	LT	RT
16+13	18+26	14	16%	21+20	21+40
16+11				21+25	1
16+26				21+71	1
16+44	17+09	2	4	21+45	1
17+01	19+59	2	4	21+80	13
22+51	21+25	11		21+30	2

CONSTRUCT APPROACH

22+50 LT ✓	23+50 LT ✓
23+59 LT ✓	28+95 RT ✓
31+60 LT ✓	31+40 RT ✓

CONSTRUCT DRIVE

28+00 RT ✓	28+95 RT ✓
31+60 RT ✓	31+40 RT ✓
17+00 LT ✓	
25+50 LT ✓	


CLEARING AND GRUBBING (CHANNEL)
 16+34 - 18+35 RT
 4+65 upstream - 5+40 downstream

GRANITE CURB ITEM 556 B

LT	RT
25 20+15.5-20+40.5	20+44.5-20+69.5
25 22+17.5-22+57	22+58.5-22+40.5
25 23+45 -23+67.5	23+23.5-23+48.5
25 30+49.5-31+14	30+75.5-31+00.5

A 11' 45" LI
 D 3' ✓
 R 190.1 ✓
 T 106.5 ✓
 L 391.7 ✓
 E 101 ✓
 Bank 1/2 per ft

BEGIN APPROACH CONSTRUCTION

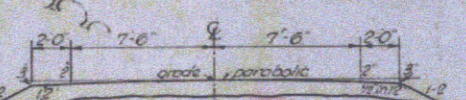

RECORDED INSTRUMENT DATE

NO.	DATE	GRANTOR	GRANTEE	BOOK	PAGE	DATE	REMARKS
#6	12-27-30	W.D.O.E.	ST OF VT	27	172	1-9-31	
#7	12-27-30	W.D.O.E.	ST OF VT	27	175	1-4-31	
#8	12-27-30	W.D.O.E.	ST OF VT	27	163	1-4-31	
#9A+B	12-27-30	W.D.O.E.	ST OF VT	27	167	1-4-31	
#10A,B,C	12-27-30	W.D.O.E.	ST OF VT	27	165	1-4-31	#10B Cont. Street
#11	12-27-30	W.D.O.E.	ST OF VT	27	167	1-9-31	

MONTGOMERY

Surveyed by
 Designed by
 Drawn by
 Traced by JR BLD
 Checked by
 PROD. 1 No. 33(2) File
 Sheet 10 of 63 Sheets