
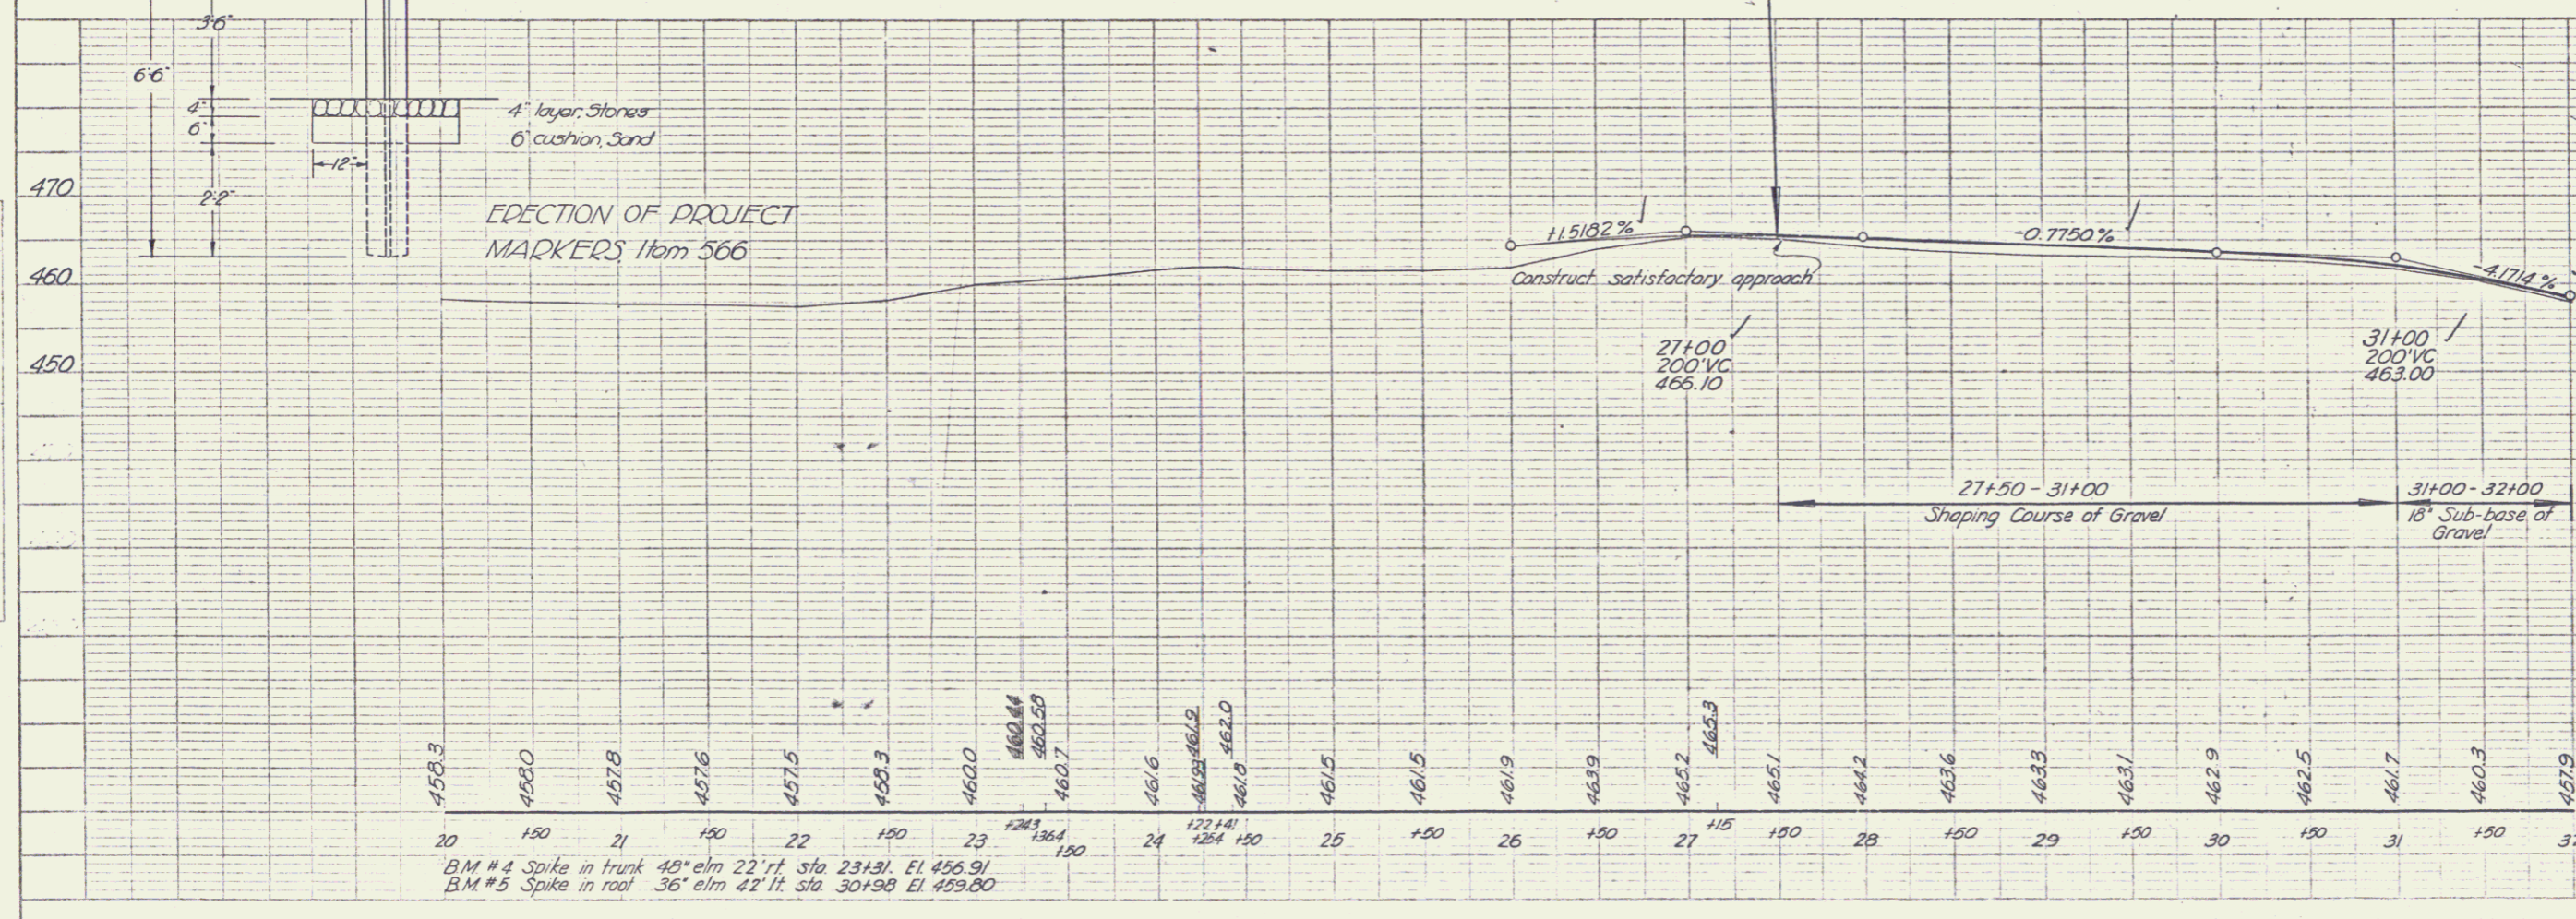


PLAN
 12-47
 7-48
 Dr. Clark

PROFILE
 12-47
 7-48
 Dr. Clark

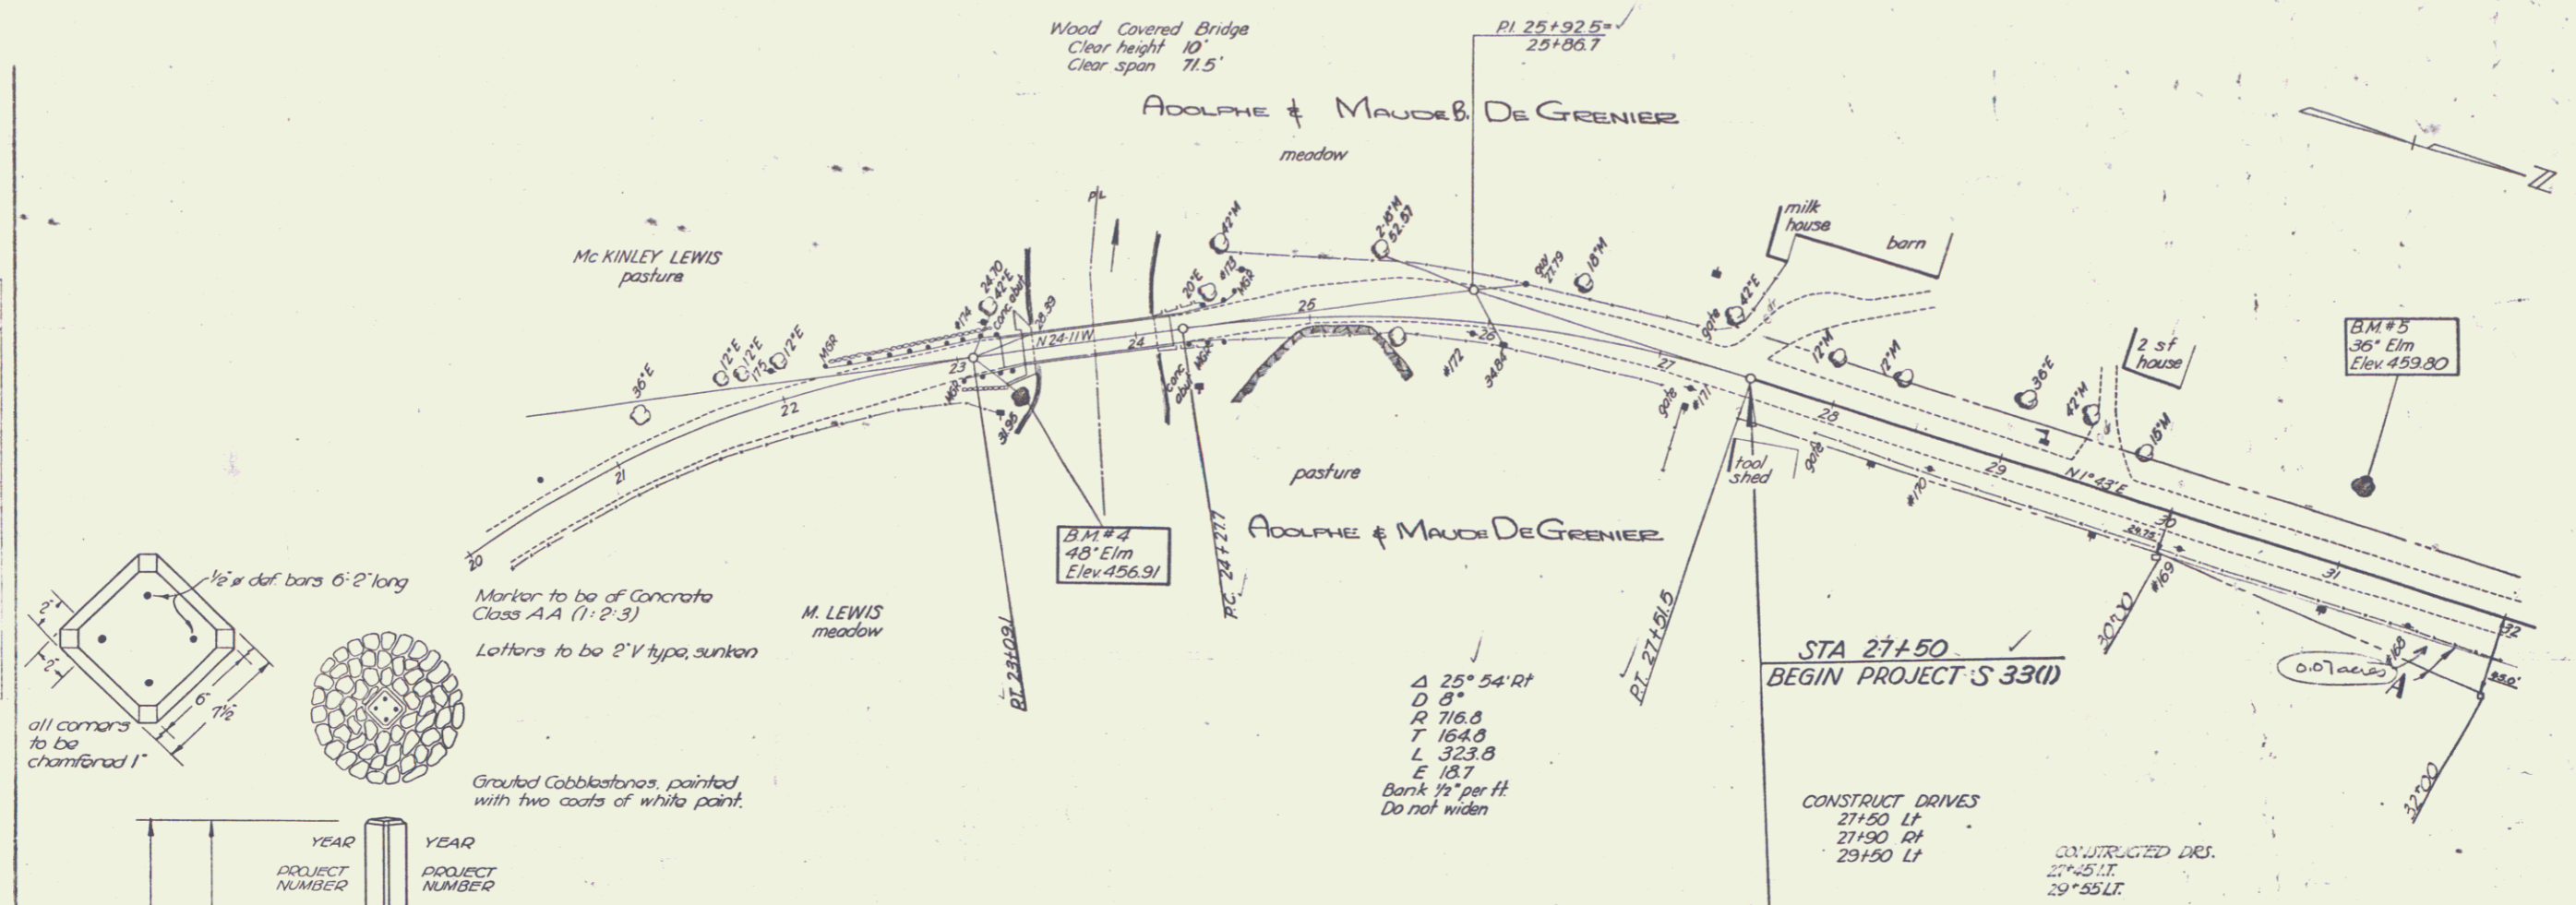

BM #4 Spike in trunk 48' elm 22' ft. sta 23+31, El 456.91
 BM #5 Spike in roof 36' elm 42' ft. sta 30+98 El 459.80