


PARCEL INSTRUMENT DATE GRANTOR GRANTEE RECORDED MONTGOMERY REMARKS
 #1 AB+C W.D.O.E. 3-22-49 ADOLPH & MAUDE DEGRENIER ST. OF VT. 27 91 3-29-49 (SEE 34 12 FOR PART OF 'A')

Δ 19°02' L
 D 4°
 R 1452.7 ✓
 T 240.2
 L 475.8
 E 20.0
 Bank 1/4 per foot
 Do not widen


LOCAL ROAD STATE DIST. NO. 15 FISCAL YEAR 1949 SHEET NO. 13

POST WAR F A SEC

PLAN
 SCALE 1" = 40'
 DATE 3-29-49
 DRAWN BY [Signature]
 CHECKED BY [Signature]

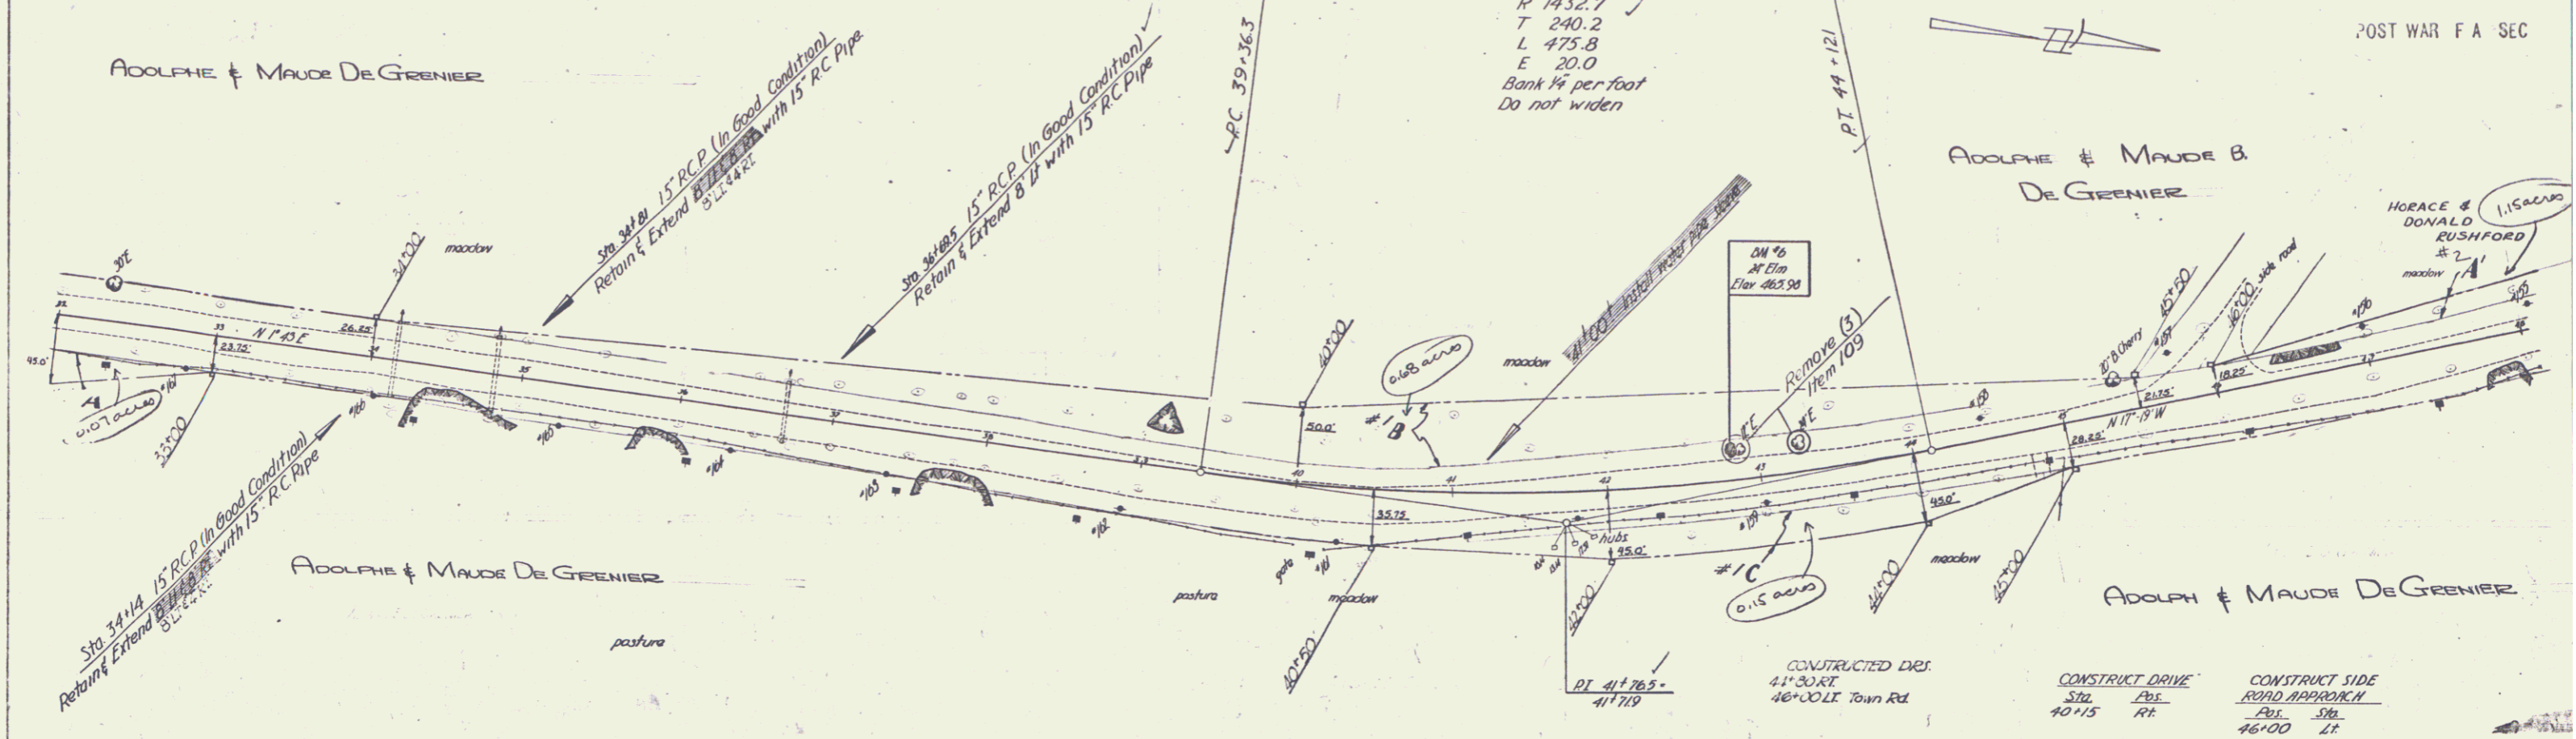

PROFILE
 SCALE 1" = 10'
 DATE 3-29-49
 DRAWN BY [Signature]
 CHECKED BY [Signature]

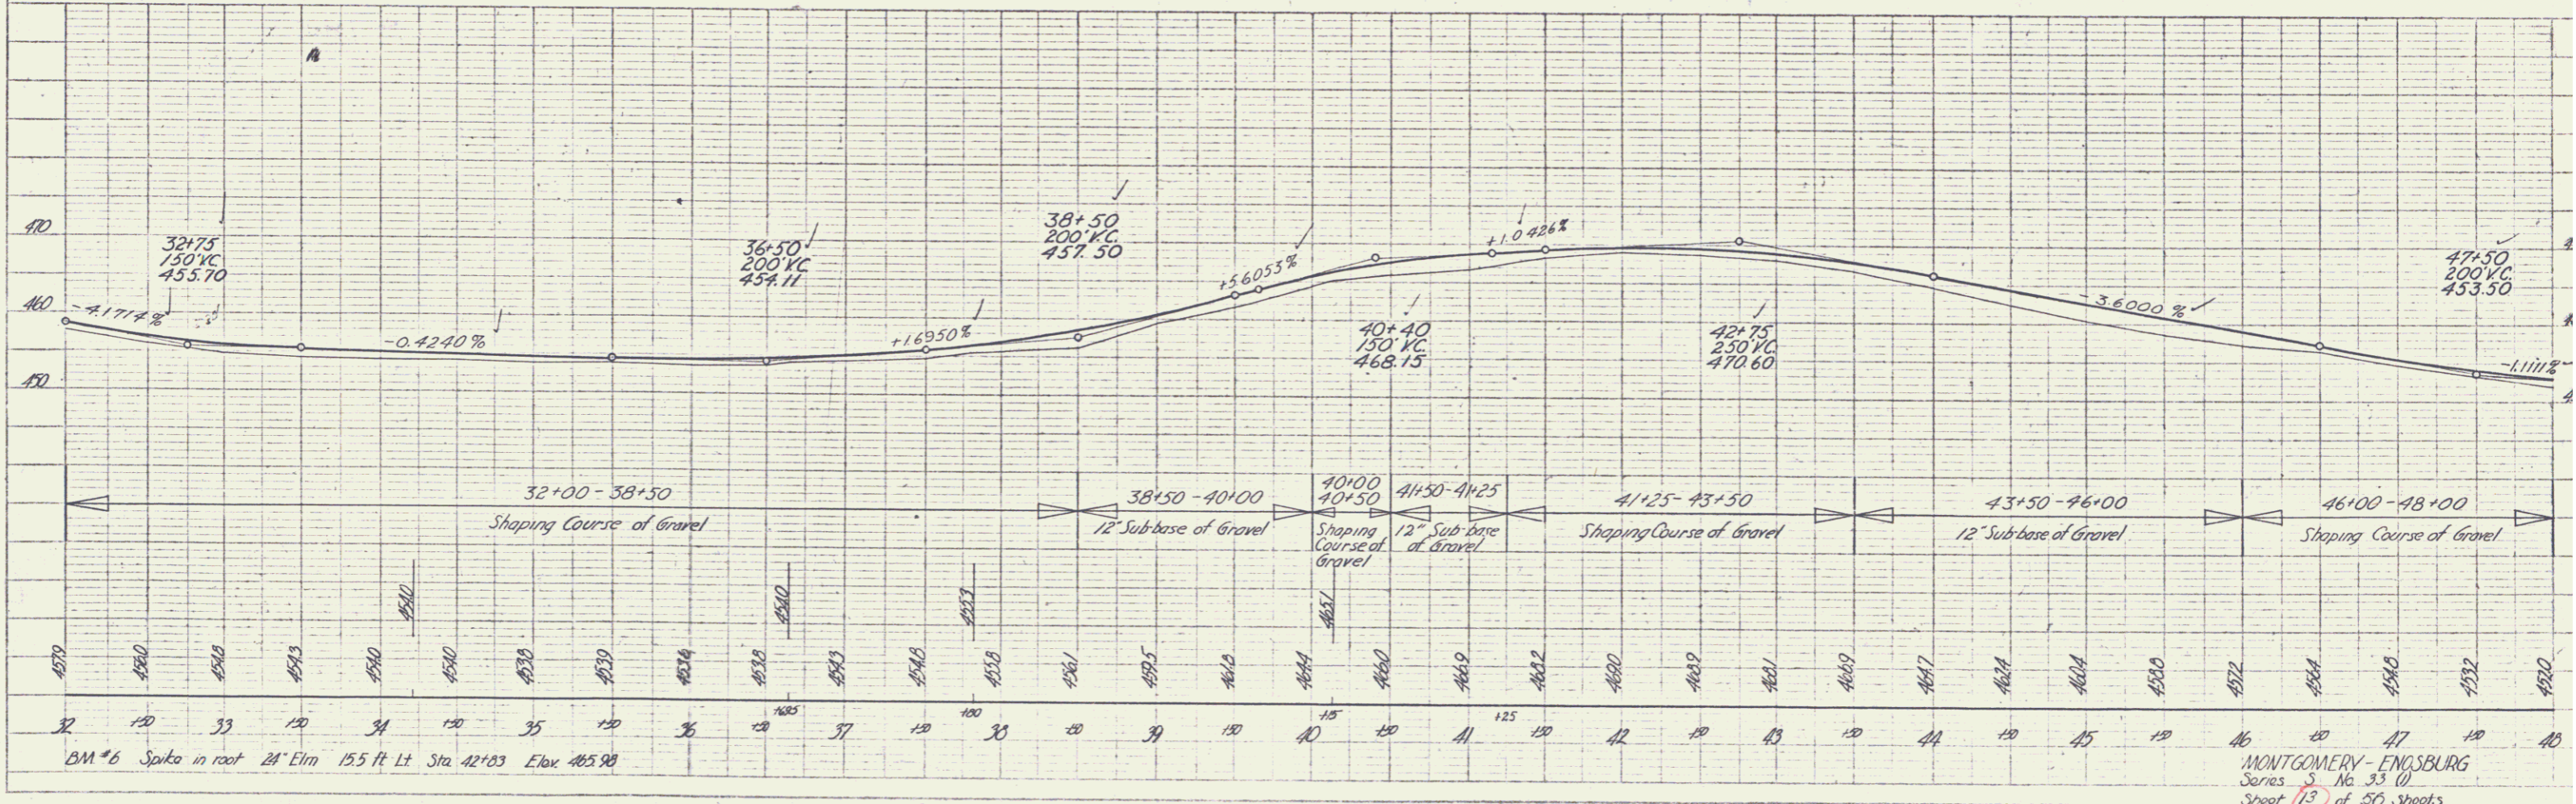

MONTGOMERY - ENGBURG
 Series 5 No. 33 (1)
 Sheet 13 of 50 Sheets