


PARCEL	INSTRUMENT	DATE	GRANTOR	GRANTEE	RECORDED MONTGOMERY	REMARKS	
#					BOOK PAGE DATE		
#5	A,B,C,D	W.D.O.E.	3-22-49	FRED WADLEIGH	ST. OF VT	27 89 3-29-49	SEE SH 15 FOR #5A+B
#6	A,B,C,D,E	W.D.O.E.	4-8-49	C.E. COMBS	" "	27 96 97 4-15-49	" " 17-80 " " 18-19-86E

FEDERAL DIST. NO. STATE PROJ. NO. FISCAL YEAR SHEET NO. 5 VT. 3307 16.0
POST WAR F A SEC

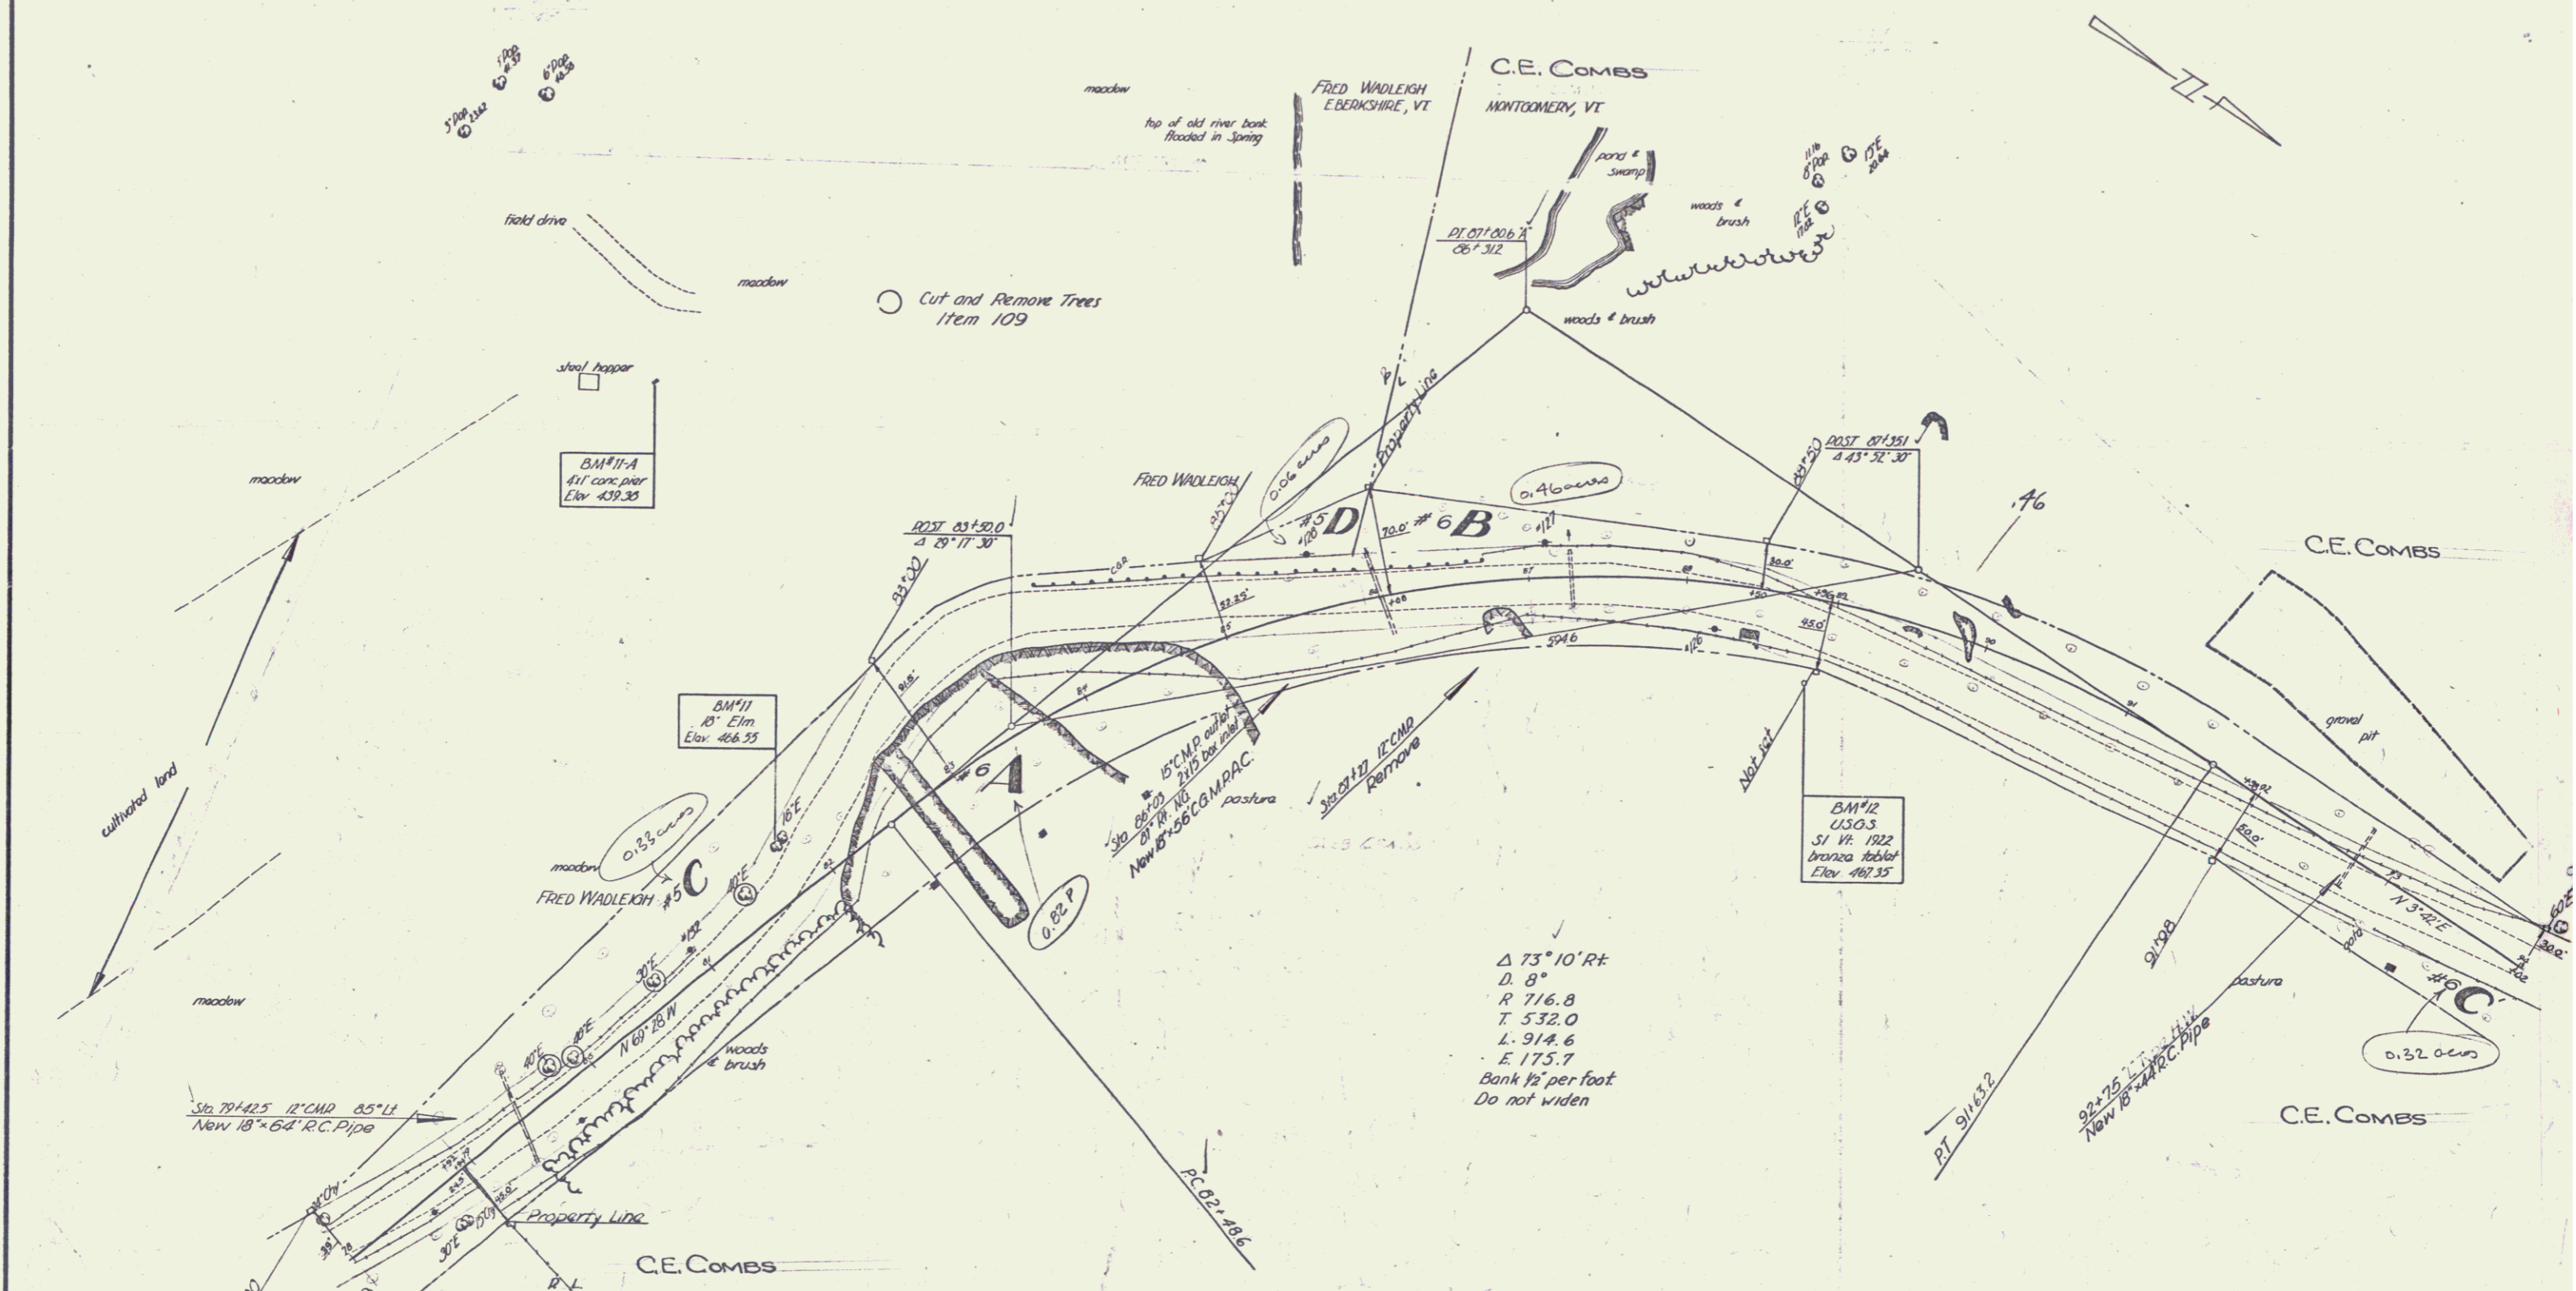

Δ 73° 10' Rt
D. 8°
R 716.8
T. 532.0
L. 914.6
E. 175.7
Bank 1/2' per foot
Do not widen

ESTIMATED QUANTITIES

MONTGOMERY - ENGELBORG
 Surveyed by Foster 12-47
 Designed by 1-48
 Drawn by Payer 2-48
 Traced by Houghton
 Checked by
 Series 5 No. 33 (1) Filed
 Sheet 16 of 56 Sheets