


POST WAR F A SEC

PLAN
 DATE 7-48
 DRAWN BY Houghton
 CHECKED

PROFILE
 DATE 7-48
 DRAWN BY Houghton
 CHECKED

BRIDGE WIDENED 20'-8" TO 30'-0"

| BRIDGE DATA | PRESENT | PROPOSED |
|-------------------------------------|----------------|----------------|
| TYPE | 16' CONC. SLAB | 16' CONC. SLAB |
| OVERALL SPAN ALONG R. ROAD | 22'-0" | 22'-0" |
| ROADWAY WIDTH FACE TO FACE CURB | 20'-8" | 30'-0" |
| CLEAR SPAN ALONG R. ROAD | 18'-0" | 18'-0" |
| " " NORMAL TO STREAM | 18'-0" | 18'-0" |
| CLEAR HEIGHT TO LOW BRIDGE SEAT | 5'-0" | 5'-0" |
| MAX. HIGH WATER ELEV. | 425.0 | 425.0 |
| NORMAL " " ELEV. | 423.00 | 423.00 |
| " " TO LOW BR SEAT | 76" | 76" |
| WATERWAY TO MAX. H. W. ELEV. | 75 | 75 |
| NORMAL TO STR. TO NORM. H. W. ELEV. | 40 | 40 |
| STREAM VELOCITY | SLOW | SLOW |
| DEFT | NONE | NONE |
| SCOUR | NONE | NONE |


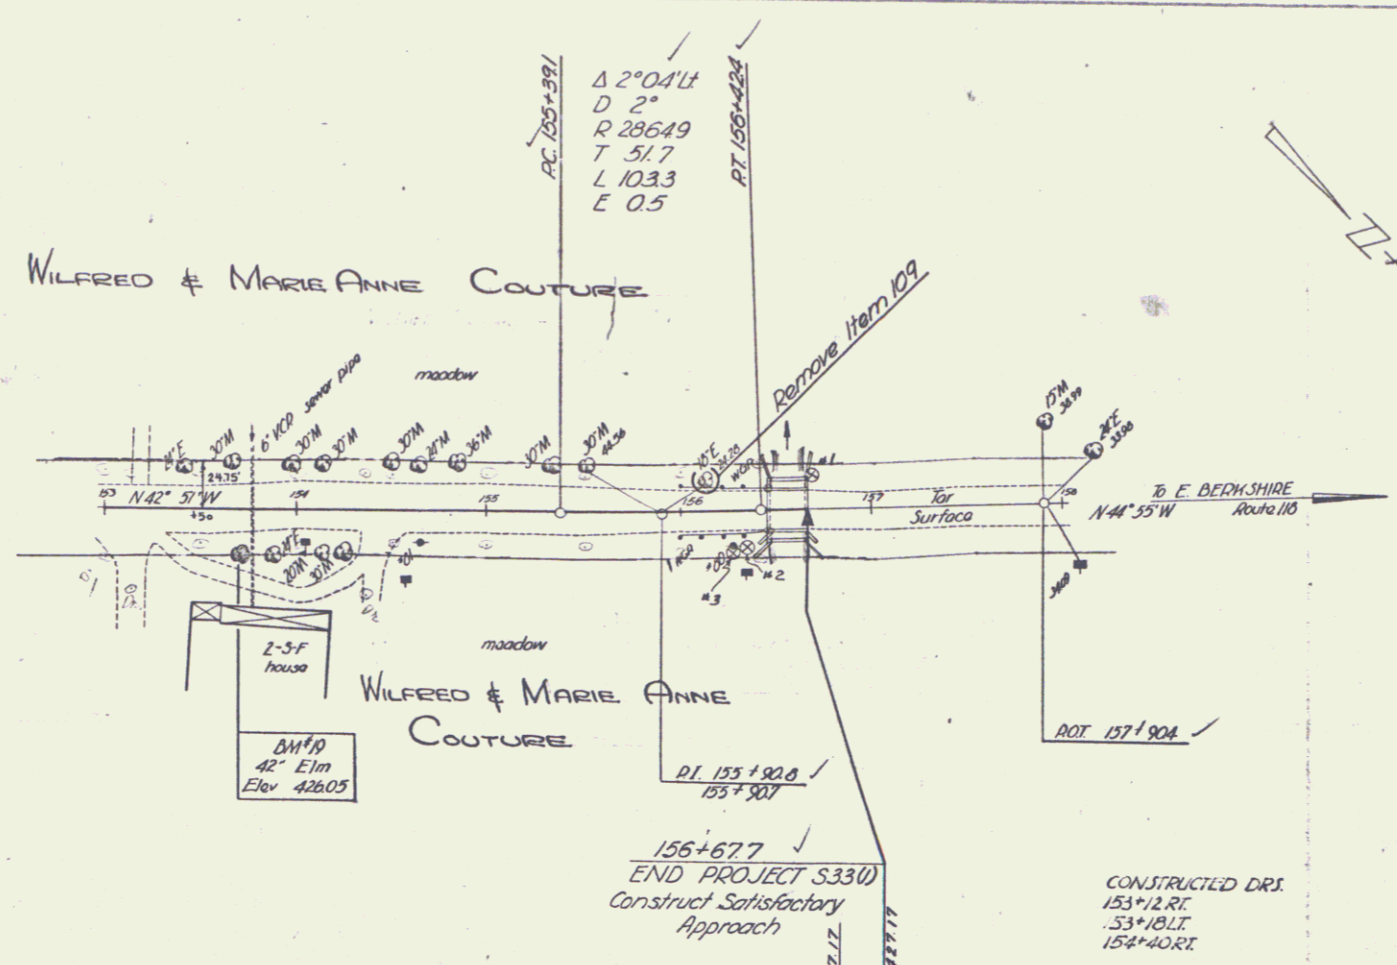


LIST OF SHEETS

- SLAB & ABUTMENT & WINGS DETAILS
- SB-5C1 CURB & RAIL & DRAINS
- SB-2 STD SLAB BR. DETAIL
- SB-11 BARRICADES, LIGHTS & SIGNS

LIST OF QUANTITIES

| | | | |
|------|--------------------------------|------|---------|
| 15 | CHANNEL EXCAVATION | 20 | CY 237 |
| 16 | STRUCTURE EXCAVATION | 235 | CY 1314 |
| 17 | MAINTENANCE OF TRAFFIC | 1 | L.S. |
| 41-A | CONCRETE CLASS-A | 18 | CY 14 |
| 41-C | CONCRETE CLASS-C | 28 | CY 90.7 |
| 42 | REINFORCING STEEL | 2810 | LB 4230 |
| 574 | PREP SUPERSTRUCT. FOR WIDENING | 1 | L.S. |
| 69 | STONE FILL | 236 | CY 32 |
| 80-A | CABLE GUARD RAIL | 28 | LF 64 |

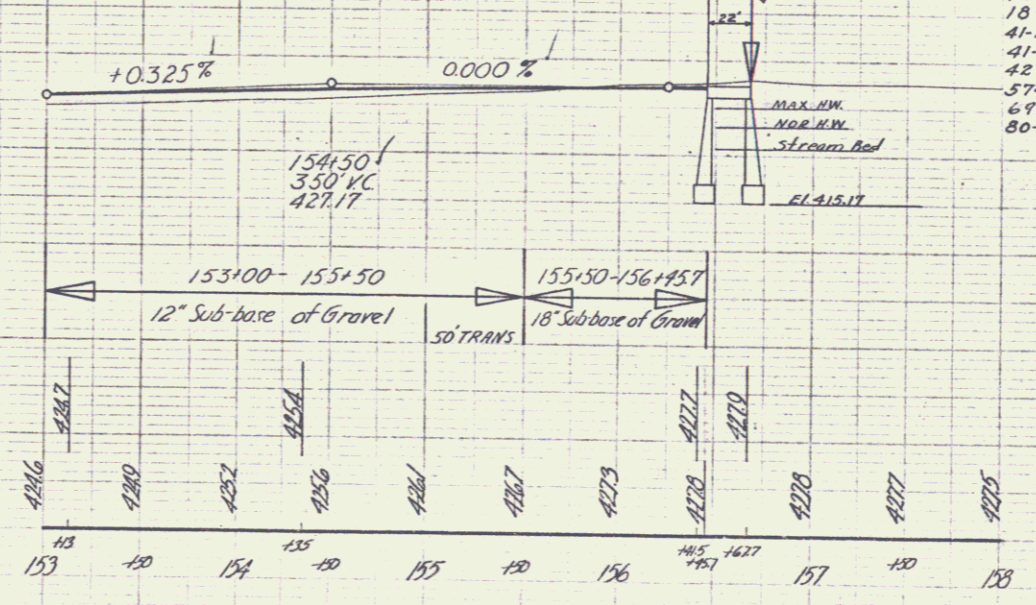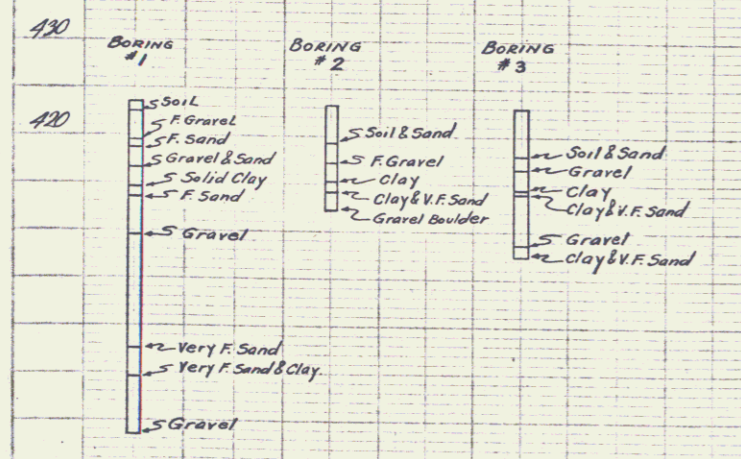

BM #19 Spike in roof 42' Elm 20 Ft. Rt. Sta 153+70 Elev 426.05