


PLAN  
 DATE: \_\_\_\_\_  
 DRAWN BY: \_\_\_\_\_  
 CHECKED BY: \_\_\_\_\_

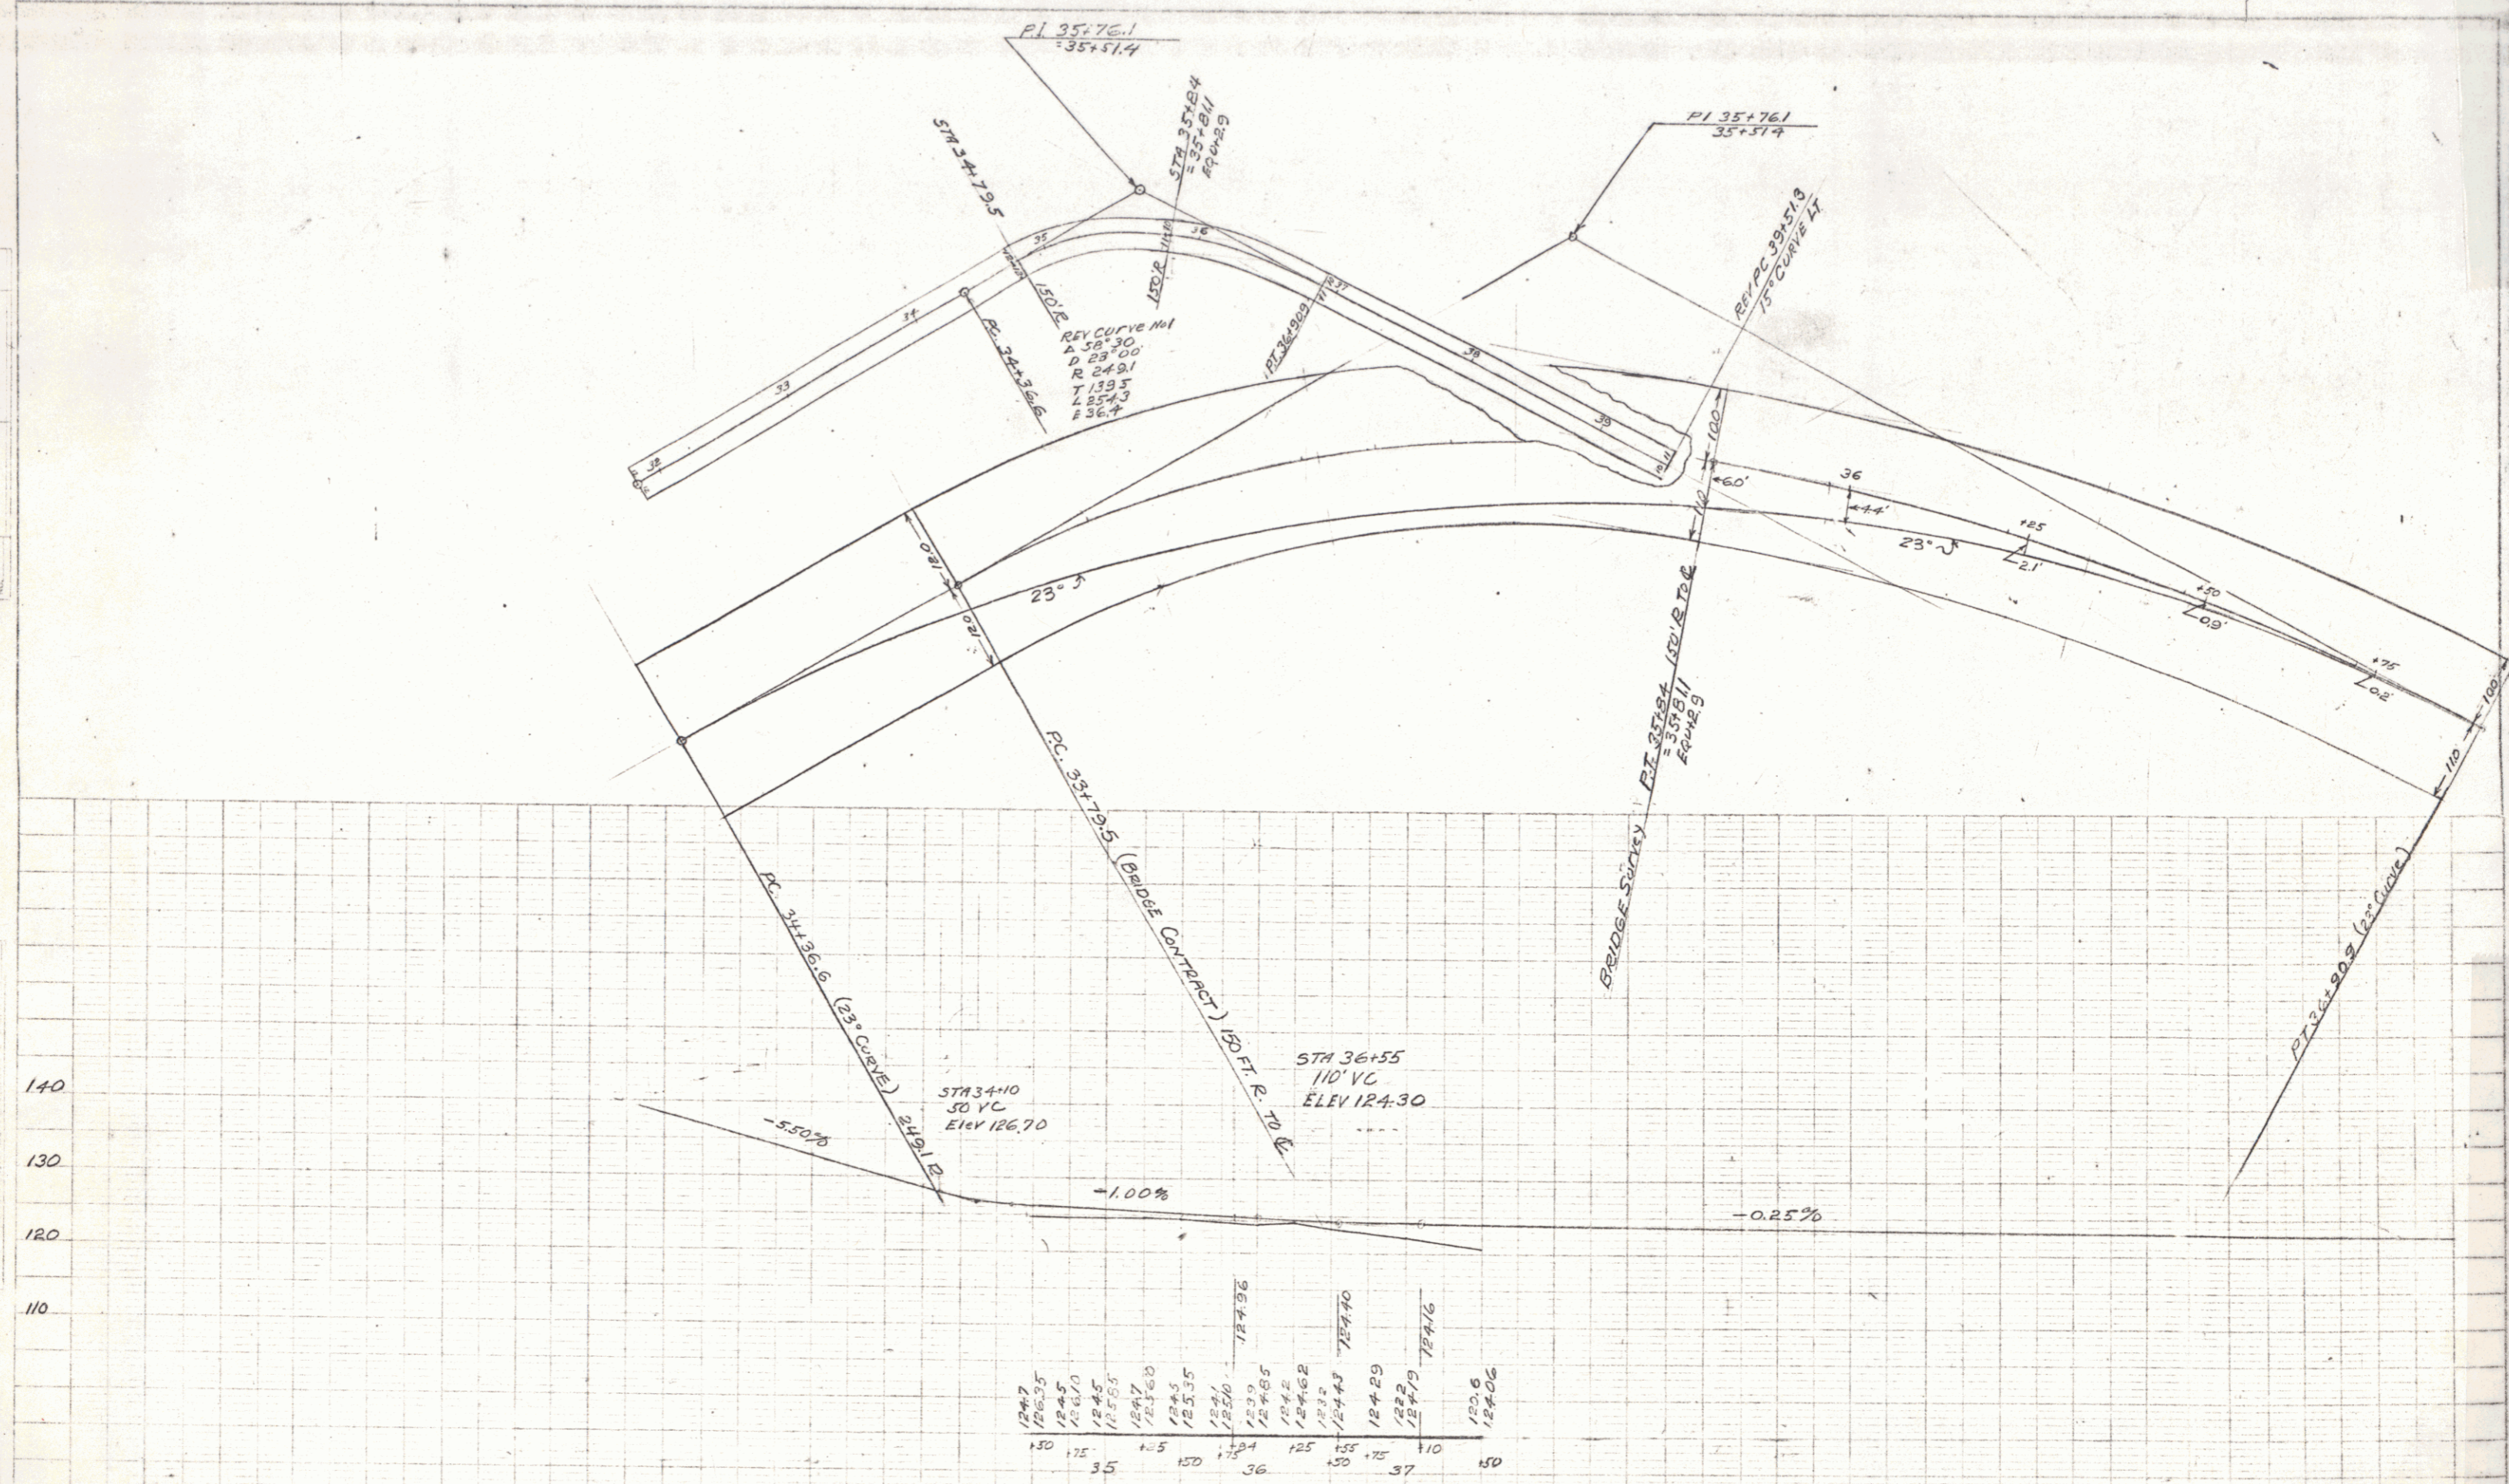

124.7	126.35	128.45	129.60	129.85	129.90	129.85	129.65	129.25	128.75	128.15	127.35	126.35	125.15	123.75	122.15	120.35	118.35
150	175	175	175	175	175	175	175	175	175	175	175	175	175	175	175	175	175
	35	35	35	35	35	35	35	35	35	35	35	35	35	35	35	35	35

TOWN OF ADDISON  
 PROPOSED CHANGE IN LINE  
 JULY 6 1929  
 SHEET 4A

3