
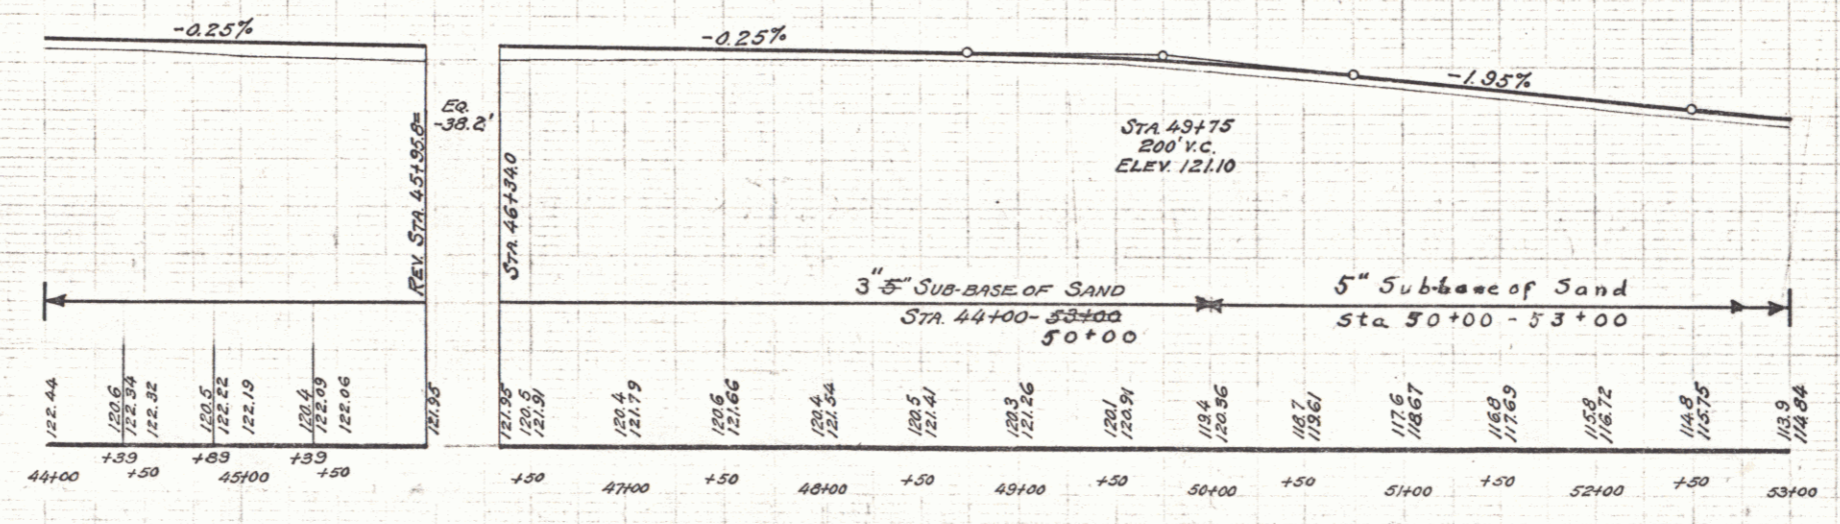


CORRUGATED METAL PIPE (PAVED INVERT)  
 NEW DRIVEWAY PIPE CULVERTS REQUIRED

Station	Left	Right	Diam.	Length	Cem. Rubble Masonry
45+85	Left	18"	24 ft.		
40+10	Left	18"	24 ft.		

FED. ROAD DIST. NO.	STATE	FED. AID PROJ. NO.	FISCAL YEAR	SHEET NO.	TOTAL SHEETS
9	Vt.		1929	5	33

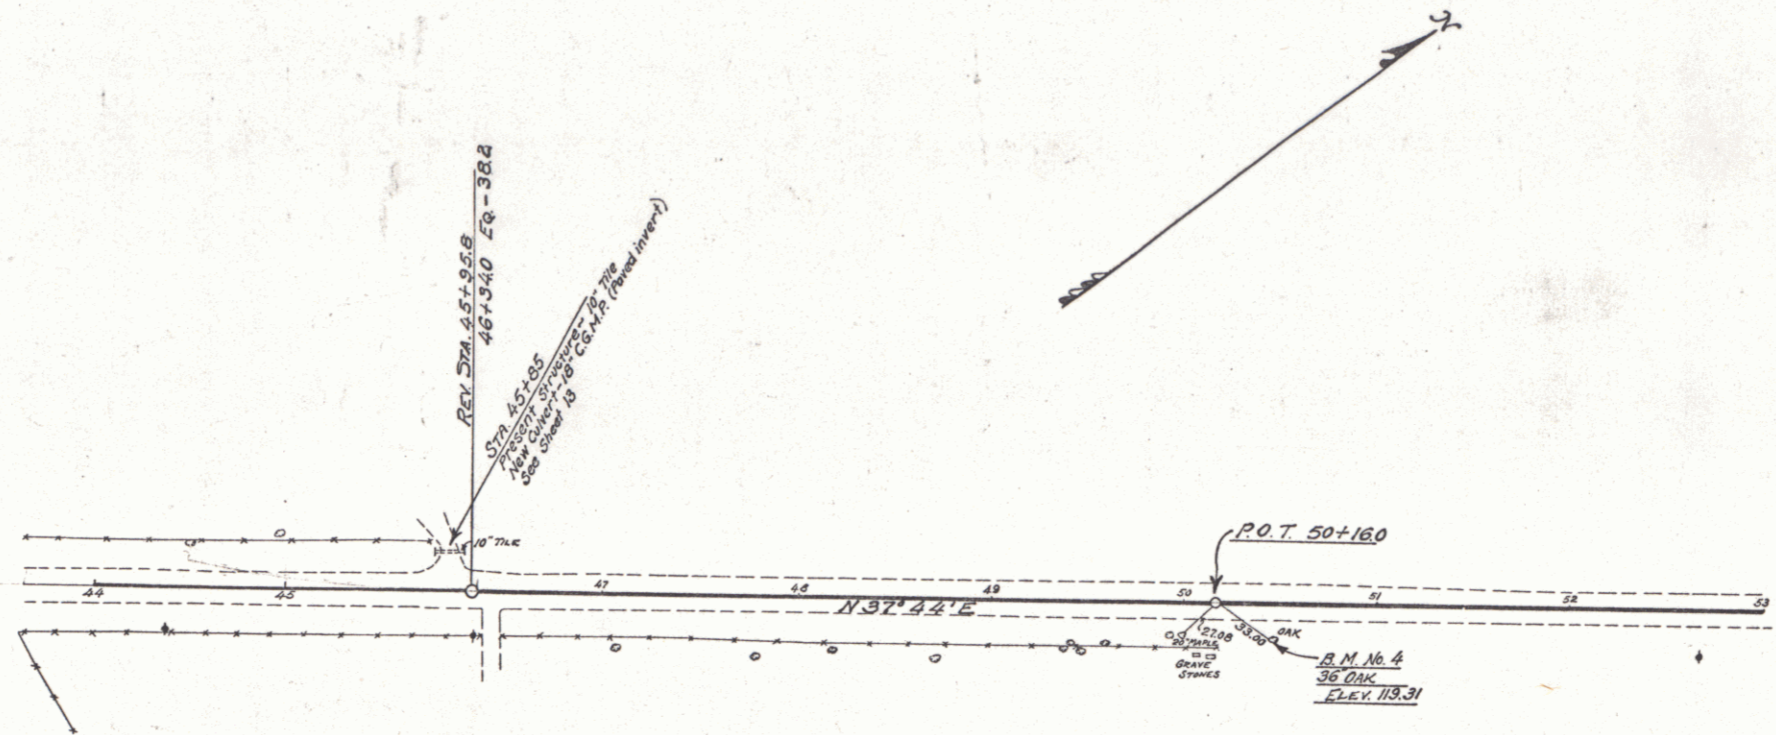

B.M. No. 4 - Spike in 36" Oak, 17 ft. Et of Sta 50+46 - Elev. 119.31