
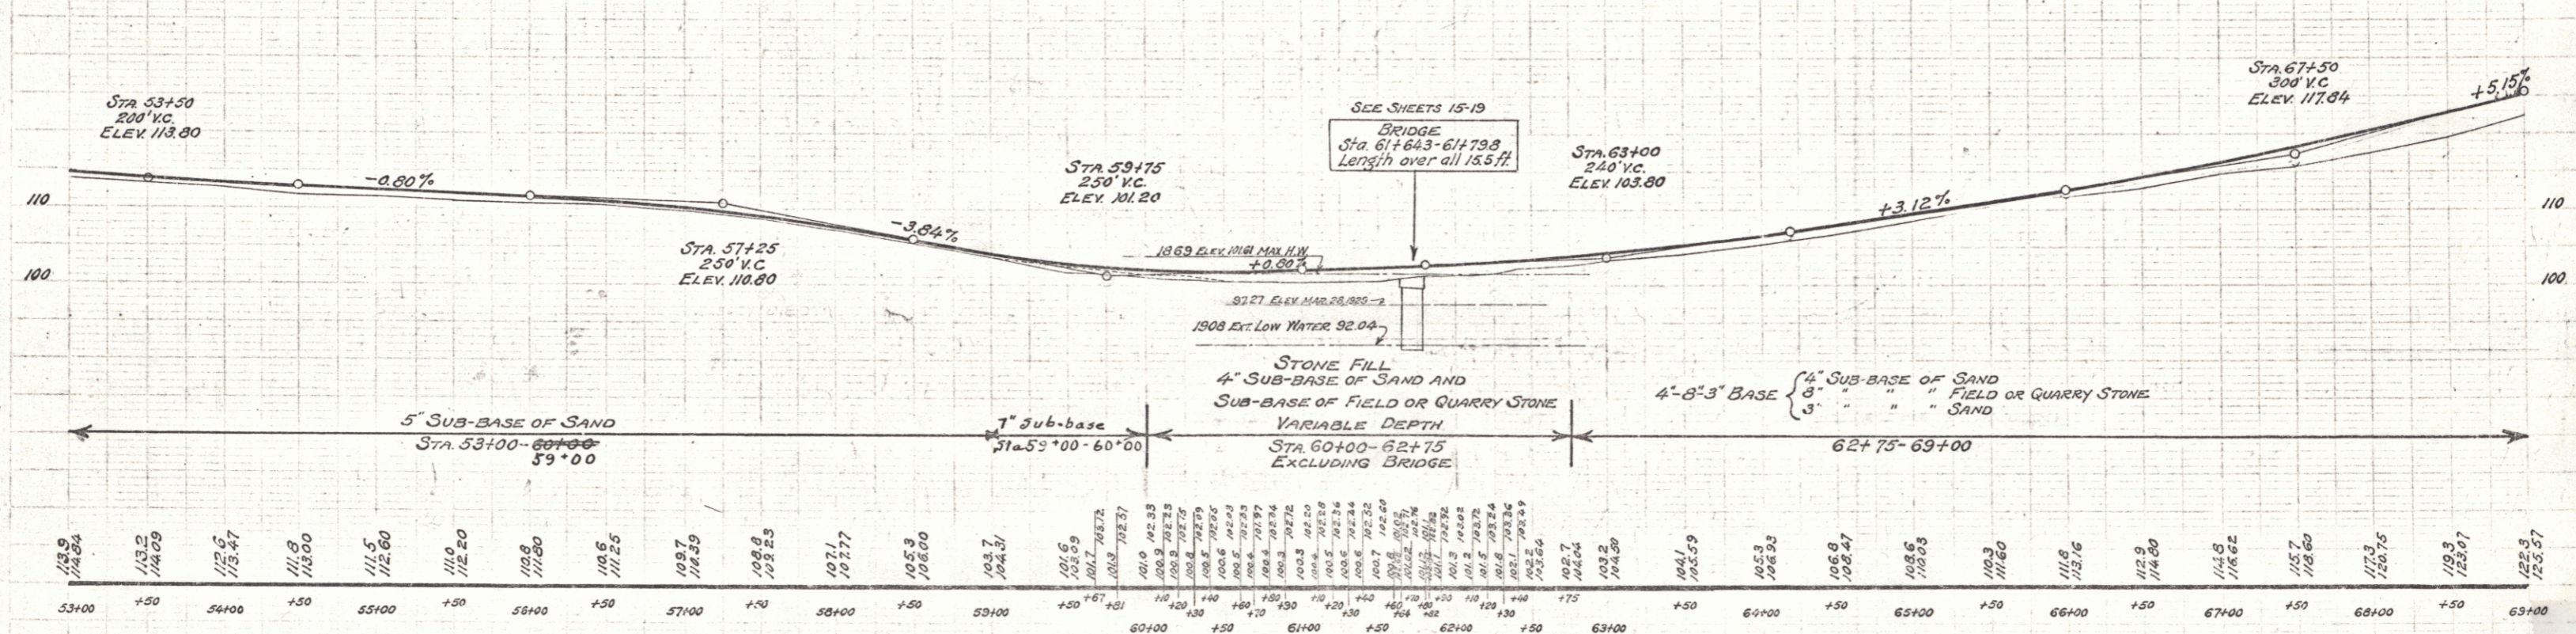


CABLE GUARD RAIL REQUIRED				WOOD GUARD RAIL REQUIRED				NEW REINF CONC PIPE CULVERTS REQUIRED				DEWEWAY PIPES									
Stations	Left	Right		Station	Left	Right		Station	Di.	Len	Conc	B	Steel	Sta	L. or R.	Di.	Len	Con	Rub	Mas.	
59+00-62+44				67+50	24 ft	24 ft		67+50	10	32 ft	3.4	3.4	2.4	59+00	Right	10	24 ft	2.0	2.0	2.0	2.0
60+25-62+41	216 ft	264 ft												60+50	Left	10	24 ft	2.0	2.0	2.0	2.0

FED. ROAD DIST. NO.	STATE	FED. AID PROJ. NO.	FISCAL YEAR	SHEET NO.	TOTAL SHEETS
9	Vt.		1929	6	33

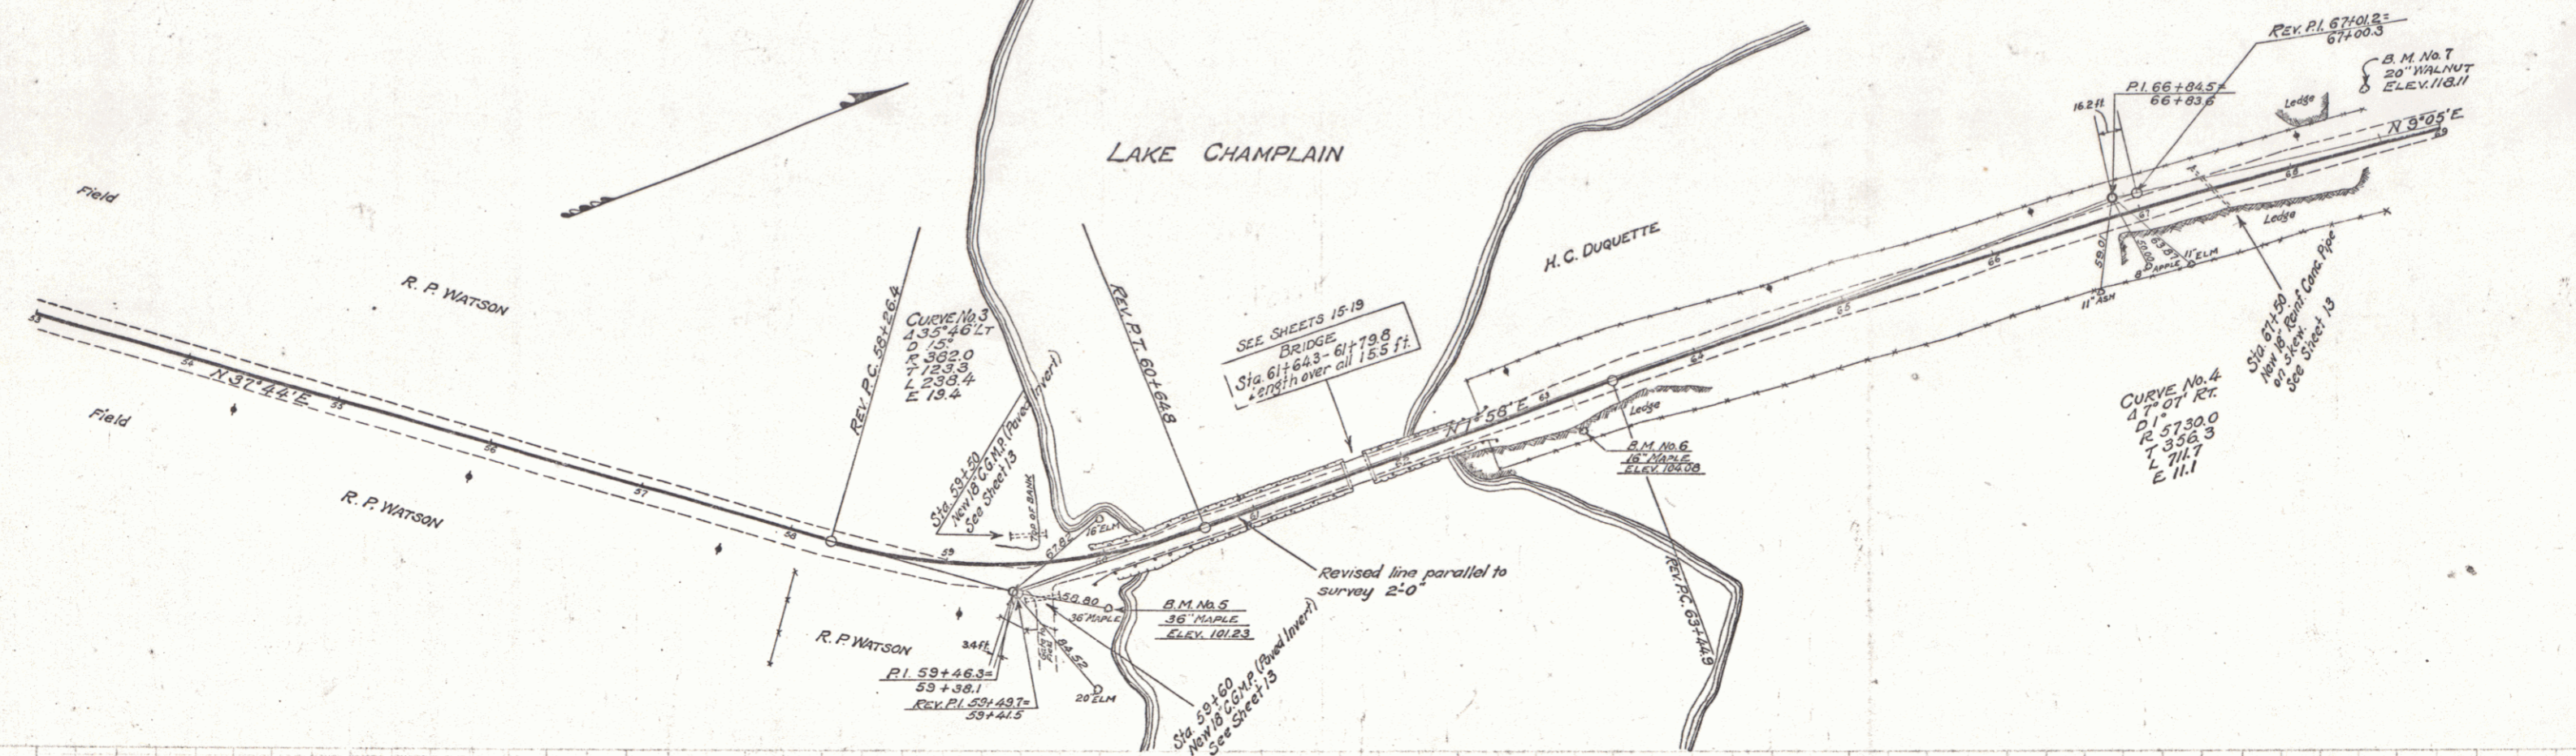

B.M. No. 5 - Spike in 36" Maple, Rt. of Sta. 59+90 - Elev. 101.23
 B.M. No. 6 - Spike in 16" Maple, Rt. of Sta. 63+10 - Elev. 104.08
 B.M. No. 7 - Spike in 20" Walnut, Lt. of Sta. 68+59 - Elev. 113.11

TOWN OF ADDISON
 LAKE CHAMPLAIN BRIDGE APPROACH ROAD
 SHEET 6 OF 33