

WOOD GUARD RAIL REQUIRED
 Station Left Right
 105+78 24.71 28.71



NEW REIN. CONC. PIPE CULVERTS REQUIRED
 Station Diam. Length Conc. B Steel
 105+78 18" 32.71 2.7 c.y. 2.4"

CORROD. GALV. METAL PIPE (PAVED INVERT)
 NEW DRIVEWAY PIPE CULVERTS REQUIRED
 WITH PAVED INVERT
 Sta. Left Right Diam. Length Cam. Rubble Mos.
 106+20 Left 18" 24.71 2.1 c.y.
 112+00 Left 18" 24.71 no hdr.

FED. ROAD DIST. NO.	STATE	FED. AID PROJ. NO.	FISCAL YEAR	SHEET NO.	TOTAL SHEETS
9	VT.		1929	9	33

PLAN
 SURVEYED BY
 PLANNED BY
 CHECKED BY
 DATE
 NO.

PROFILE
 SURVEYED BY
 PLANNED BY
 CHECKED BY
 DATE
 NO.

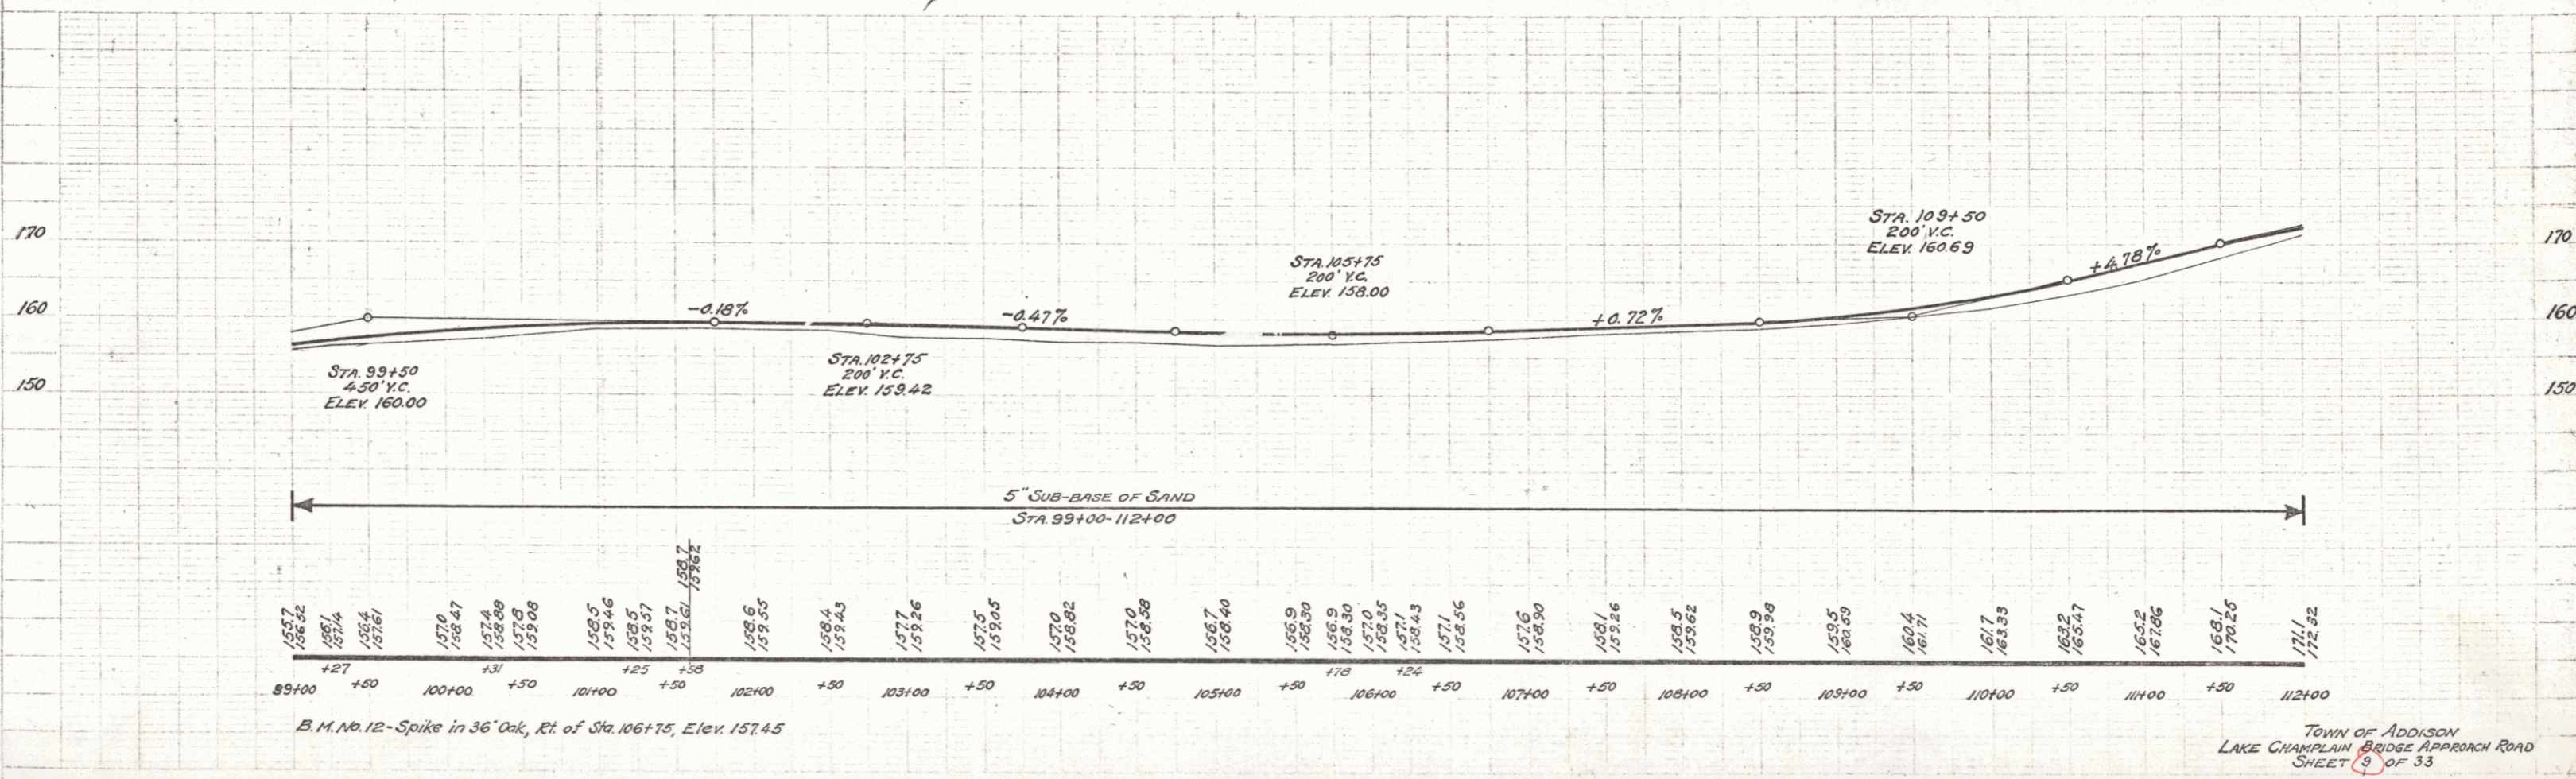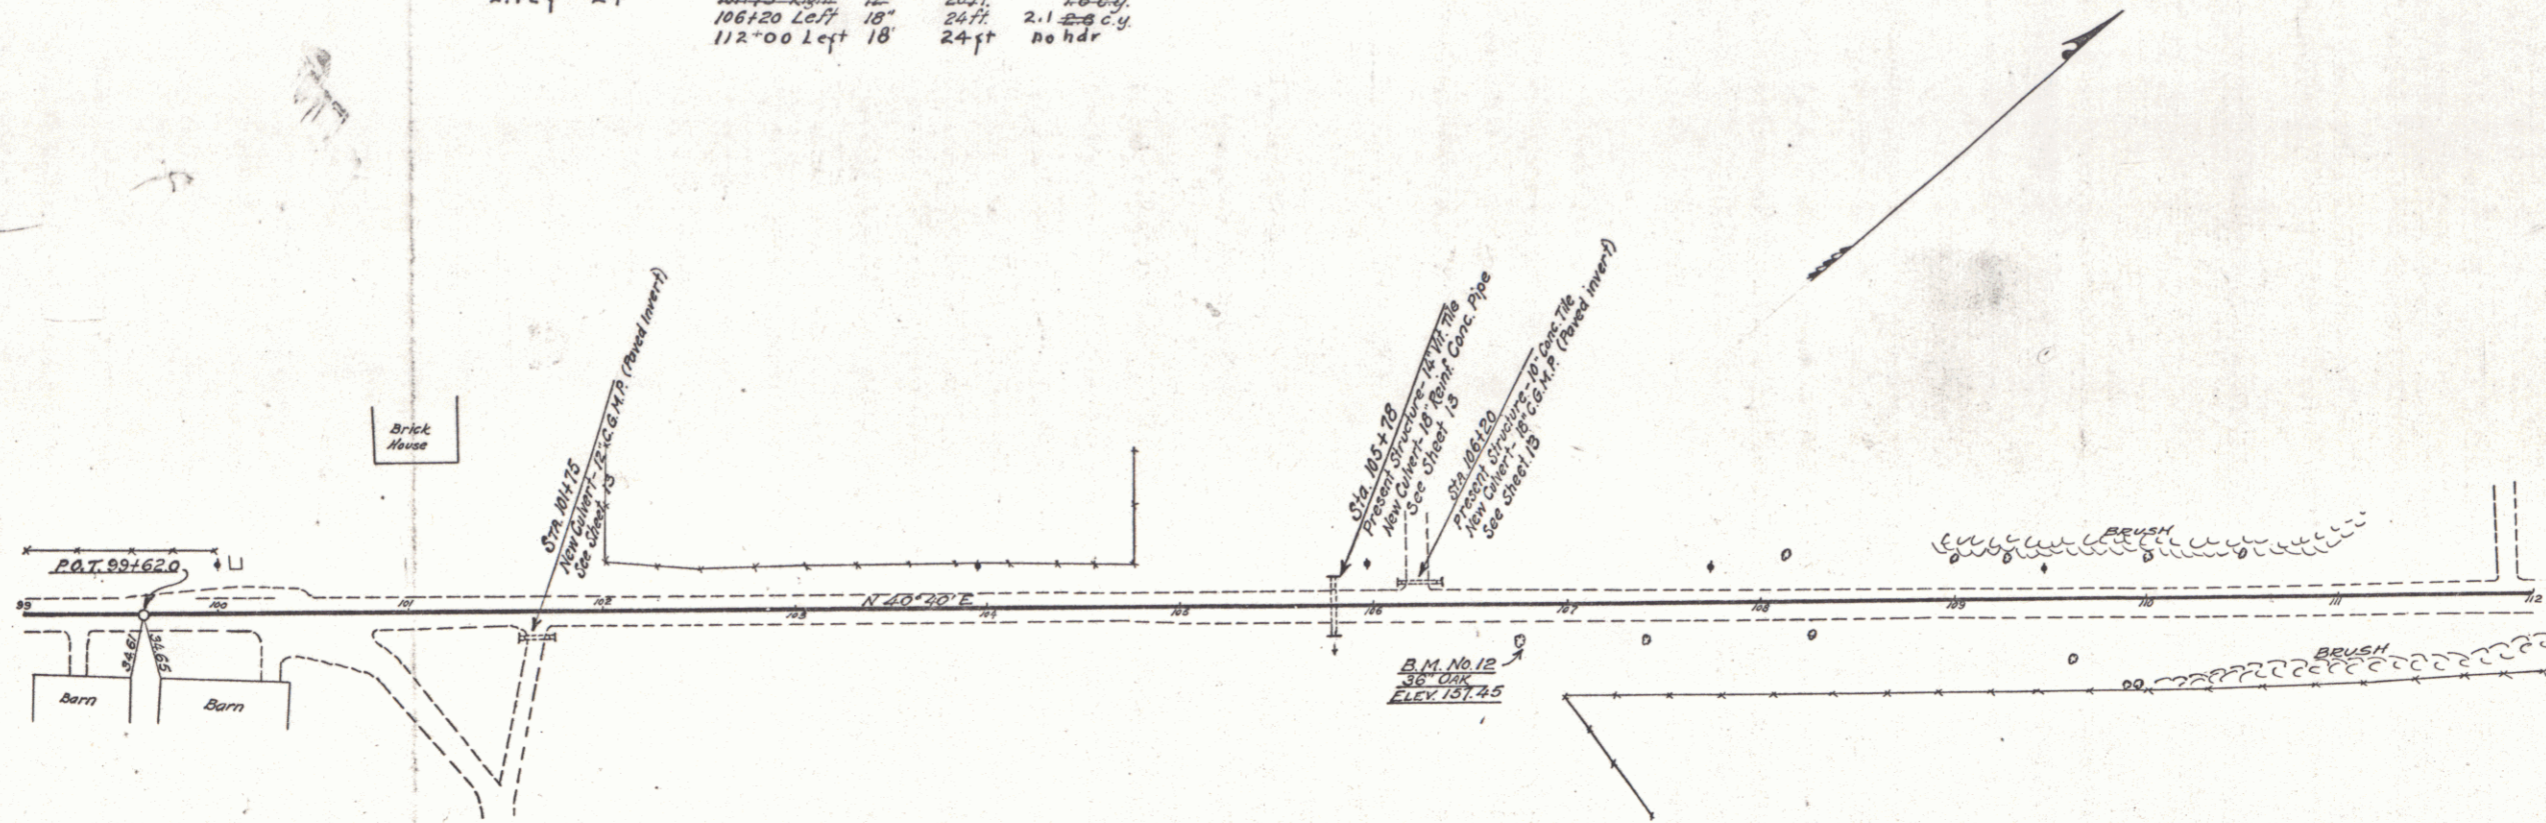

B.M. No. 12-Spike in 36" Oak, Rt. of Sta. 106+75, Elev. 157.45

TOWN OF ADDISON
 LAKE CHAMPLAIN BRIDGE APPROACH ROAD
 SHEET 9 OF 33