
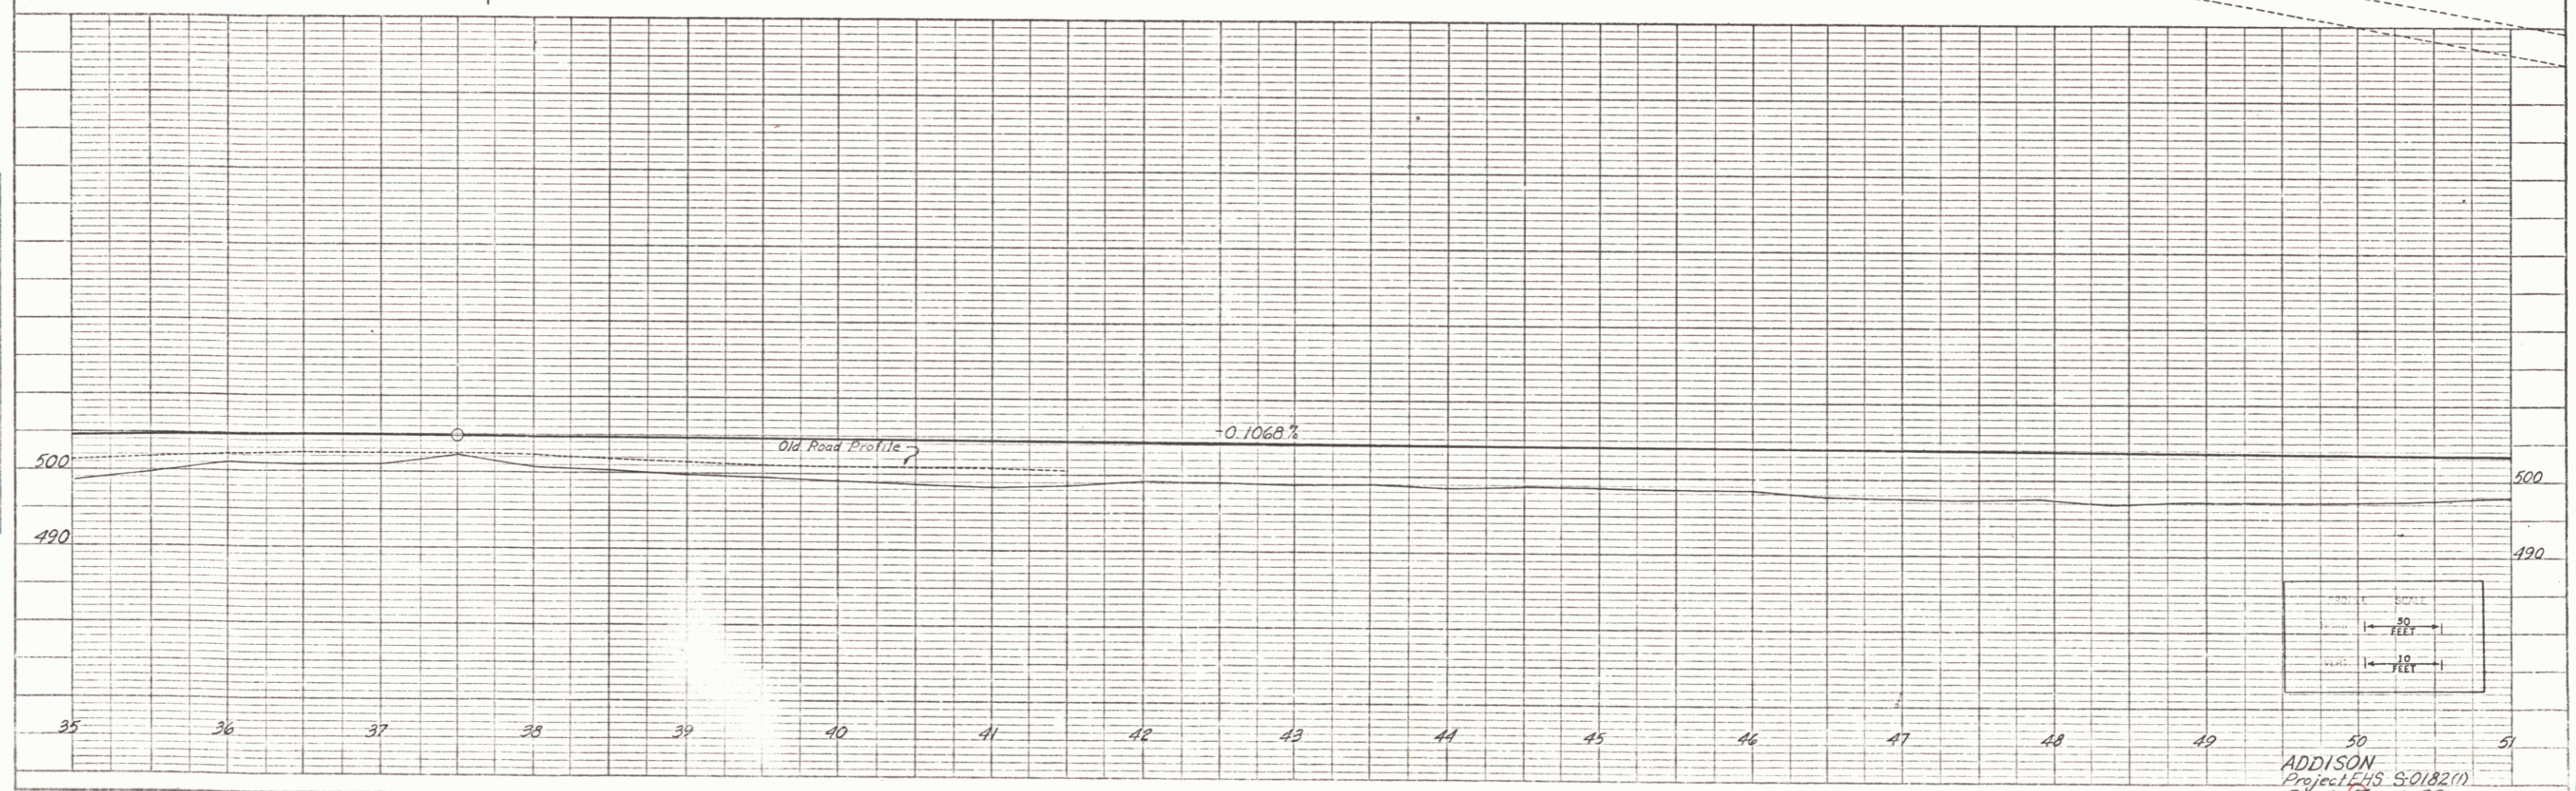


PLAN
 DRAWN BY: F. Angier
 CHECKED BY: A. Crayton
 DATE: Mar 27
 NO. 1

PROFILE
 DRAWN BY: F. Angier
 CHECKED BY: A. Crayton
 DATE: Mar 27
 NO. 1

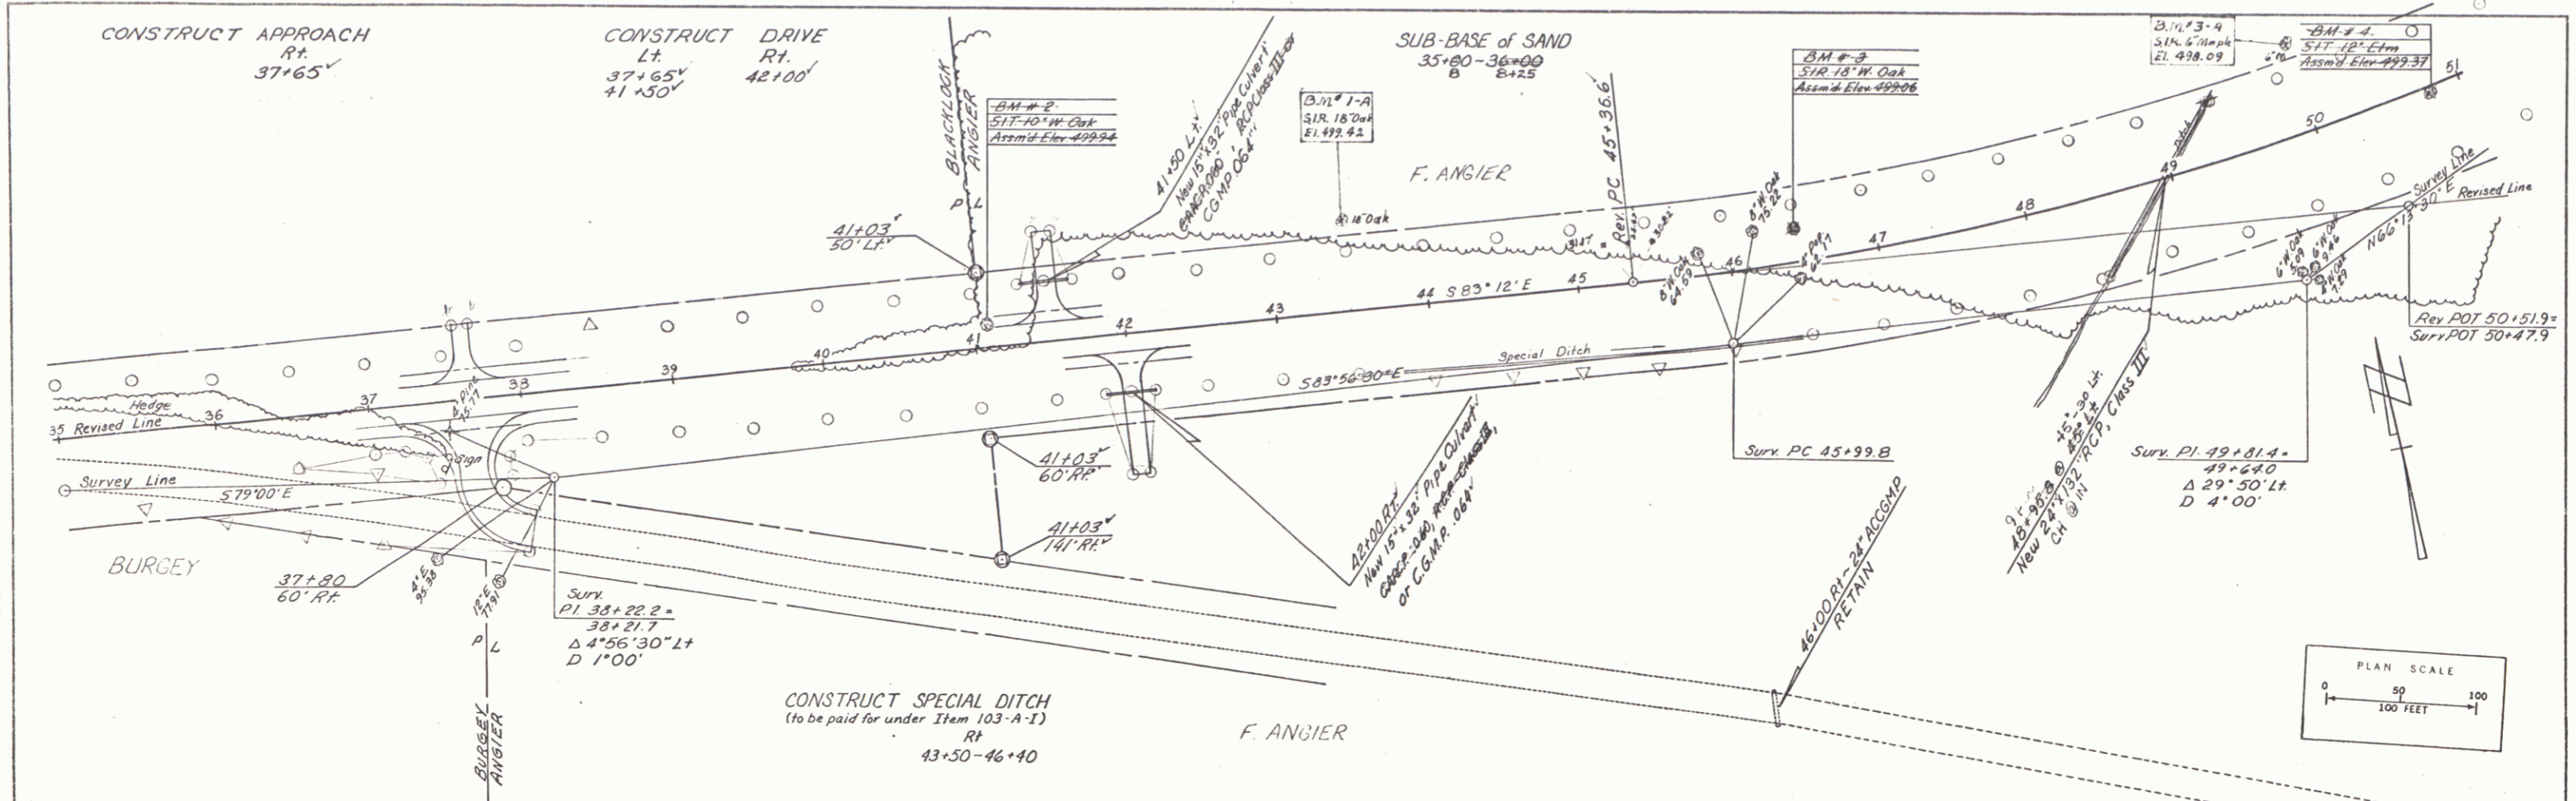

ADDISON
 Project 248 S-0182(1)
 Sheet 2 of 22